




1 KITCHEN
3/8"=1'-0"

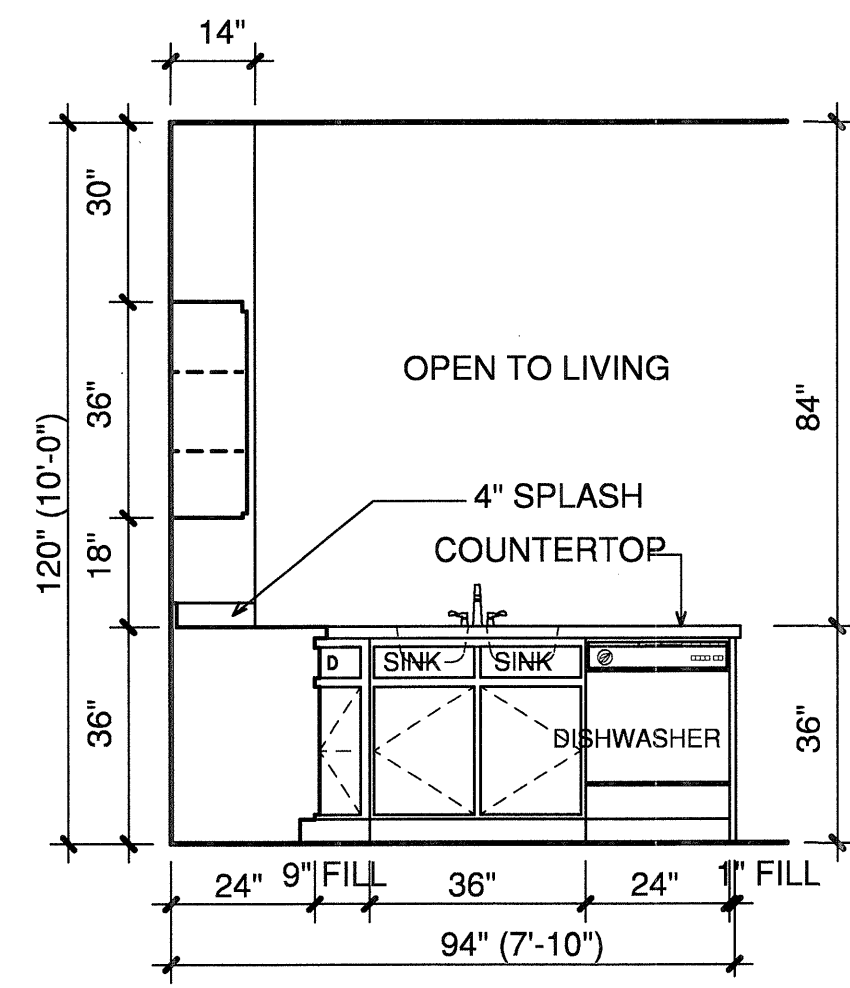


2 KITCHEN
3/8"=1'-0"

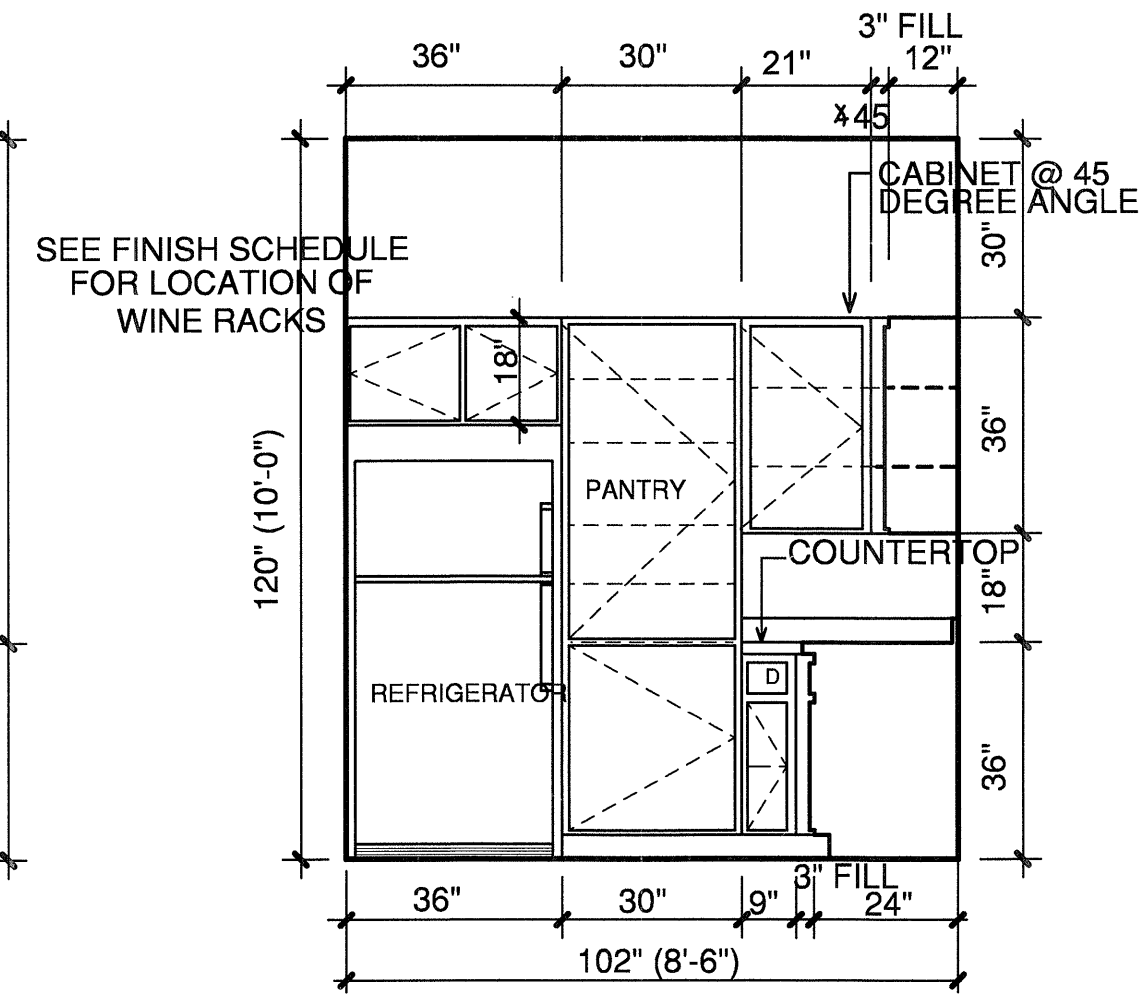


3 KITCHEN
3/8"=1'-0"

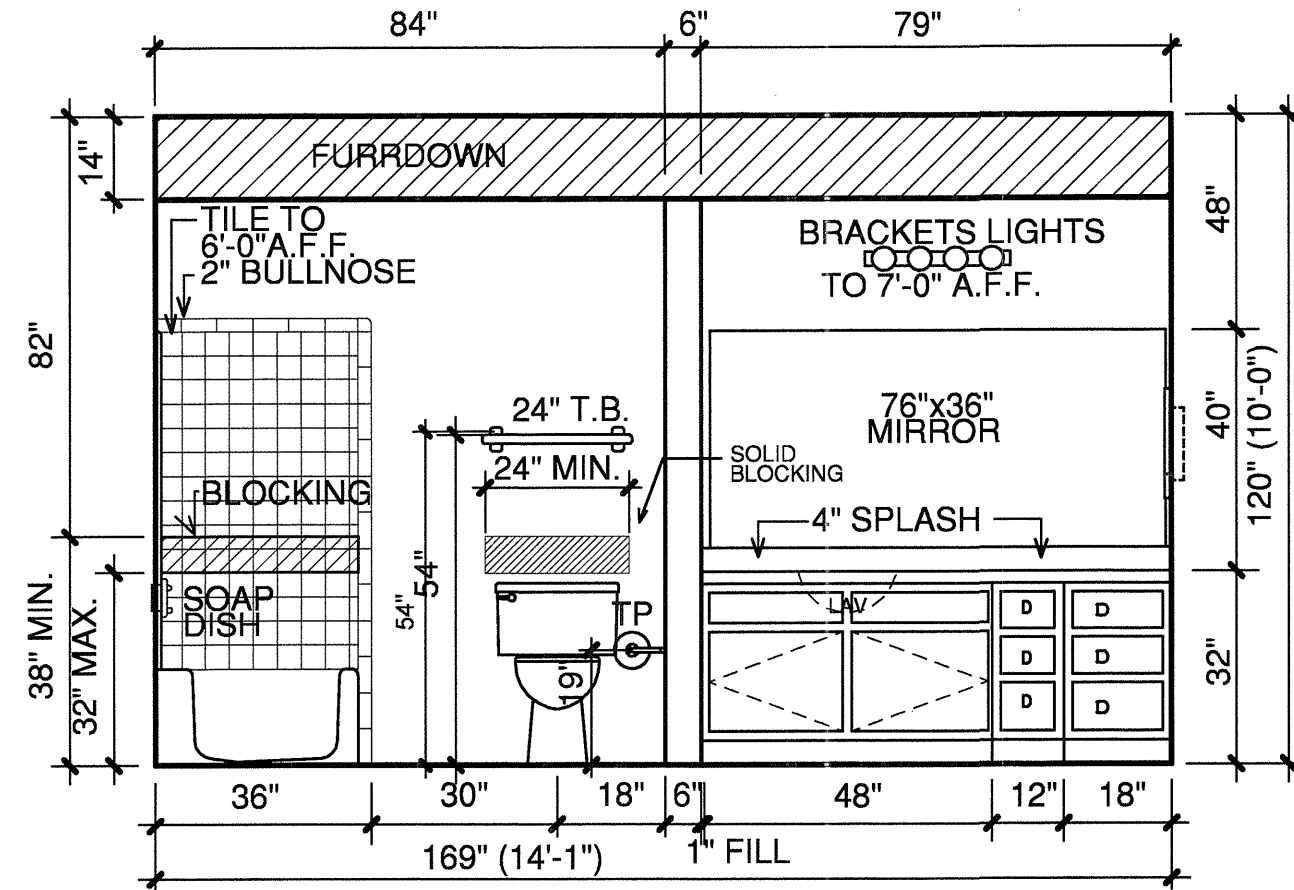


4 BATH
3/8"=1'-0"

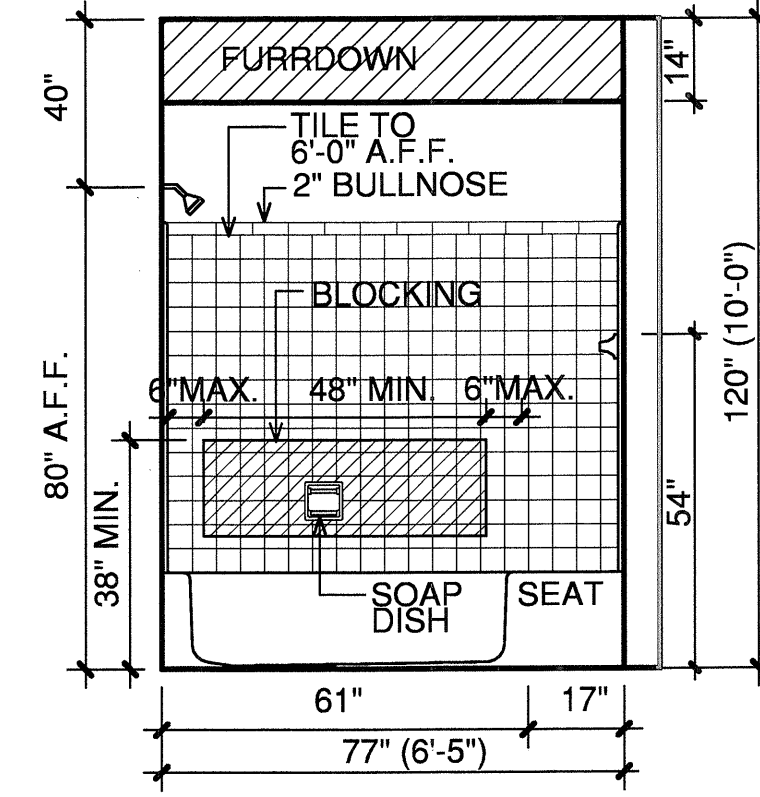


5 BATH
3/8"=1'-0"

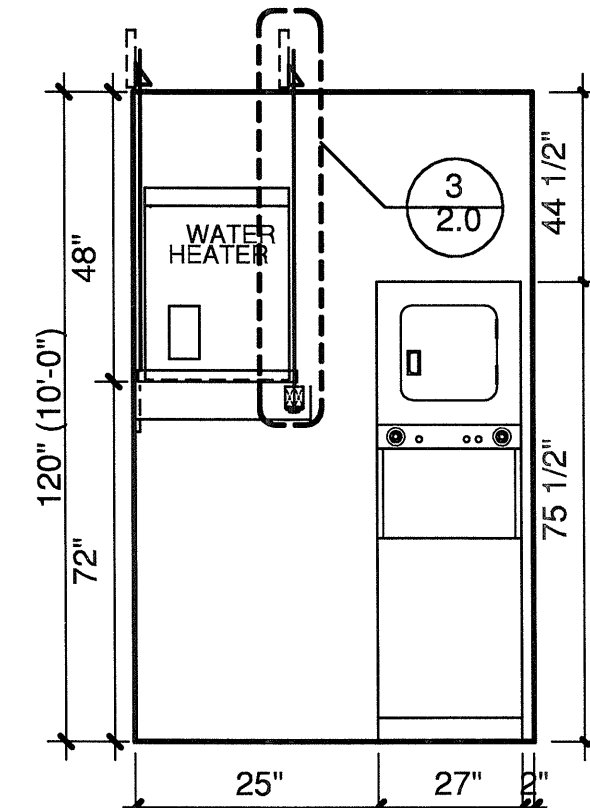


6 UTILITY
3/8"=1'-0"

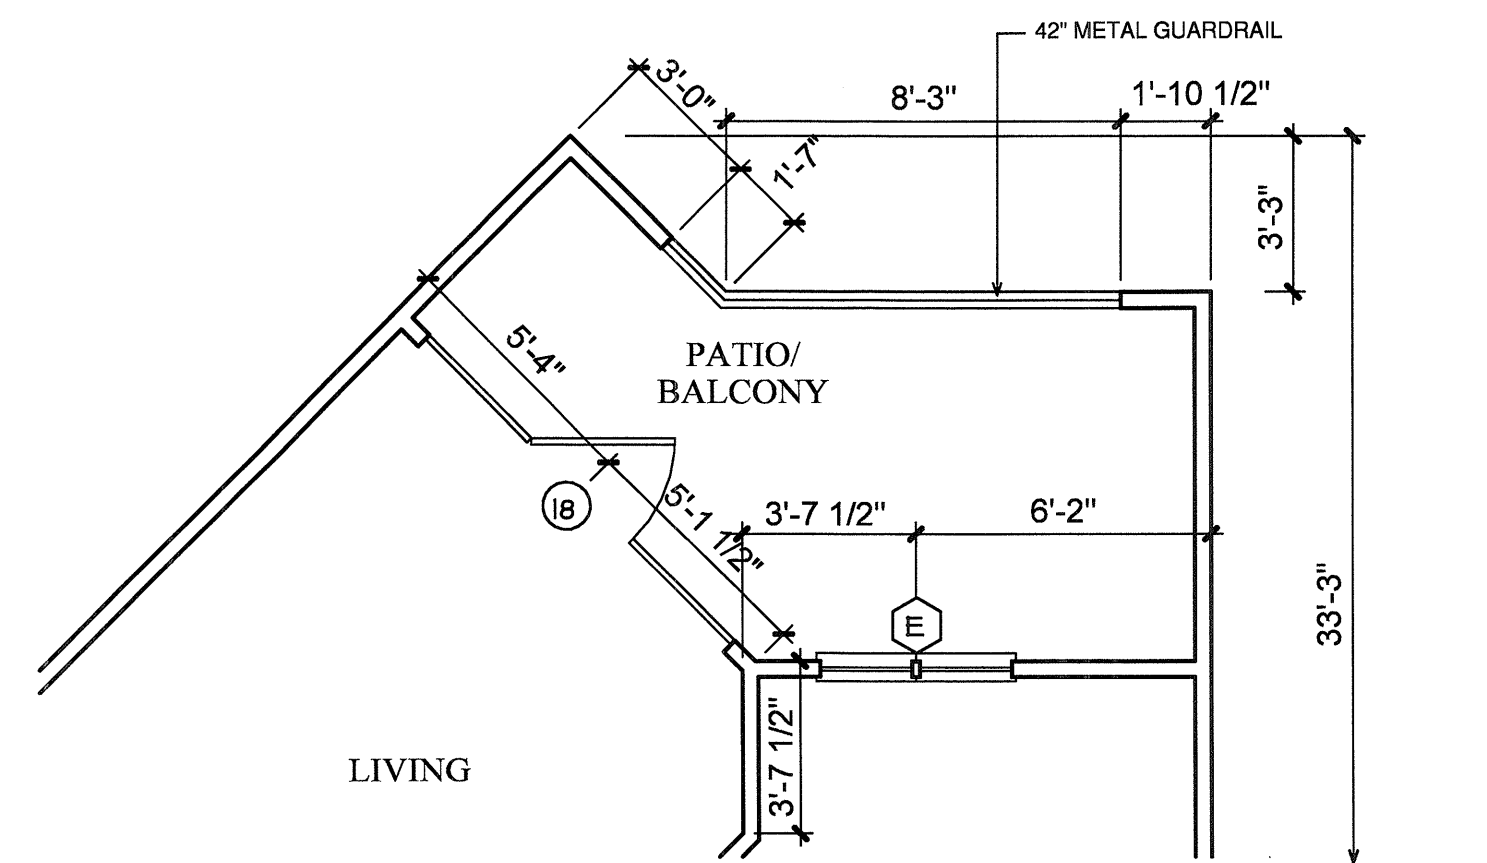

8 PART 2
SCALE 1/4"=1'-0" 788 S.F.
(3) TOTAL UNITS ON SITE

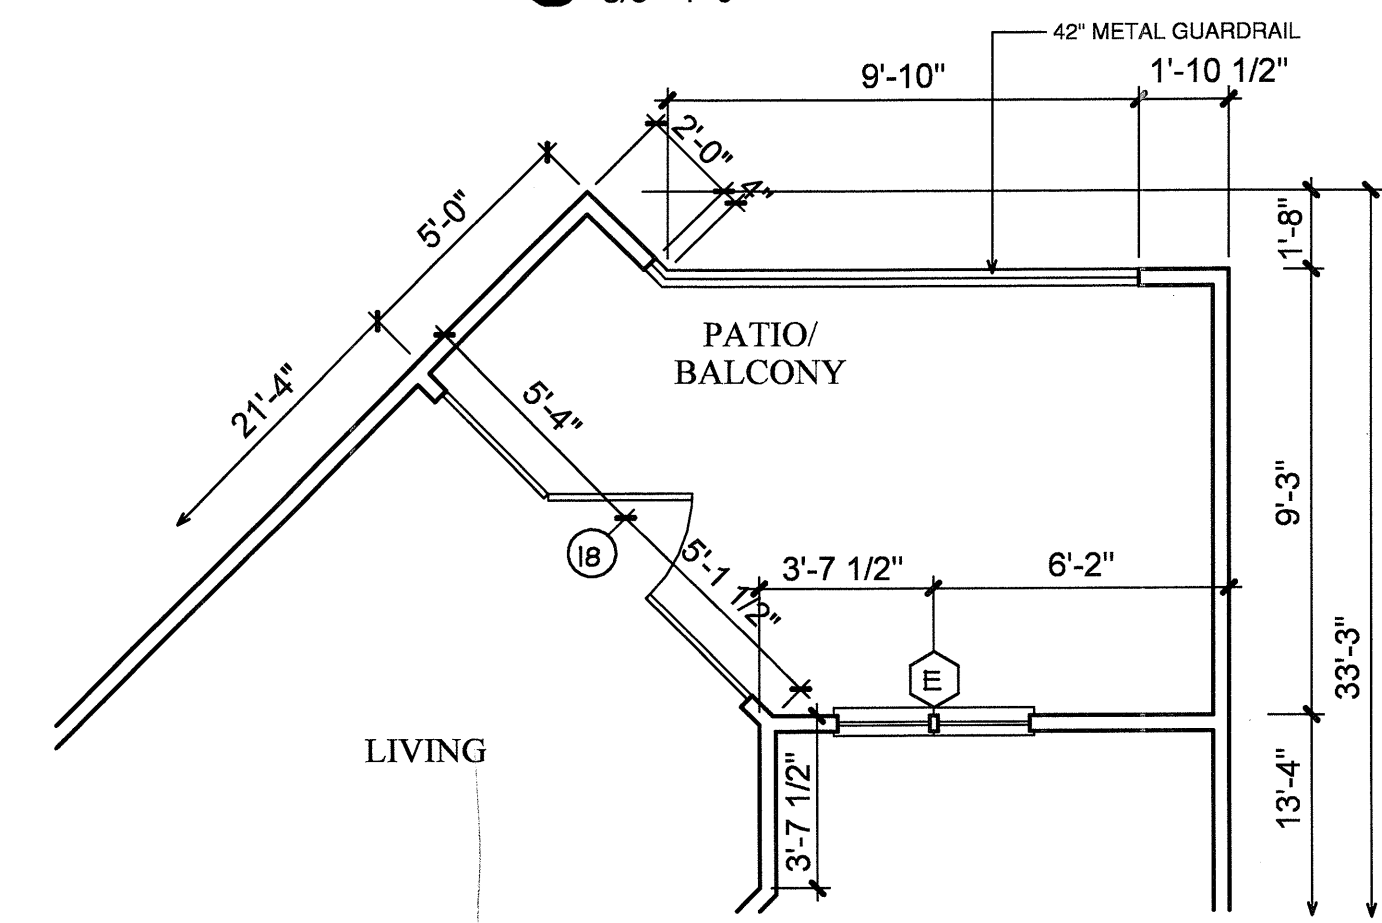

7 PART 1
SCALE 1/4"=1'-0" 788 S.F.
OCCURS AT: (3) TOTAL UNITS ON SITE

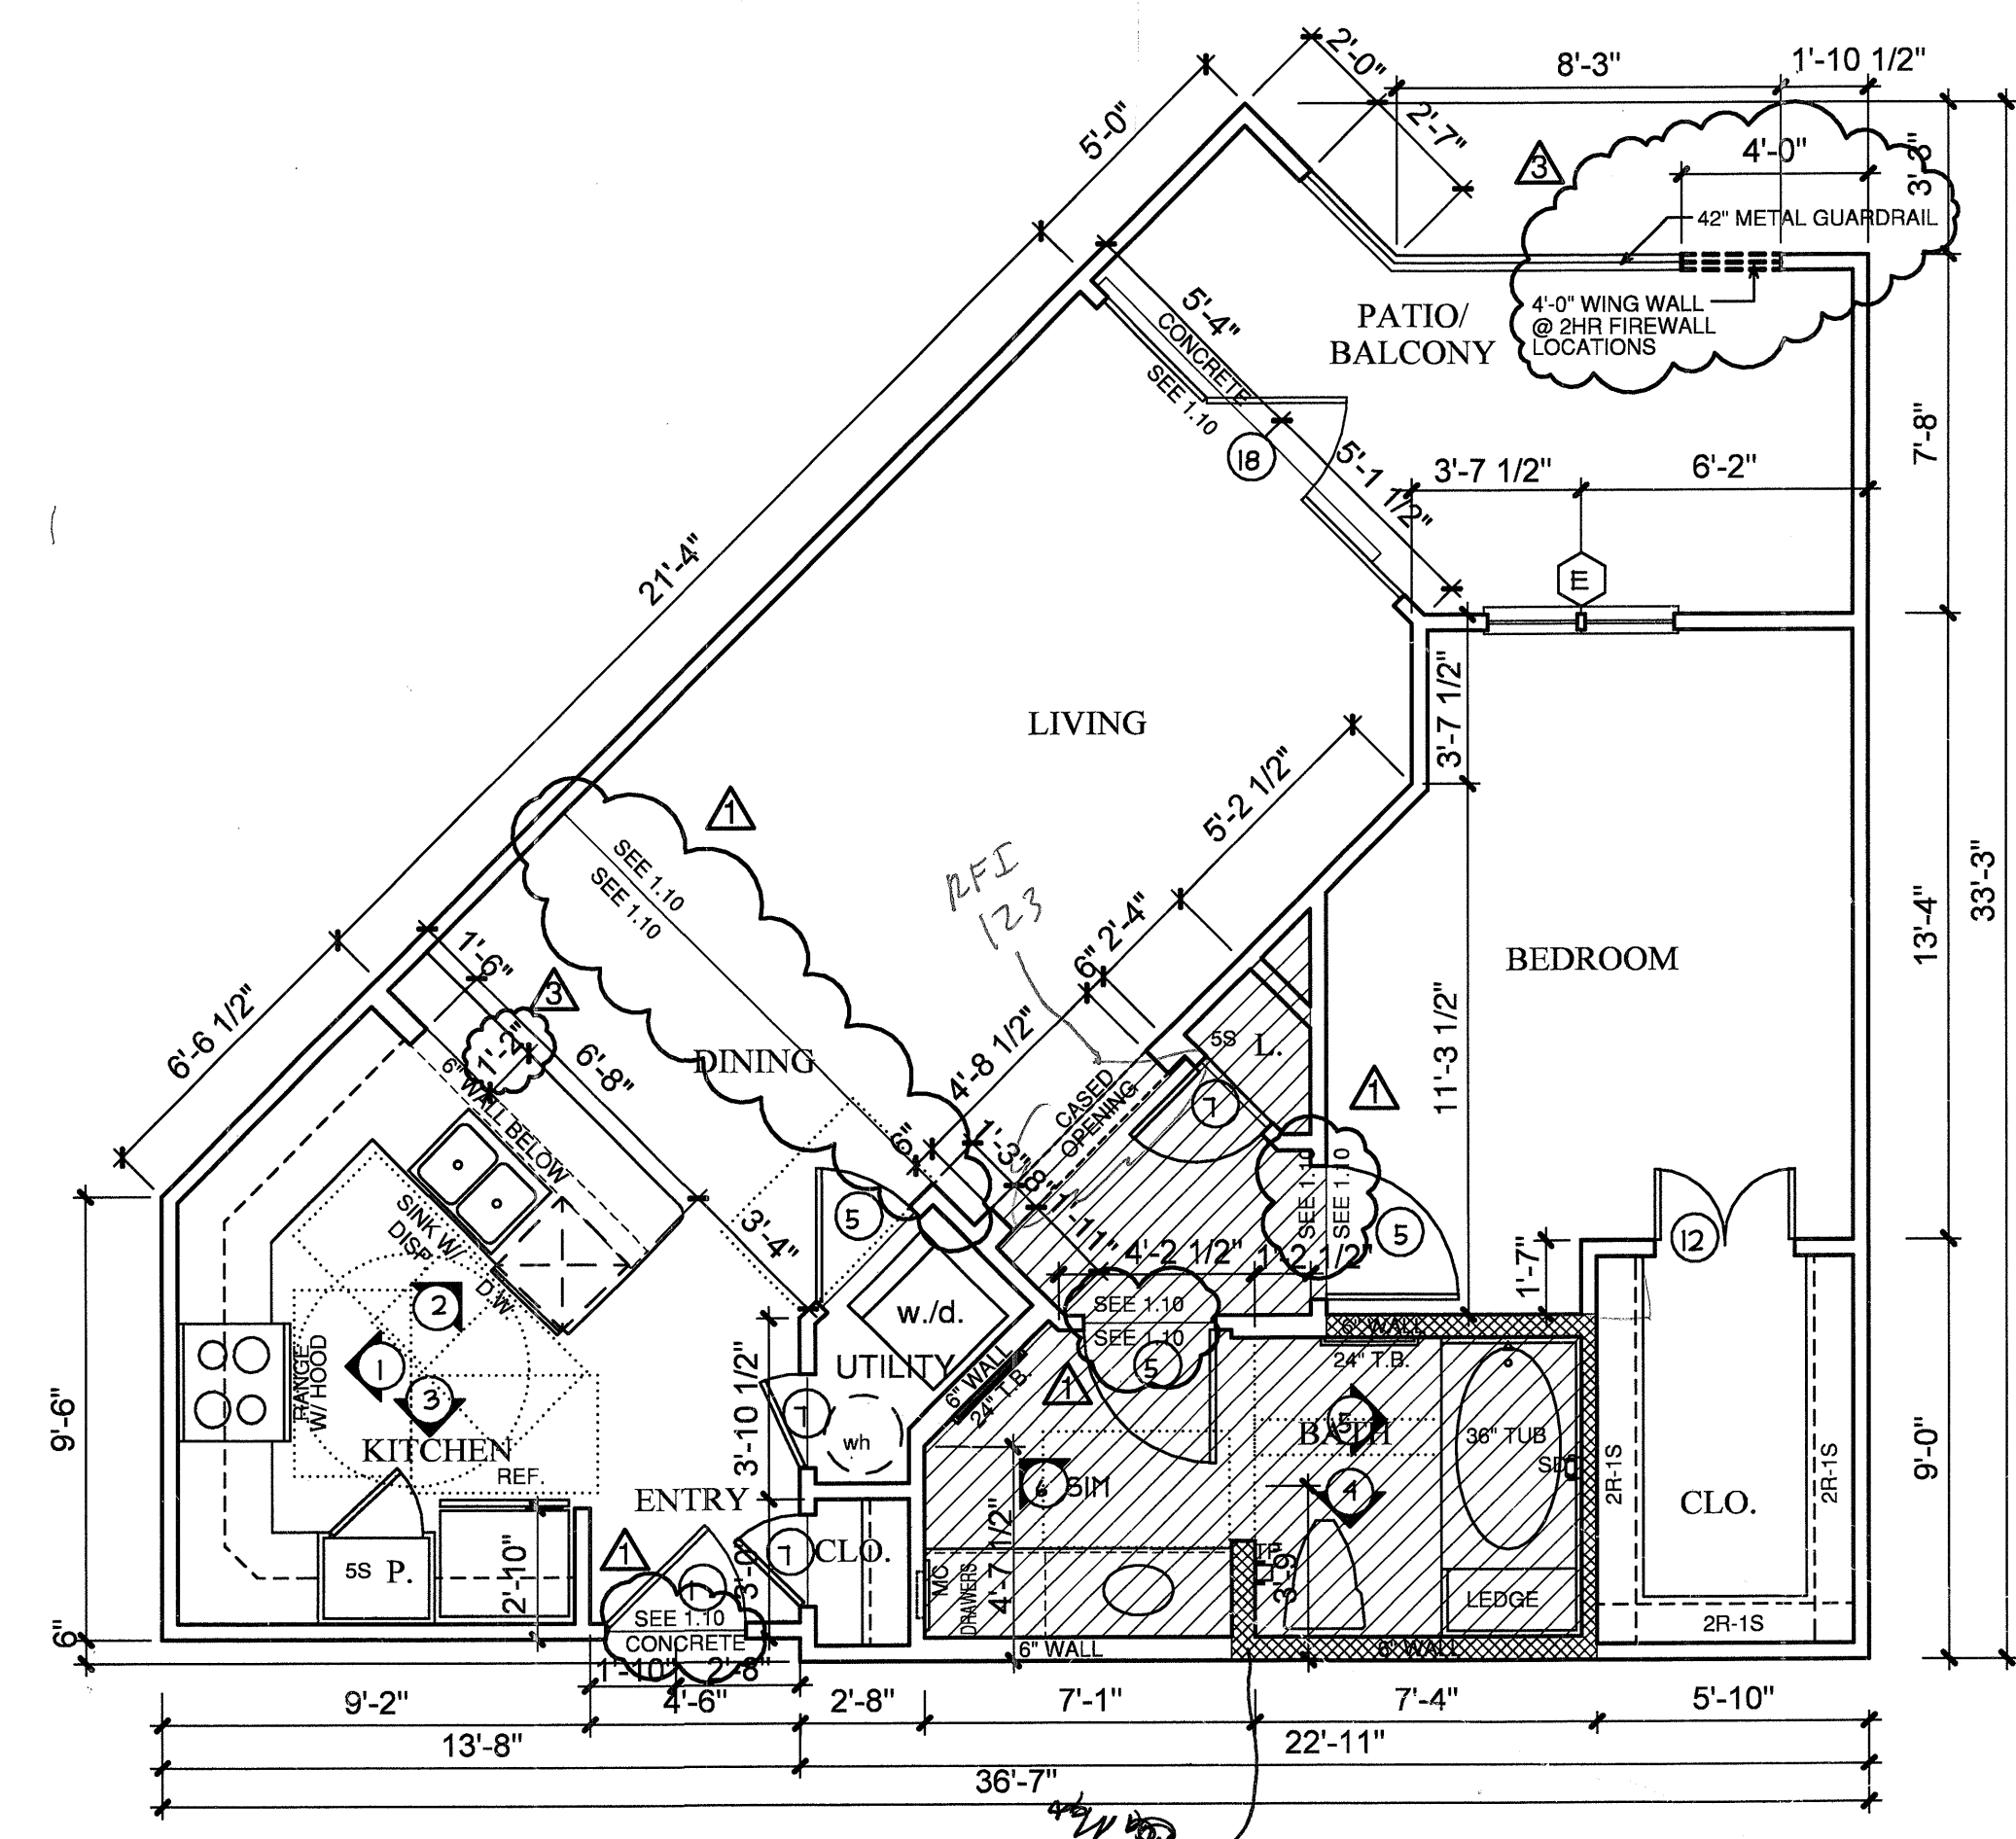

A2 ONE BEDROOM/ONE BATH
SCALE 1/4"=1'-0" 789 S.F.
OCCURS AT: (59) UNITS
(65) TOTAL UNITS ON SITE

NOTES:
CEILING HEIGHTS ARE 9'-0"
ON THE 2ND, 3RD, AND 4TH FLOORS.
REFERENCE SHEET 31 FOR VARYING
CEILING HEIGHTS AT FIRST FLOOR.

NOTES:
CROSSHATCHING
ON PLAN INDICATES
AREAS TO BE
SUFFICIENTLY BLOCKED
FOR GRAB BARS.
4" FURFDOWN
30" x 48"
CLEAR
FLOOR
SPACE
COORDINATE ALL
FURFDOWN LOCATIONS
WITH MECHANICAL
SHOP DRAWINGS



10-17-2011

REVISIONS
OWNER COORDINATION
09-01-2011
COORDINATION
10-17-2011

KELLER SPRINGS LOFTS
LOFT APARTMENTS IN ADDISON, TEXAS

CONSTRUCTION ISSUE
10-17-2011

BGO architects
4144 N. Central Expy.
Suite 855
Dallas, TX 75204
214.520.8878
bgoarchitects.com

DATE
08-05-2011

PROJECT
11129

SHEET NUMBER

2.3
A2 UNIT

COPYRIGHT © Beelr, Guest, Owens Architects ALL RIGHTS RESERVED