


Platform for Water Heater Lobby

EMBREY STANDARD DETAIL
5/29/12

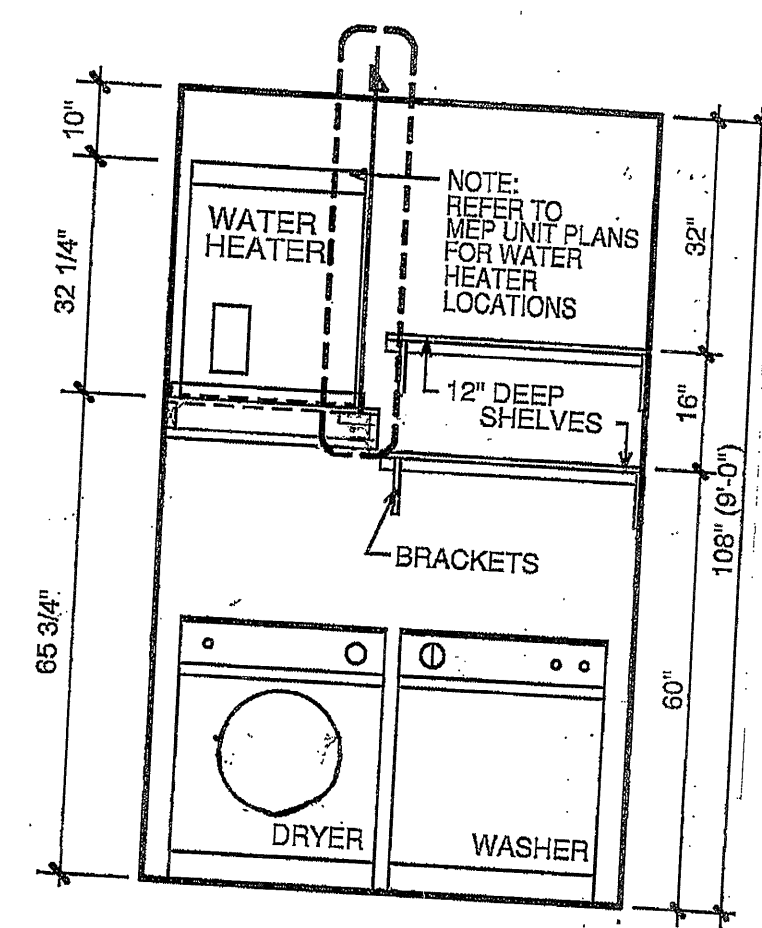

**SUSPENDED
WATER HEATER SHELF**

