

REVISIONS

OWNER COORDINATION
09-01-2011

COORDINATION
10-17-2011

KELLER SPRINGS LOFTS

LOFT APARTMENTS IN ADDISON, TEXAS

CONSTRUCTION ISSUE
10-17-2011

BGO
architects

4144 N. Central Expy.
Suite 855
Dallas, TX 75204
214.520.8878
bgoarchitects.com

DATE
08-05-2011


PROJECT
11129

SHEET NUMBER


2.4

A3 UNIT


COPYRIGHT © Beiter Guest Owners Architects All Rights Reserved

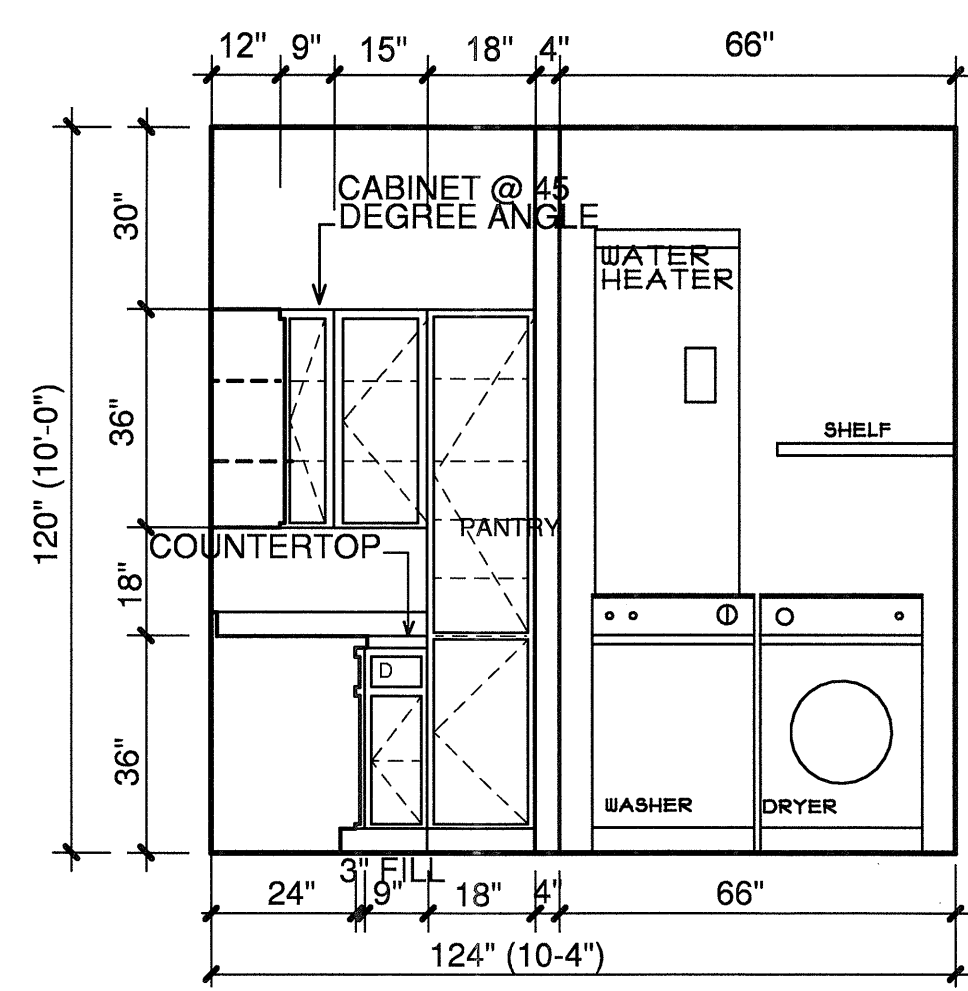


1 KITCHEN
3/8"=1'-0"

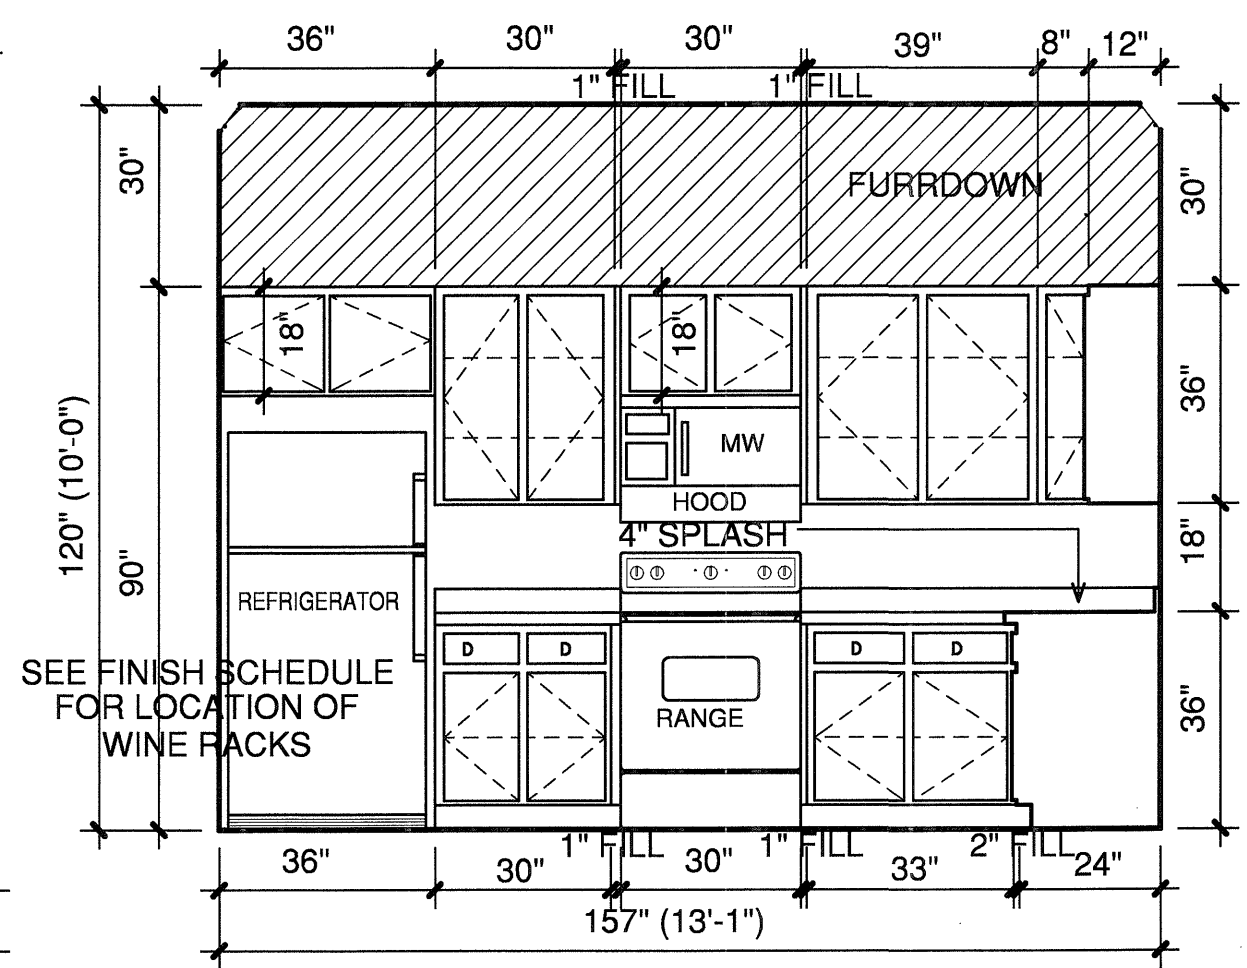


2 KITCHEN
3/8"=1'-0"

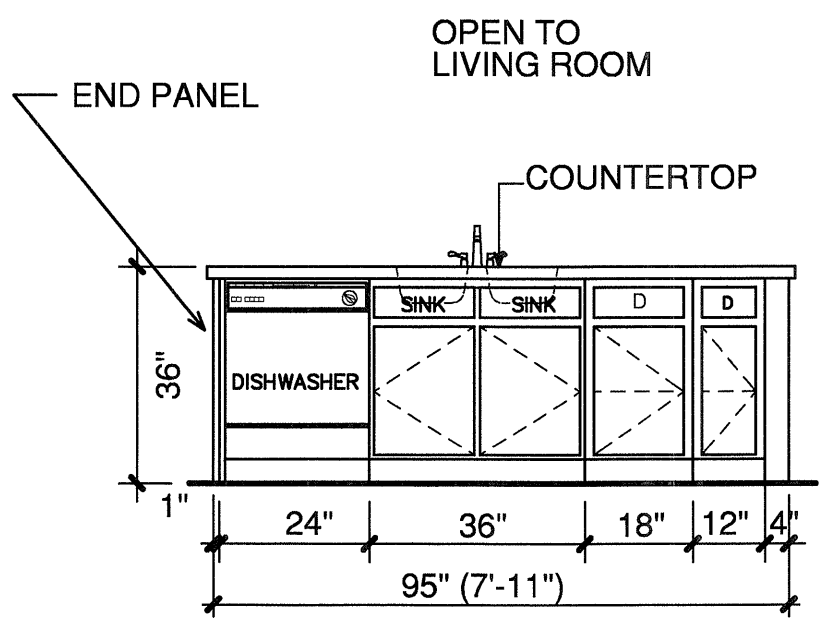


3 KITCHEN
3/8"=1'-0"

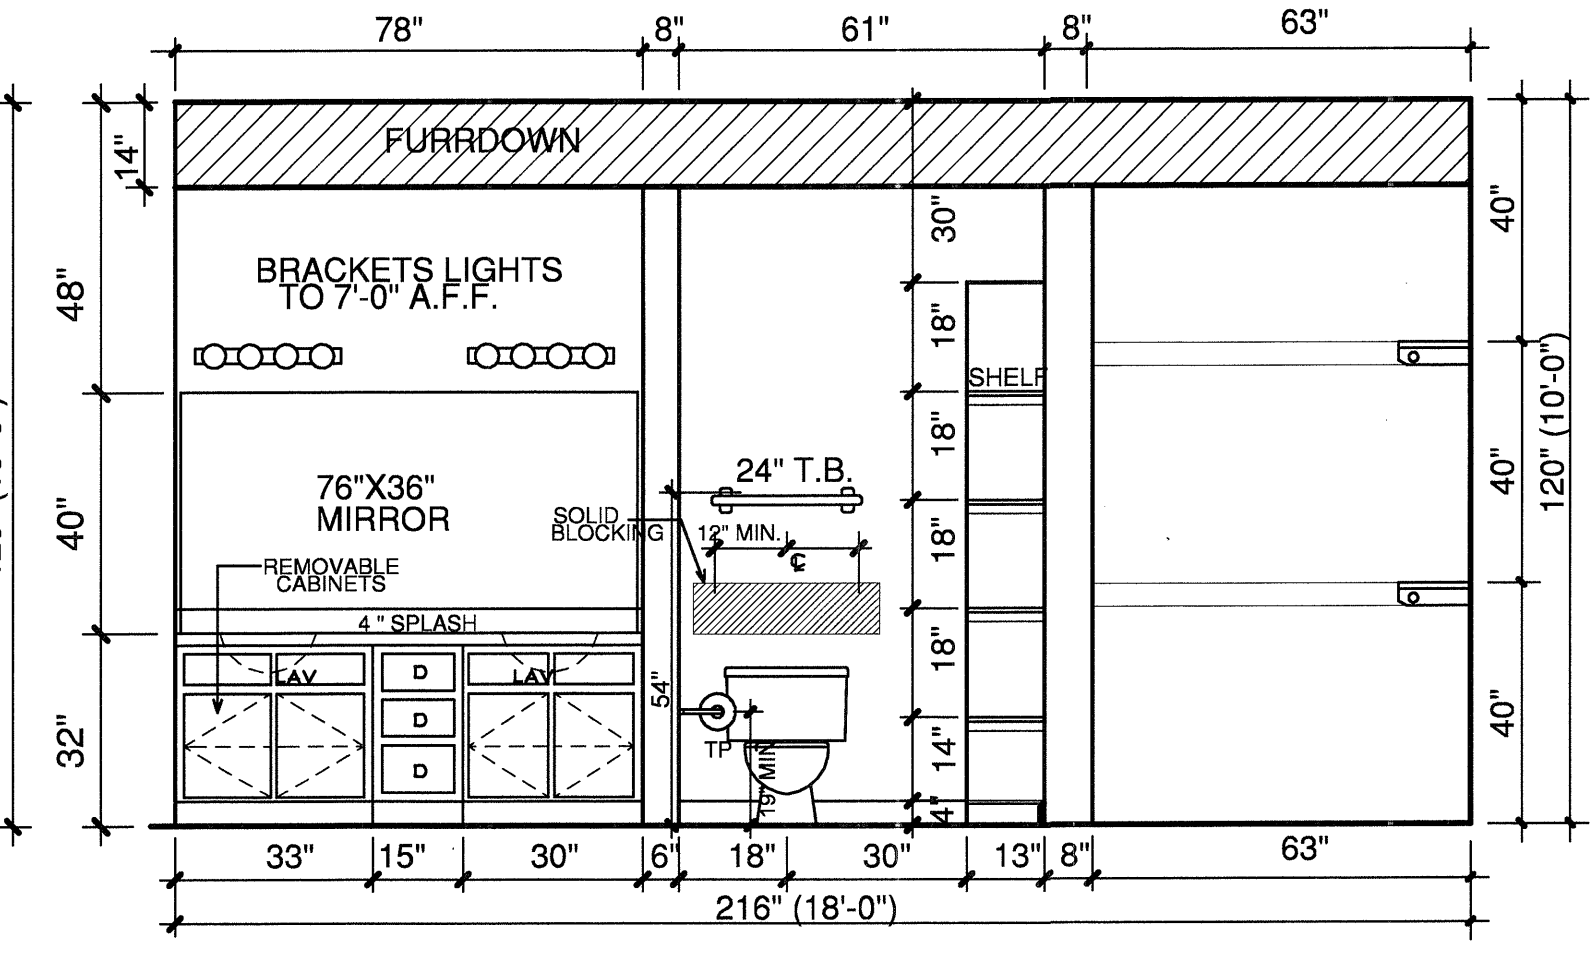


4 BATH
3/8"=1'-0"

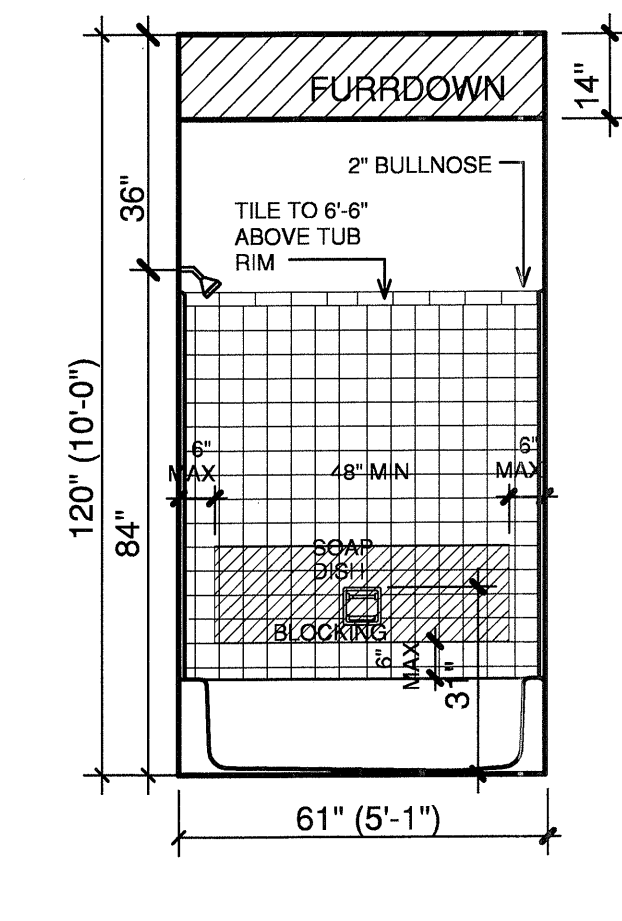


5 BATH
3/8"=1'-0"

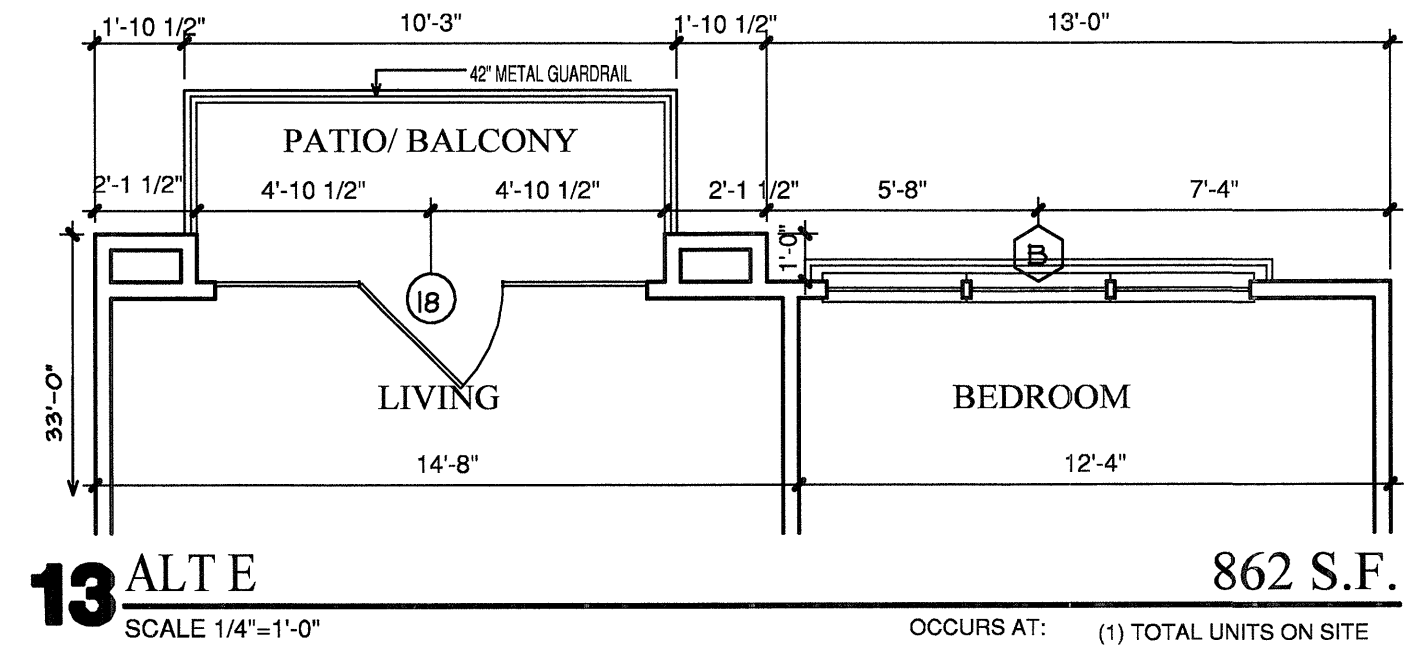


13 ALTE
SCALE 1/4"=1'-0"
862 S.F.
OCCURS AT: (1) TOTAL UNITS ON SITE

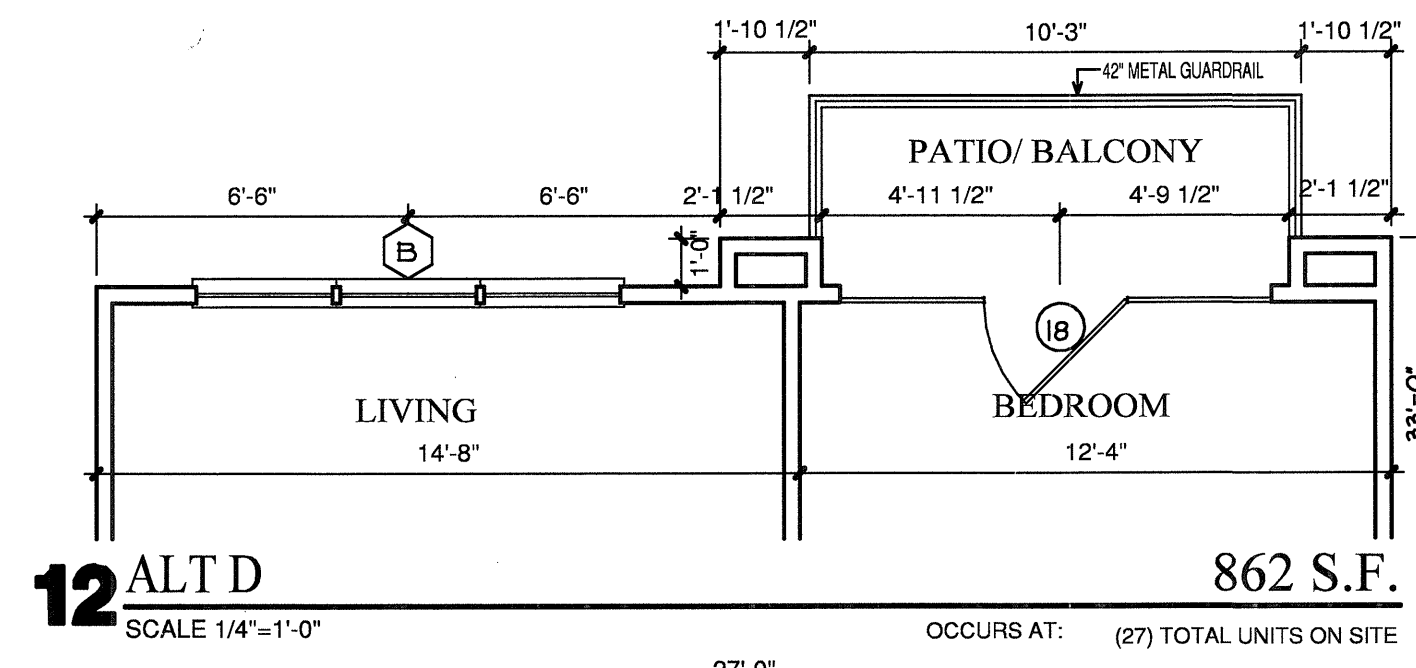


12 ALT D
SCALE 1/4"=1'-0"
862 S.F.
OCCURS AT: (27) TOTAL UNITS ON SITE

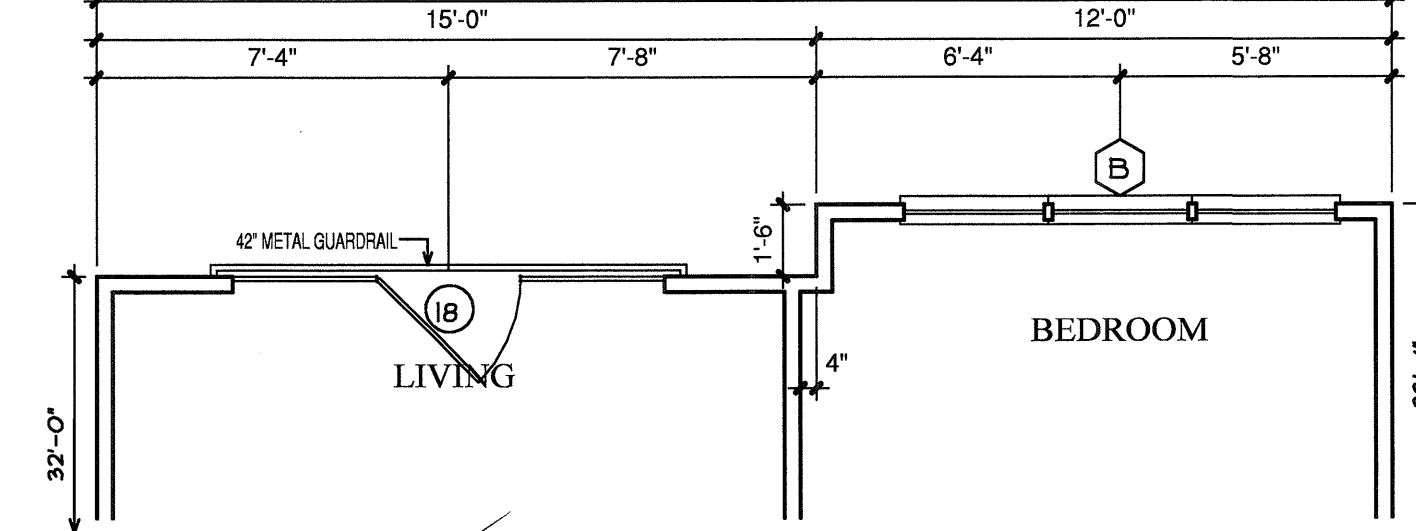


11 ALT 3
SCALE 1/4"=1'-0"
875 S.F.
OCCURS AT: (3) TOTAL UNITS ON SITE

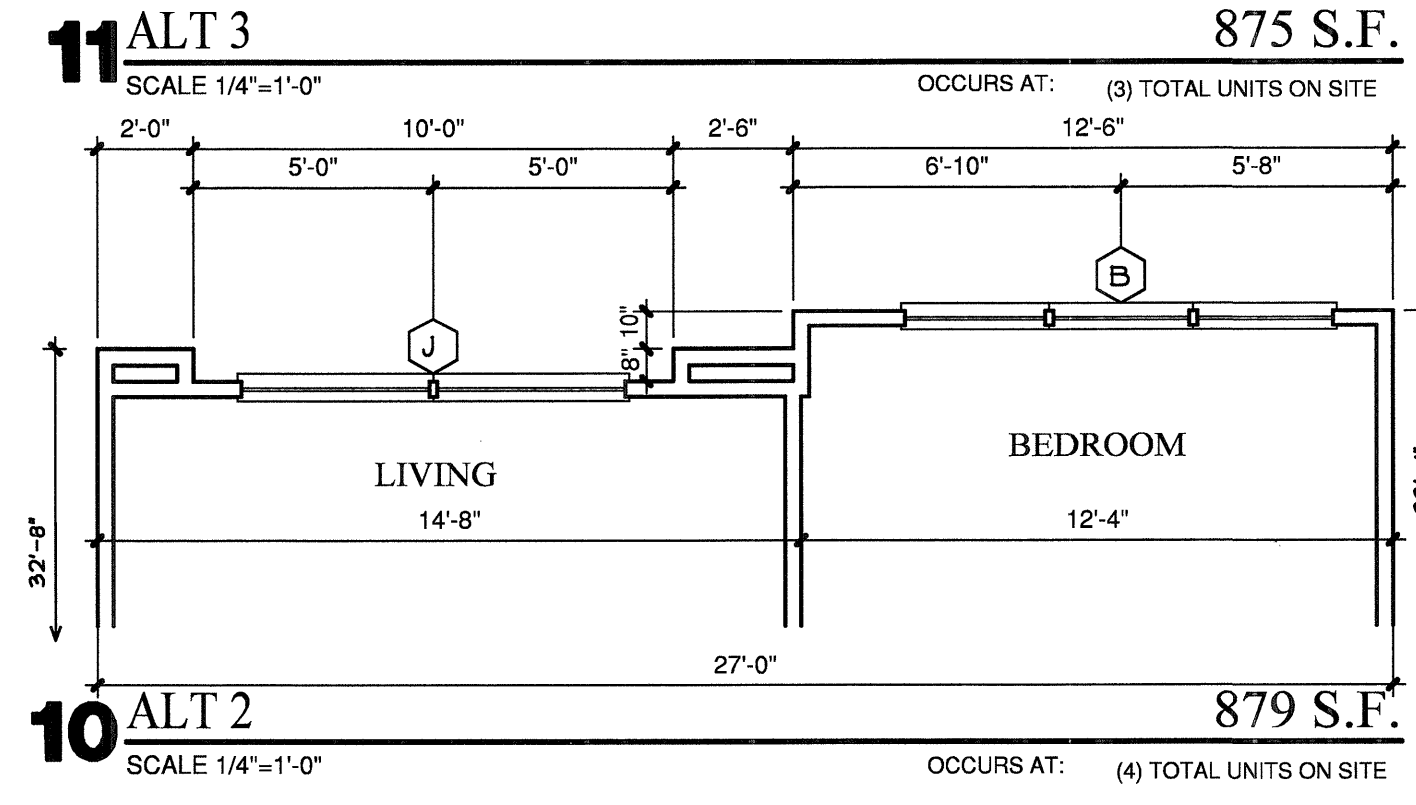


10 ALT 2
SCALE 1/4"=1'-0"
879 S.F.
OCCURS AT: (4) TOTAL UNITS ON SITE

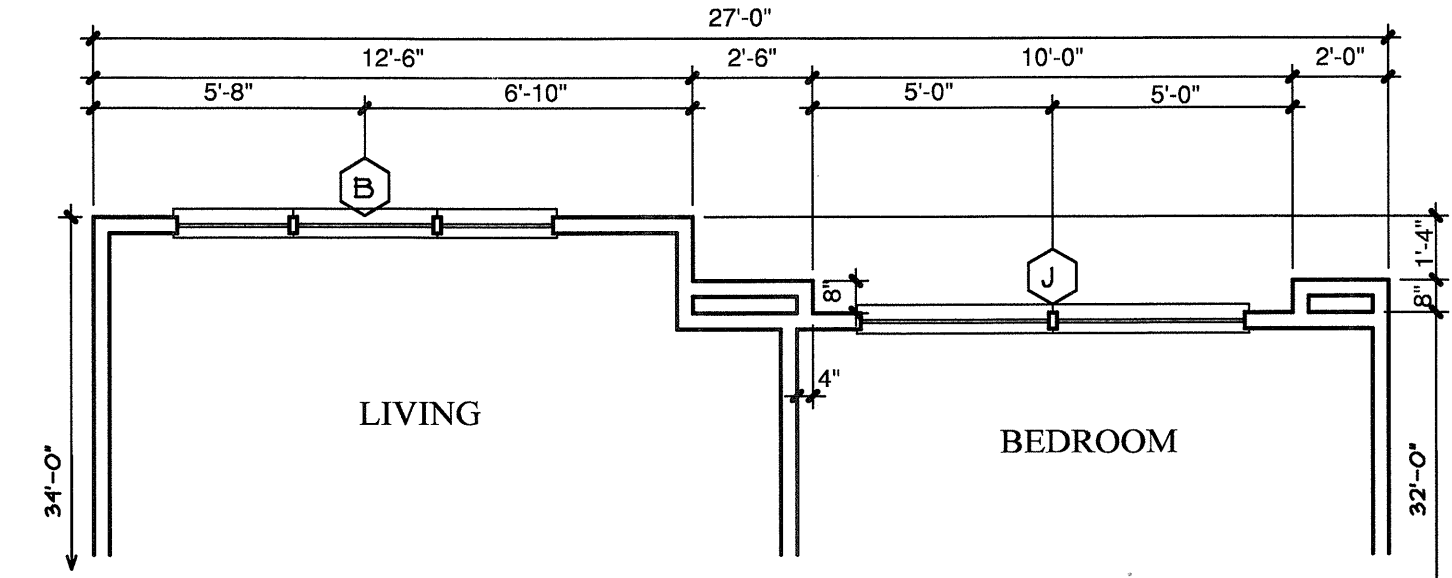

9 ALT 1
SCALE 1/4"=1'-0"
885 S.F.
OCCURS AT: (4) TOTAL UNITS ON SITE

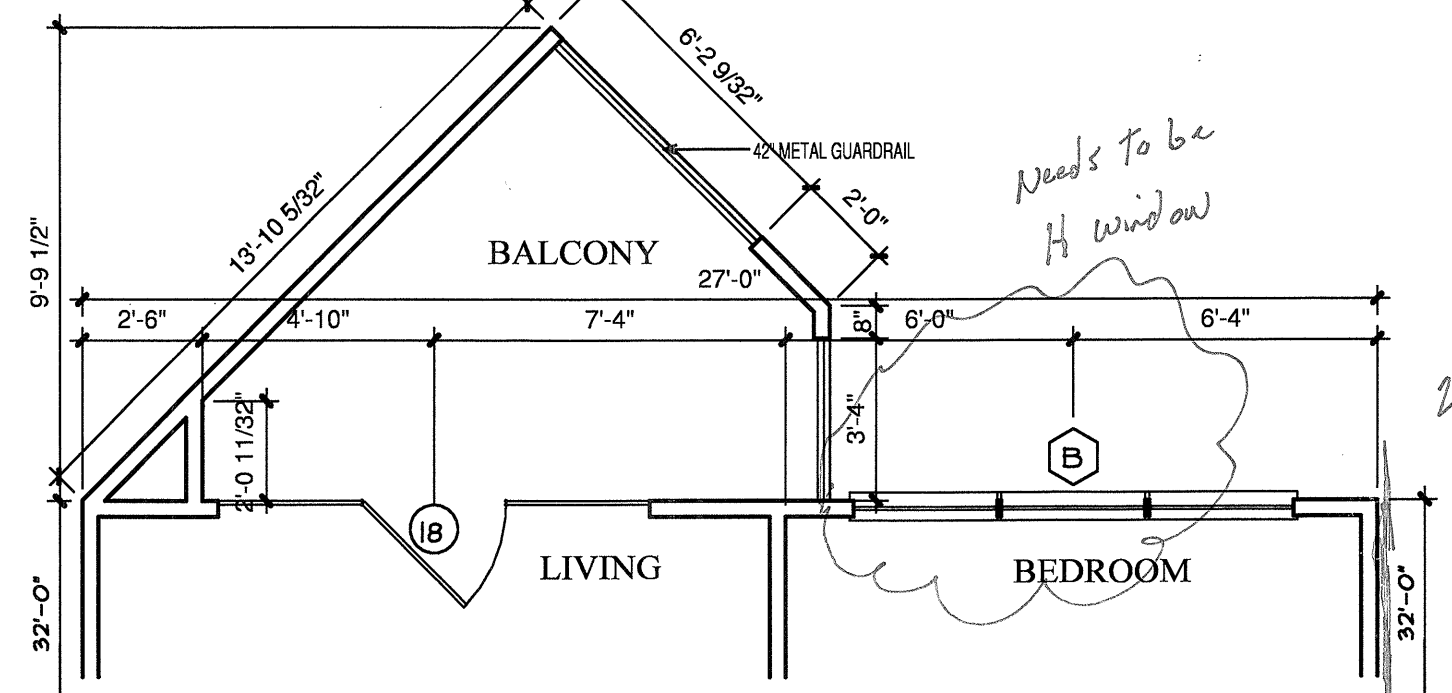

8 PARTIAL 3
SCALE 1/4"=1'-0"
857 S.F.
OCCURS AT: (1) TOTAL UNITS ON SITE

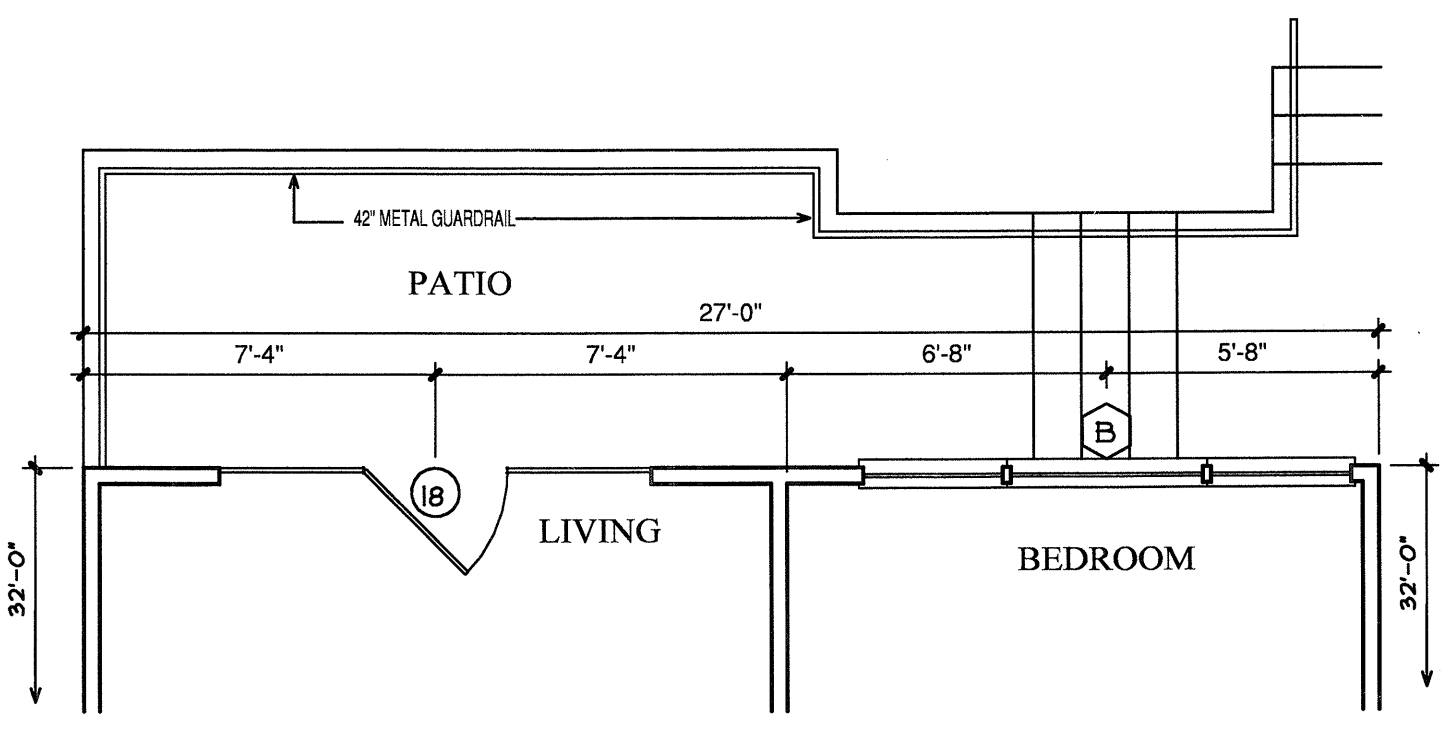

7 PARTIAL 2
SCALE 1/4"=1'-0"
857 S.F.
OCCURS AT: (1) TOTAL UNITS ON SITE


NOTES:
CEILING HEIGHTS ARE 9'-0"
ON THE 2ND, 3RD, AND 4TH FLOORS.
REFERENCE SHEET 3.1 FOR VARYING
CEILING HEIGHTS AT FIRST FLOOR.

NOTES:
CROSSHATCHING ON PLAN INDICATES
AREAS TO BE
SUFFICIENTLY BLOCKED
FOR GRAB BARS.

1/4" FURRDOWN

30"X 48"
CLEAR
FLOOR
SPACE

COORDINATE ALL
FURRDOWN LOCATIONS
WITH MECHANICAL
SHOP DRAWINGS

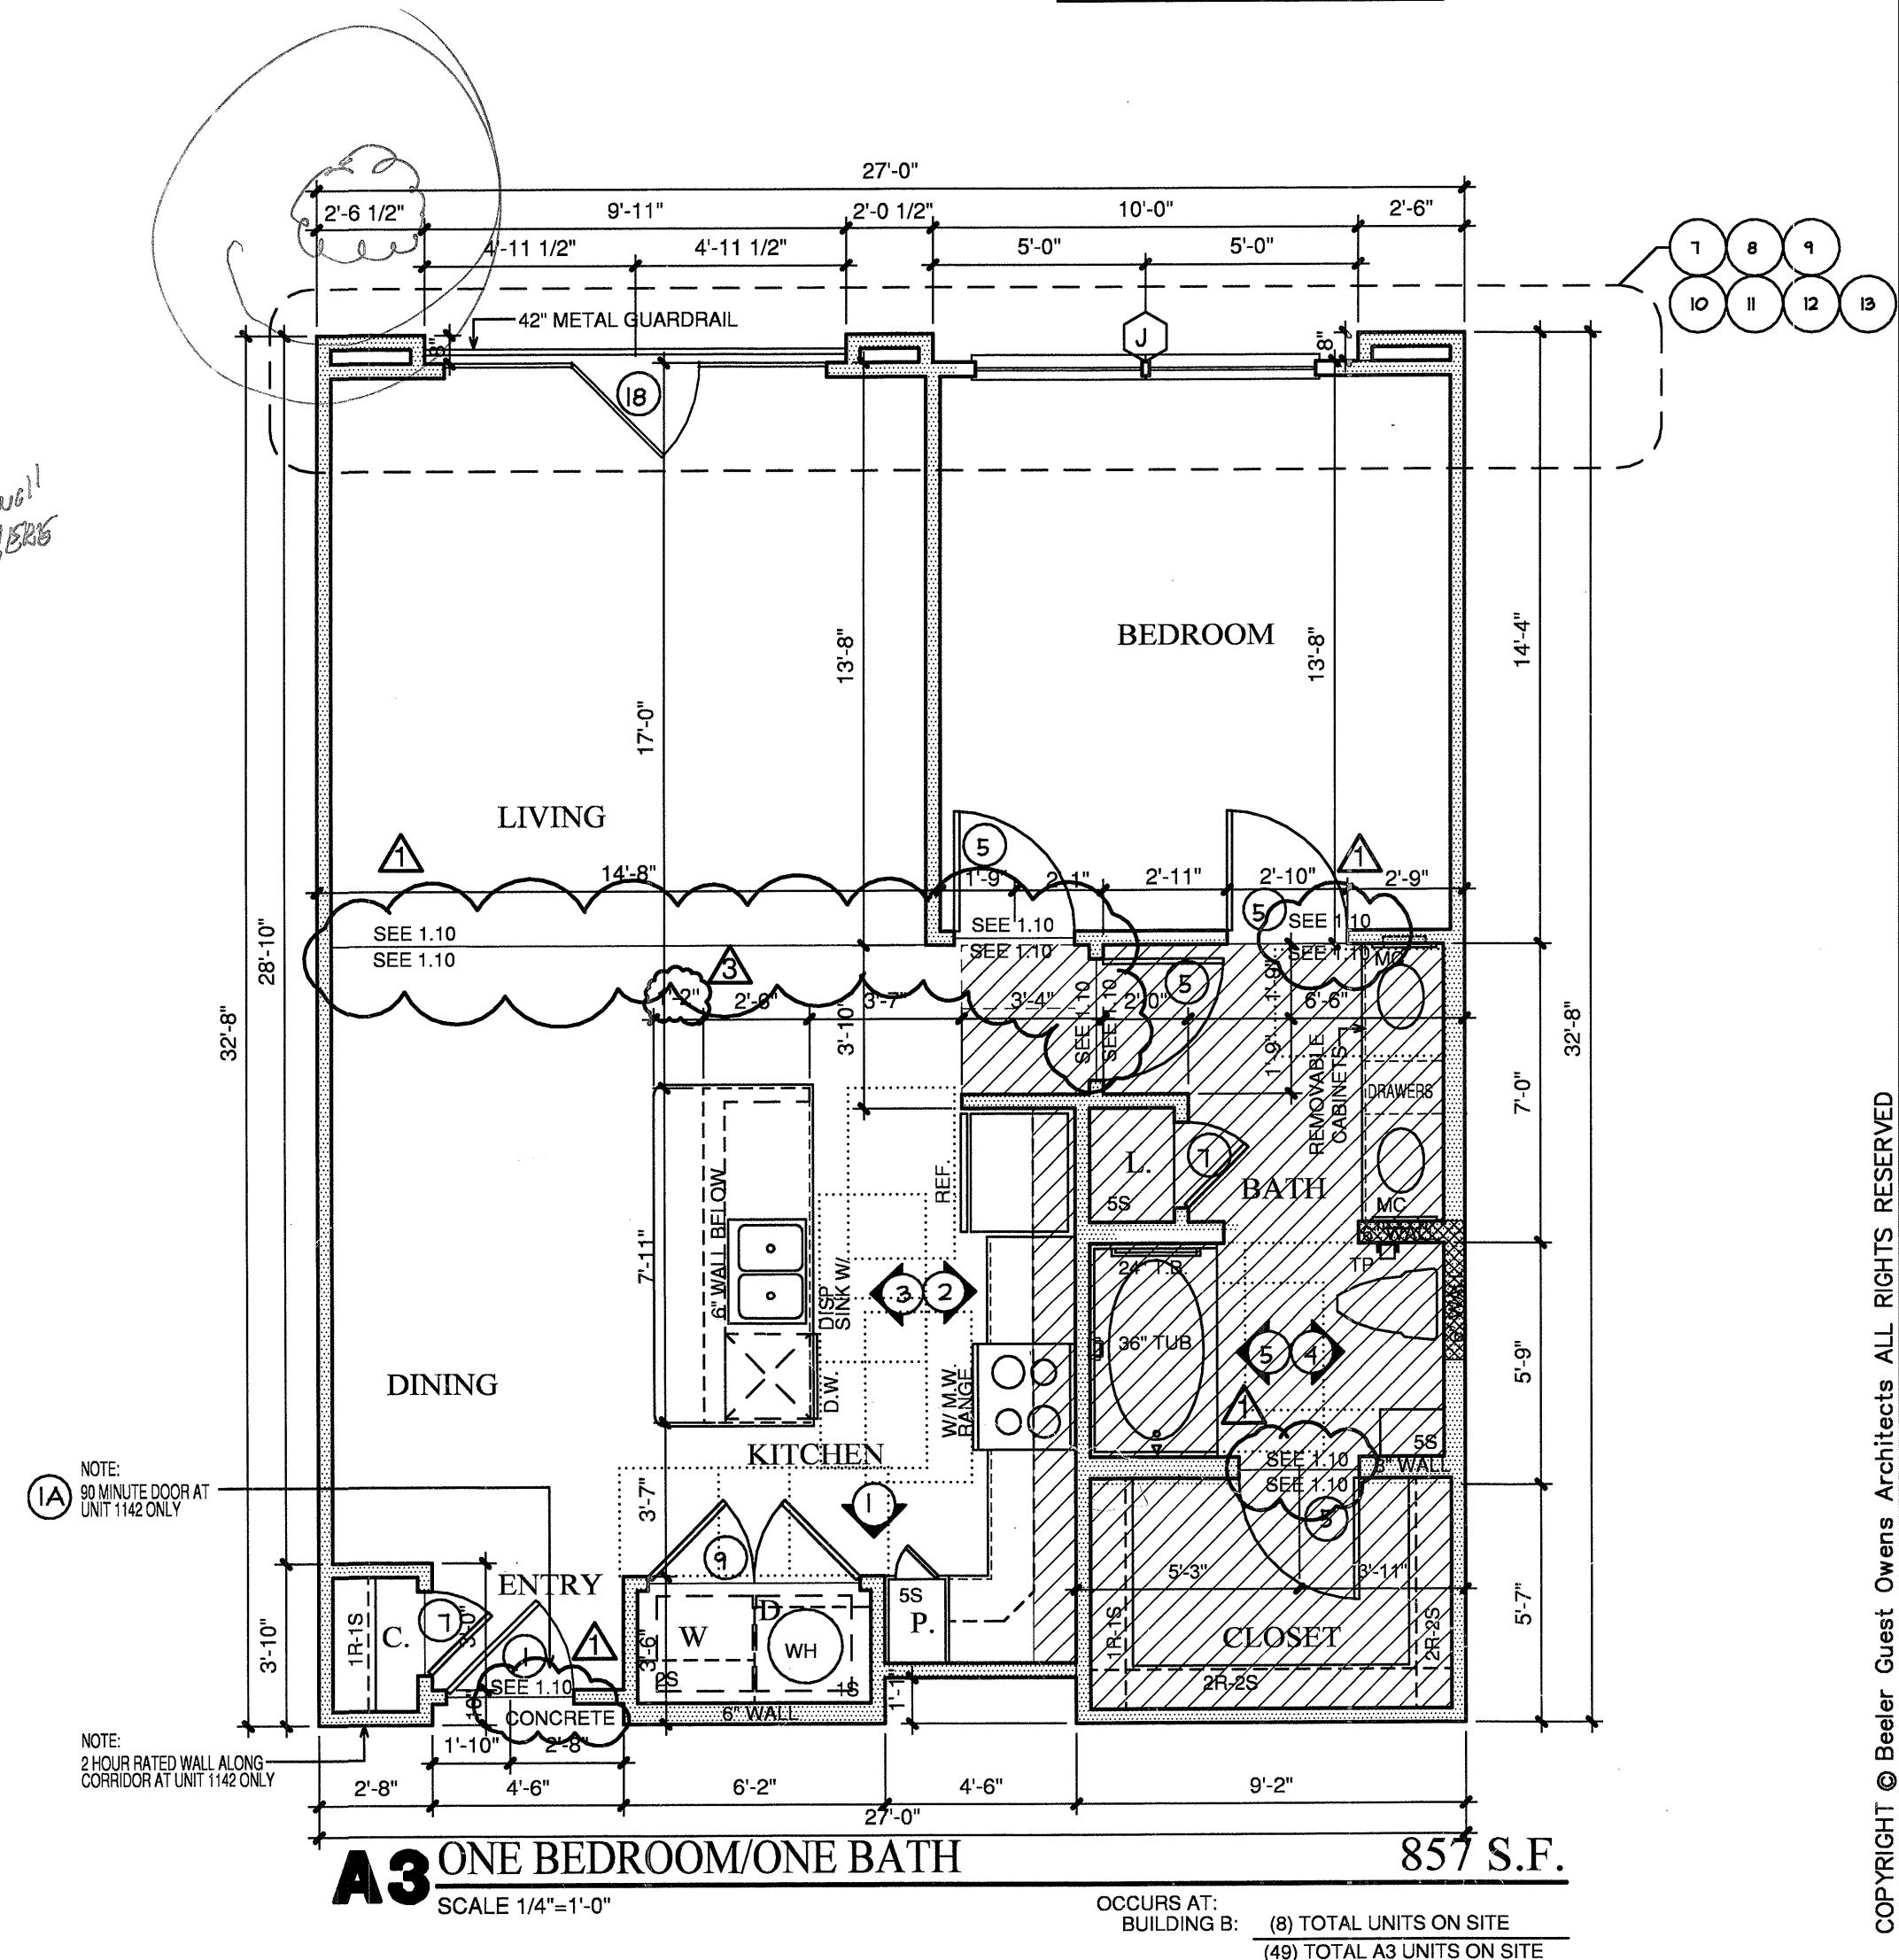

A3 ONE BEDROOM/ONE BATH
SCALE 1/4"=1'-0"
857 S.F.
OCCURS AT: (8) TOTAL UNITS ON SITE
BUILDING B: (49) TOTAL A3 UNITS ON SITE