
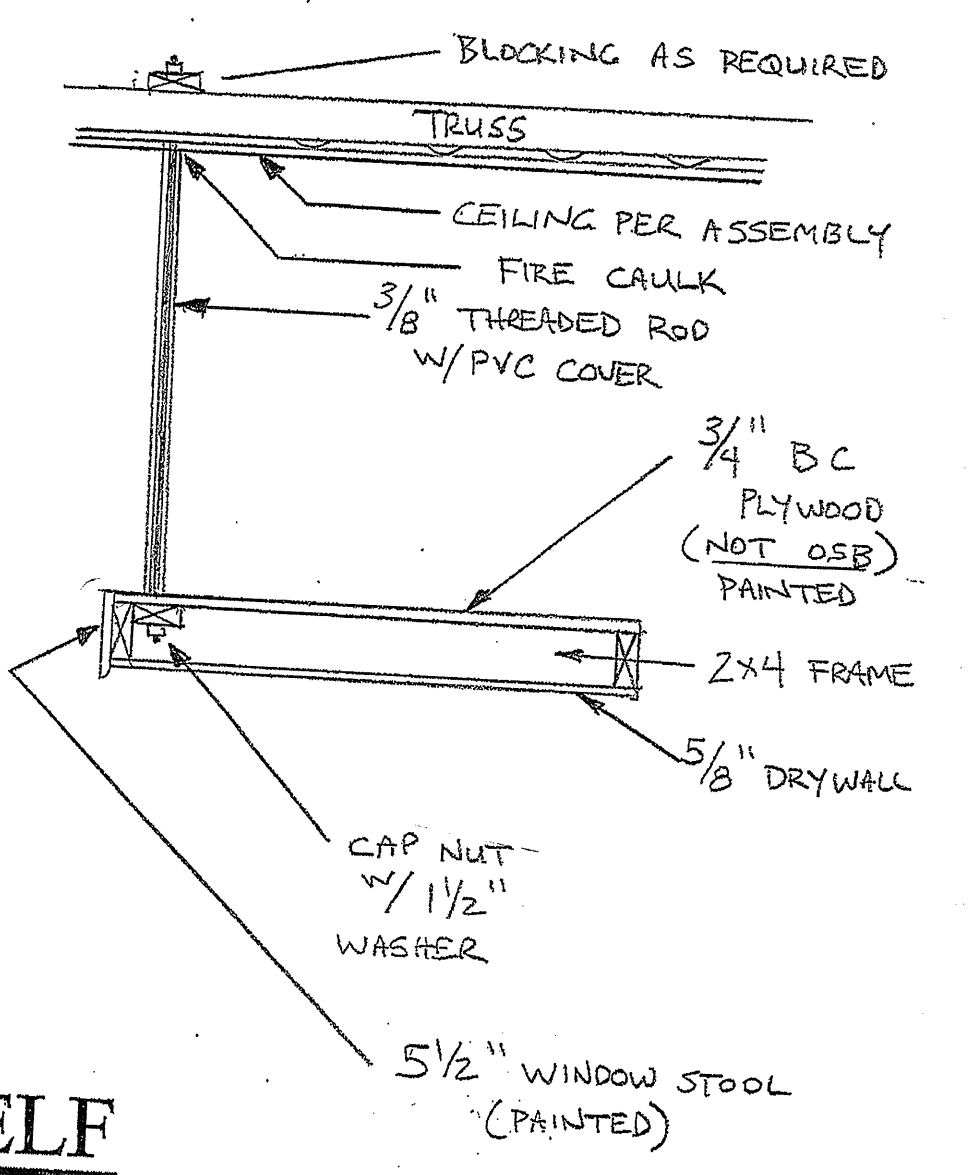


Platform for Tallboy • Lowboy

EMBREY STANDARD DETAIL  
5/29/12

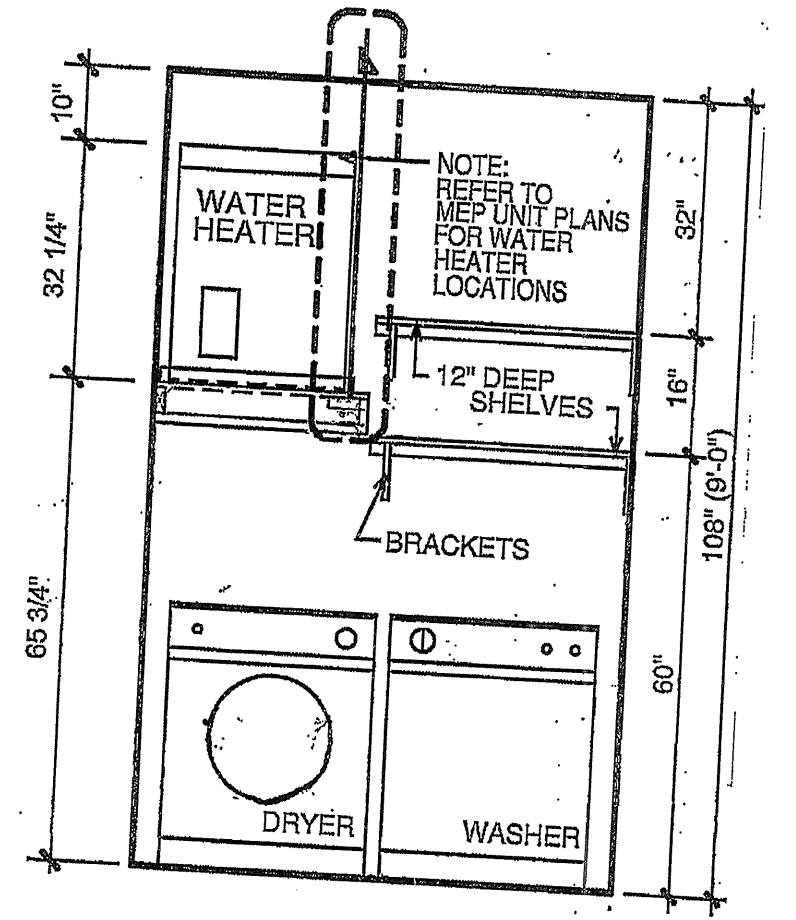

**SUSPENDED  
WATER HEATER SHELF**