

EMBREY BUILDERS, LLC.
 1020 N. E. Loop 410, Suite 700
 San Antonio, TX 78209
 Ph: (210) 824-8044 Fax: (210) 824-7656

RFI

To: Jordan & Skala Engineers, Inc.
 14240 Midway Road, Suite 350
 Dallas, TX 75244
 Ph: 469/385-1616 Fax: 469/385-1615

RFI #: 32
 Date: 1/12/2012
 Job: EB-02 Keller Springs Lofts
 Phone: 877-777-5115

CC: Erik Earnshaw (BGO)
 Subject: B2 master Bathroom Toilet

Drawing: Arch 2.7 P2.6
 Cost Impact: None
 Spec Section:
 Schedule Impact: None

Request: Heath our Plumber requested a RFI. In the master bathroom on the B2 unit the toilet is not centered on the wall is this correct?
 Date Required: 1/16/2012

Requested by: Bryan Pickler
 Embrey Partners, Ltd.

Response:

It is acceptable to center the water closet in bathroom #1 for the B2 units as requested.

Erik Earnshaw
 Answered by: BGO
 Date: 01-23-2012
 Company: _____ Date: _____

EMBREY BUILDERS, LLC.
 1020 N. E. Loop 410, Suite 700
 San Antonio, TX 78209
 Ph: (210) 824-8044 Fax: (210) 824-7656

RFI

To: Erik Earnshaw
 Beeler Guest Owens Architects
 4245 N. Central Expressway
 Suite 300
 Dallas, TX 75205
 Ph: 214/520-8878 Fax: 214/520-8879

RFI #: 127
 Date: 5/21/2012
 Job: EB-02 Keller Springs Lofts
 Phone: 877-777-5115

CC:
 Subject: B2 Unit Question

Drawing: A2.7
 Cost Impact: None
 Spec Section:
 Schedule Impact: None


Request: Please provide the door type for the Bath #1 door into the toilet room.
 Date Required: 5/29/2012

Requested by: David Miller
 Embrey Builders LLC

Response: See sheet 2.7

Ryan Faulds
 BGO architects
 June 01, 2012

Answered by: _____
 Company: _____ Date: _____

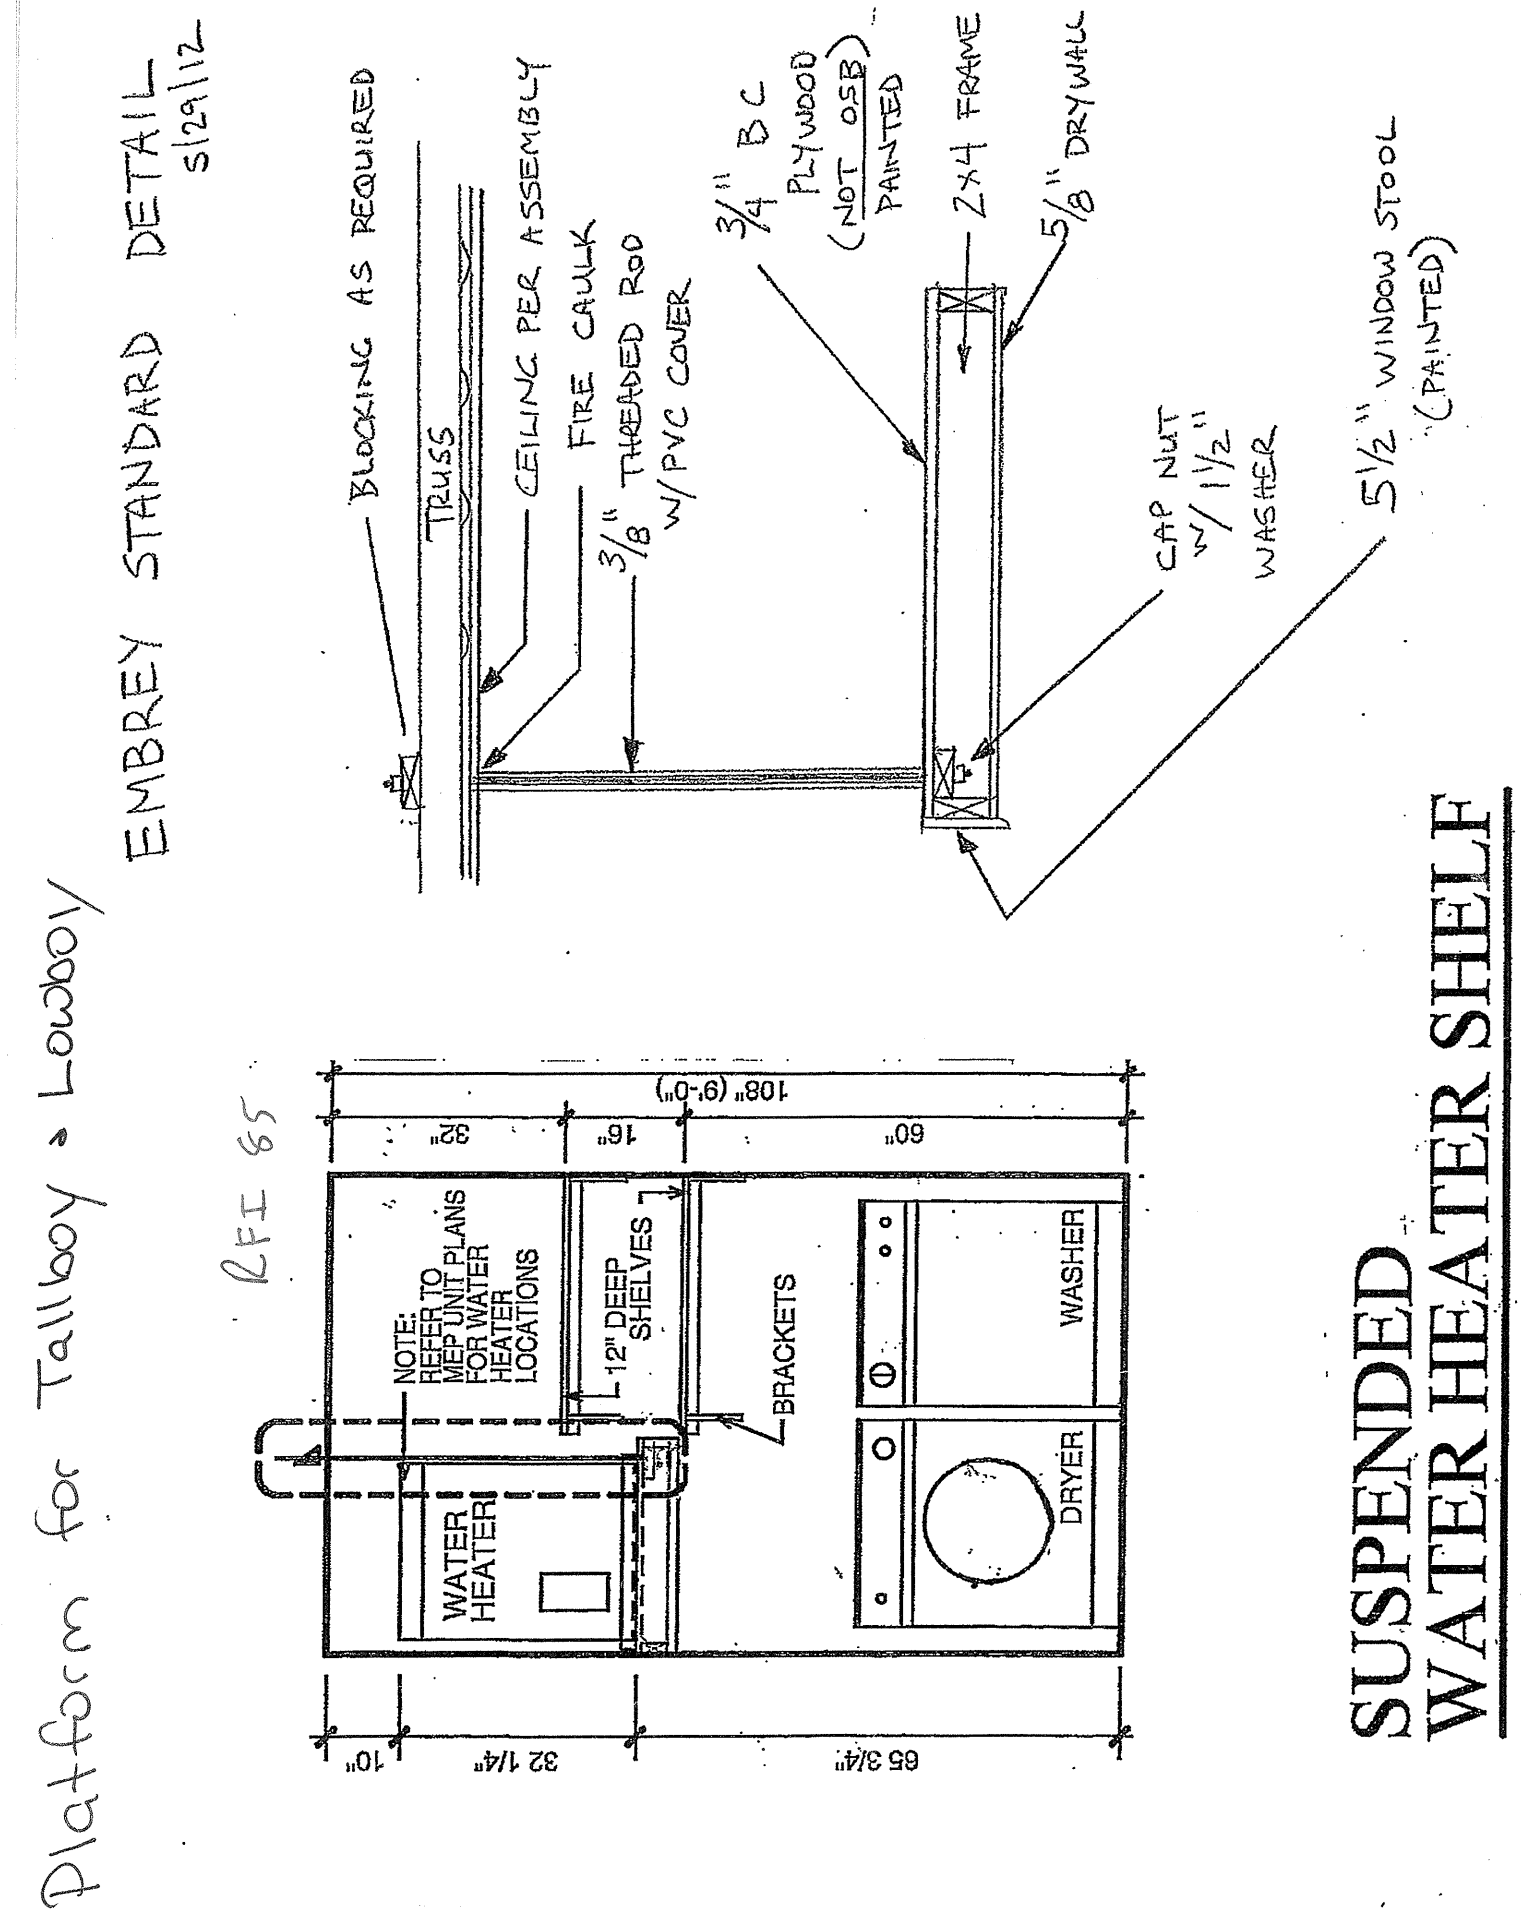

Embrey Builders, LLC
 1020 N. E. Loop 410, Suite 700
 San Antonio, TX 78209
 Ph: (210) 824-8044 Fax: (210) 824-7656

RFI

To: Erik Earnshaw
 Beeler Guest Owens Architects
 4245 N. Central Expressway
 Suite 300
 Dallas, TX 75205
 Ph: 214/520-8878 Fax: 214/520-8879

RFI #: 154
 Date: 6/13/2012
 Job: EB-02 Keller Springs Lofts
 Phone: 877-777-5115

CC:
 Subject: B2 Framing Questions

Drawing: A2.7
 Cost Impact: None
 Spec Section:
 Schedule Impact: None

Request: To make more room for the vanity cabinet in Bath #2, can we make the 2x6 wall between the vanity and linen closet a 2x4 wall? Can we make the 2x6 wall between Bath #2 and the closet a 2x6 wall to make the door more standard?
 Date Required:

Requested by: David Miller
 Embrey Builders LLC

Response: 1- No, changing the wall between vanity and linen would affect the cabinet and granite counter top dimensions that are already in production.
 2- Yes, there is no structural reason for this wall to be made with 2x8 studs, 2x6 studs would be good.

Ryan Faulds
 BGO architects
 July 06, 2012

Answered by: _____
 Company: _____ Date: _____