



03-07-2012

REVISIONS

COORDINATION	02-29-2012
RFI- 143 & 147	07-09-2012

KELLER SPRINGS LOFTS

LOFT APARTMENTS IN ADDISON, TEXAS

CONSTRUCTION ISSUE
10-17-2011



4144 N. Central Expy.
Suite 855
Dallas, TX 75204
214.520.8878
bgoarchitects.com


DATE
08-05-2011

PROJECT
11129


SHEET NUMBER
2.7B

B2 ALT UNIT


COPYRIGHT © Beeler Guest Owners Architects ALL RIGHTS RESERVED

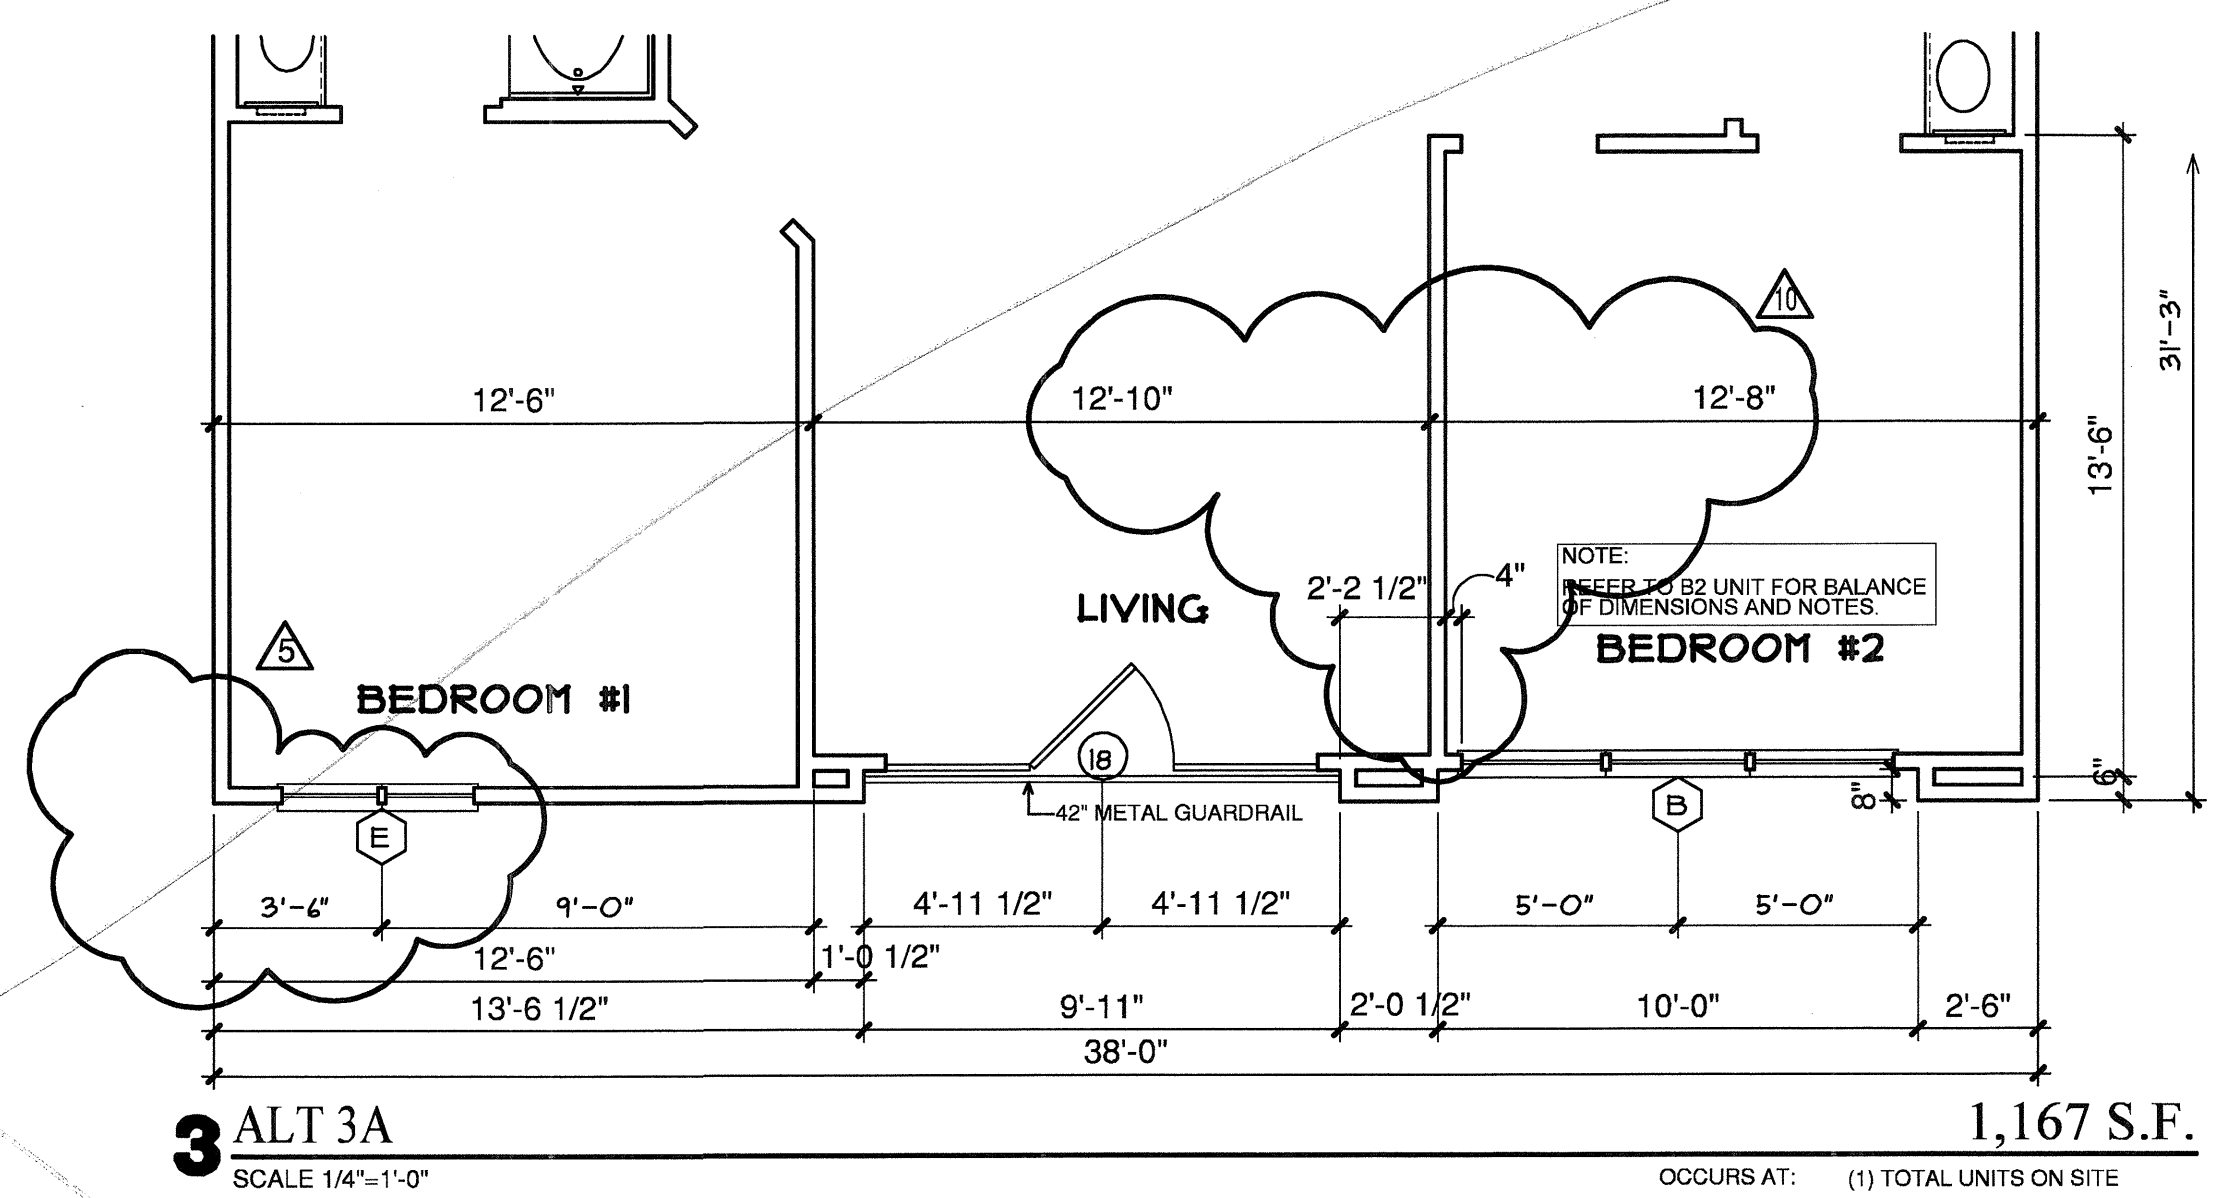


3 ALT 3A 1,167 S.F.
SCALE 1/4"=1'-0" OCCURS AT: (1) TOTAL UNITS ON SITE

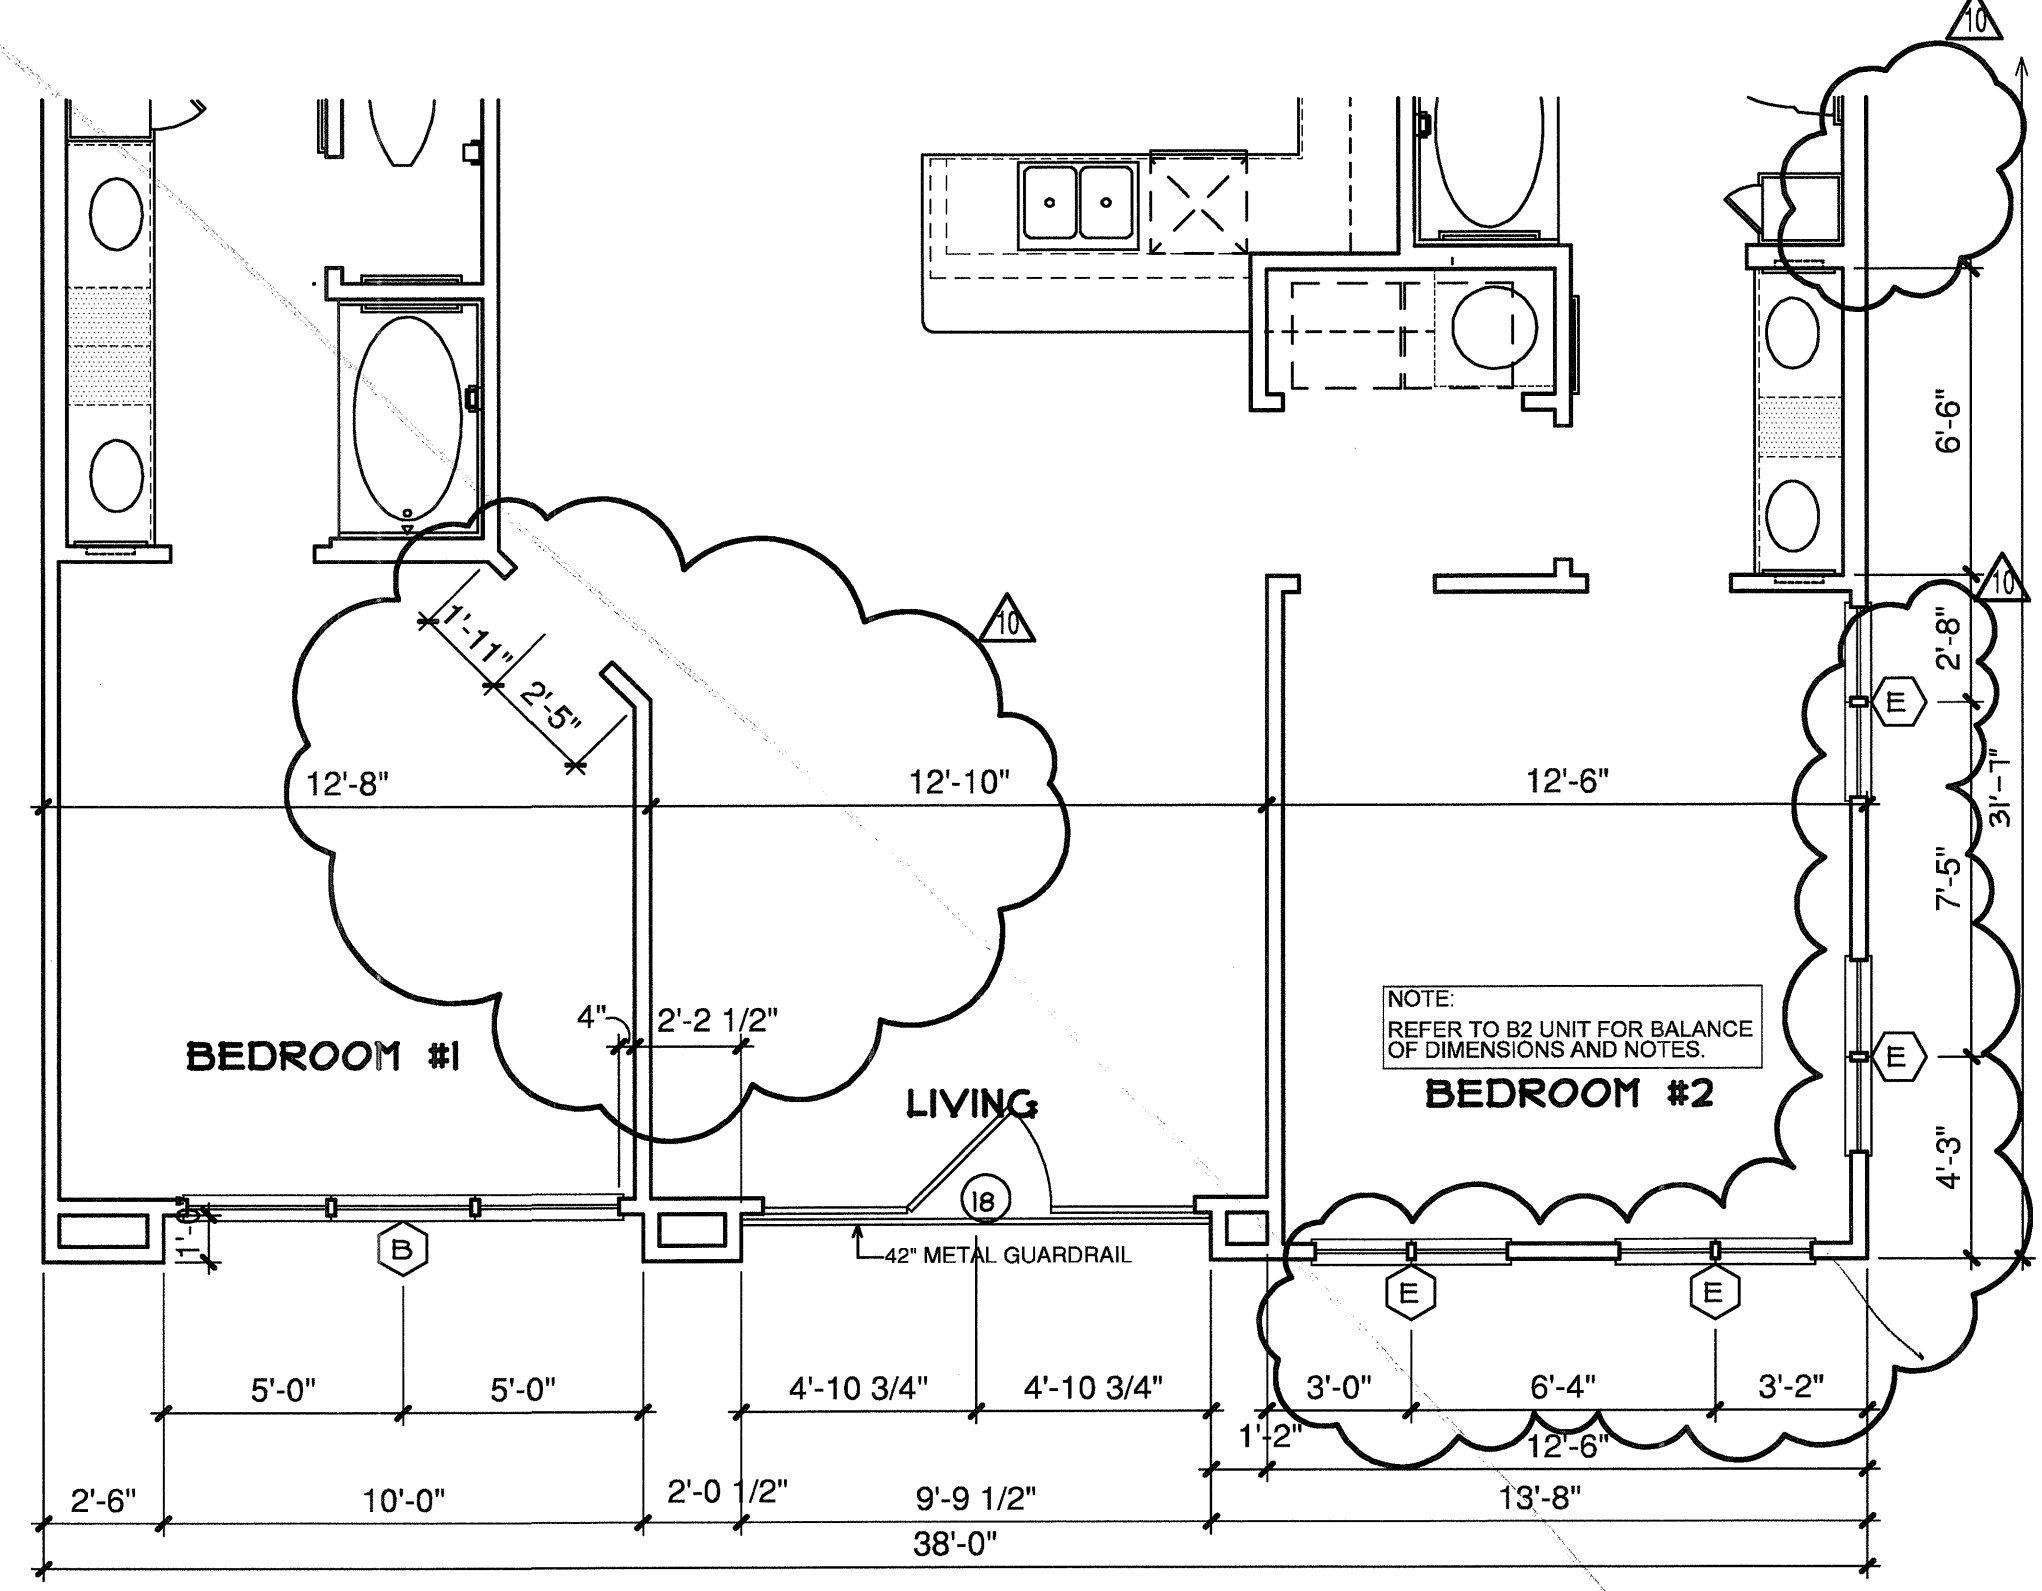


2 ALT 2A 1,174 S.F.
SCALE 1/4"=1'-0" OCCURS AT: (1) TOTAL UNITS ON SITE

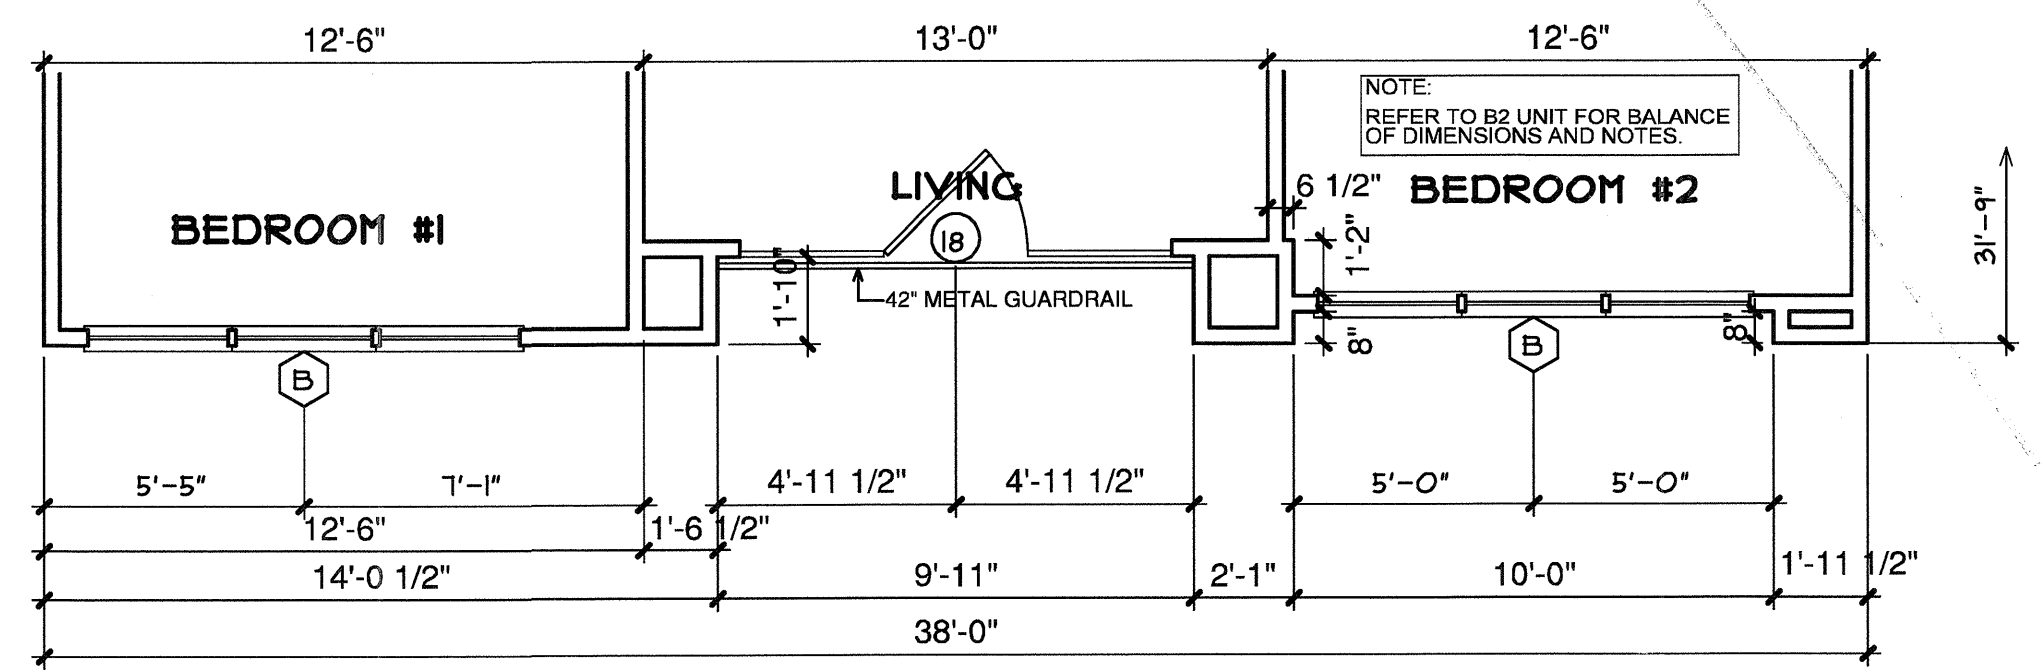


1 ALT 1A 1,174 S.F.
SCALE 1/4"=1'-0" OCCURS AT: (2) TOTAL UNITS ON SITE

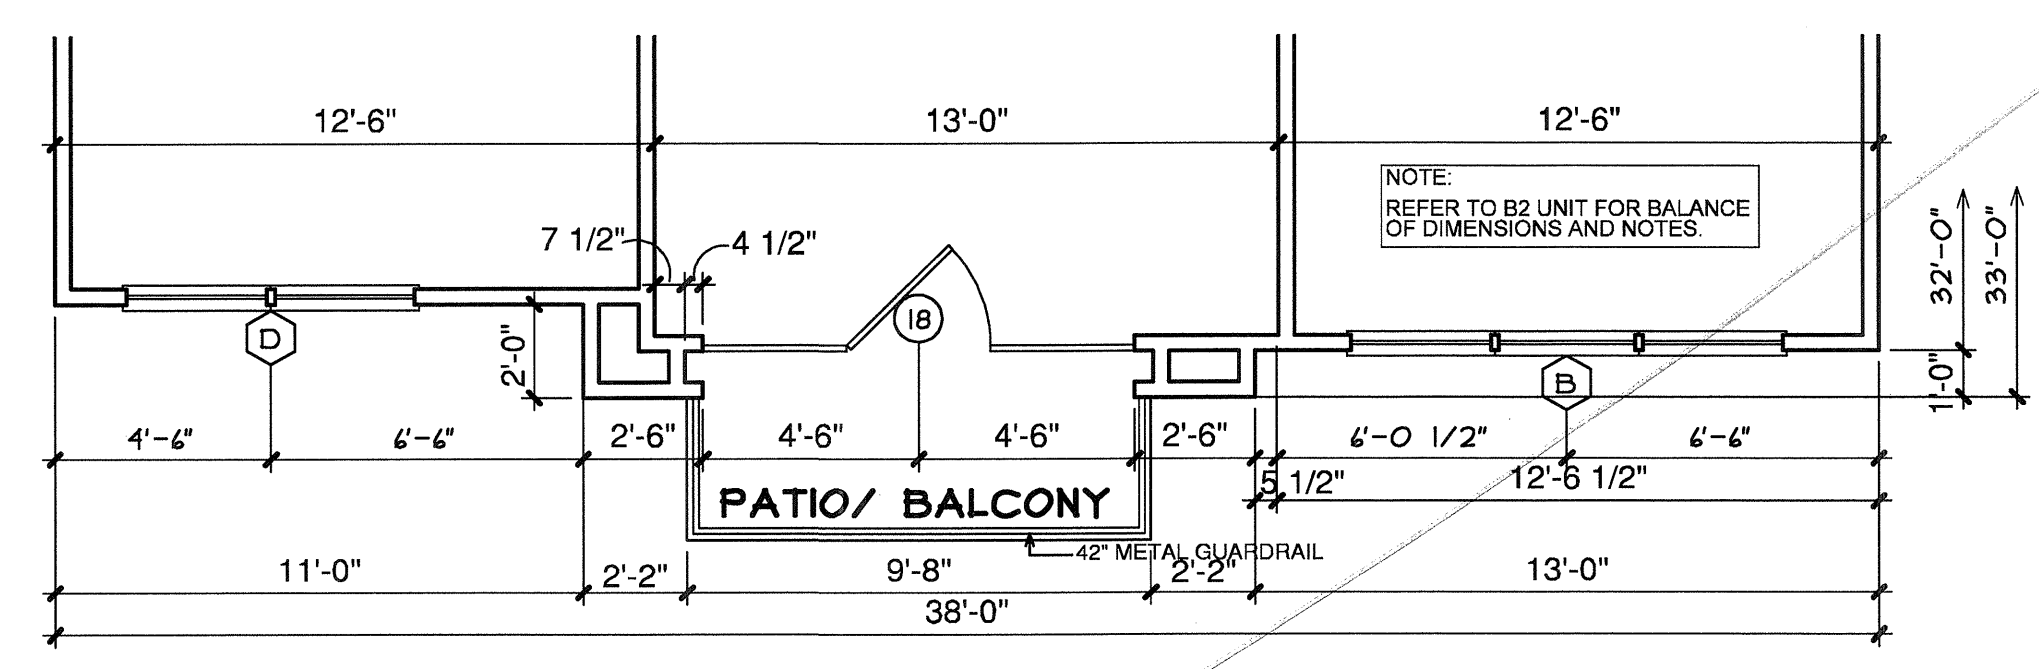

6 B2-C ALT 1 1,197 S.F.
SCALE 1/4"=1'-0" OCCURS AT: (12) TOTAL UNITS ON SITE

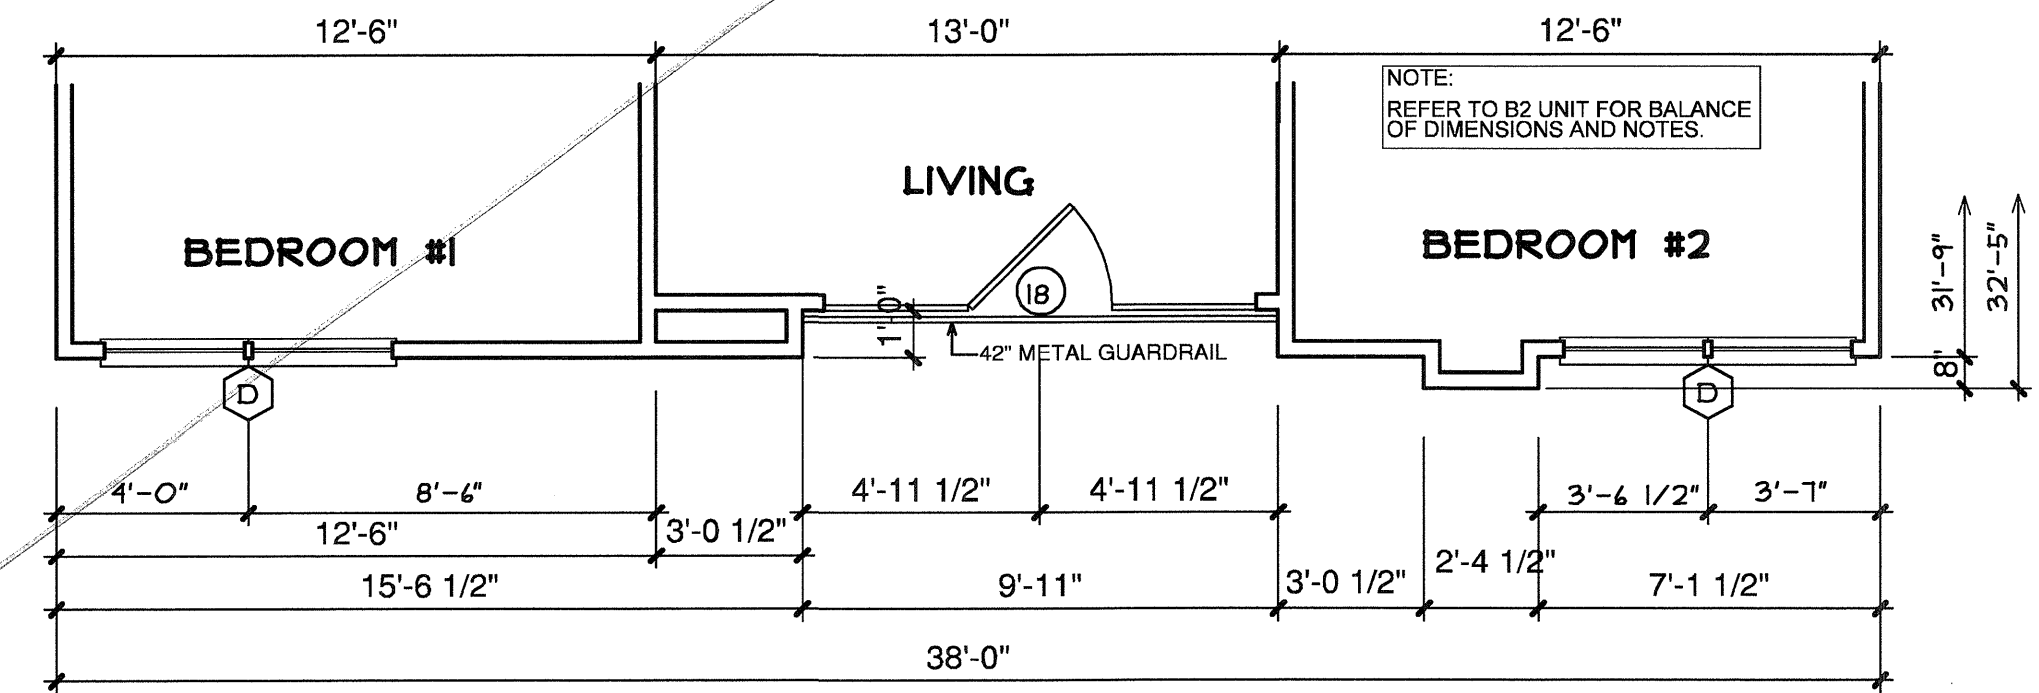

5 ALT 5A 1,191 S.F.
SCALE 1/4"=1'-0" OCCURS AT: (1) TOTAL UNITS ON SITE

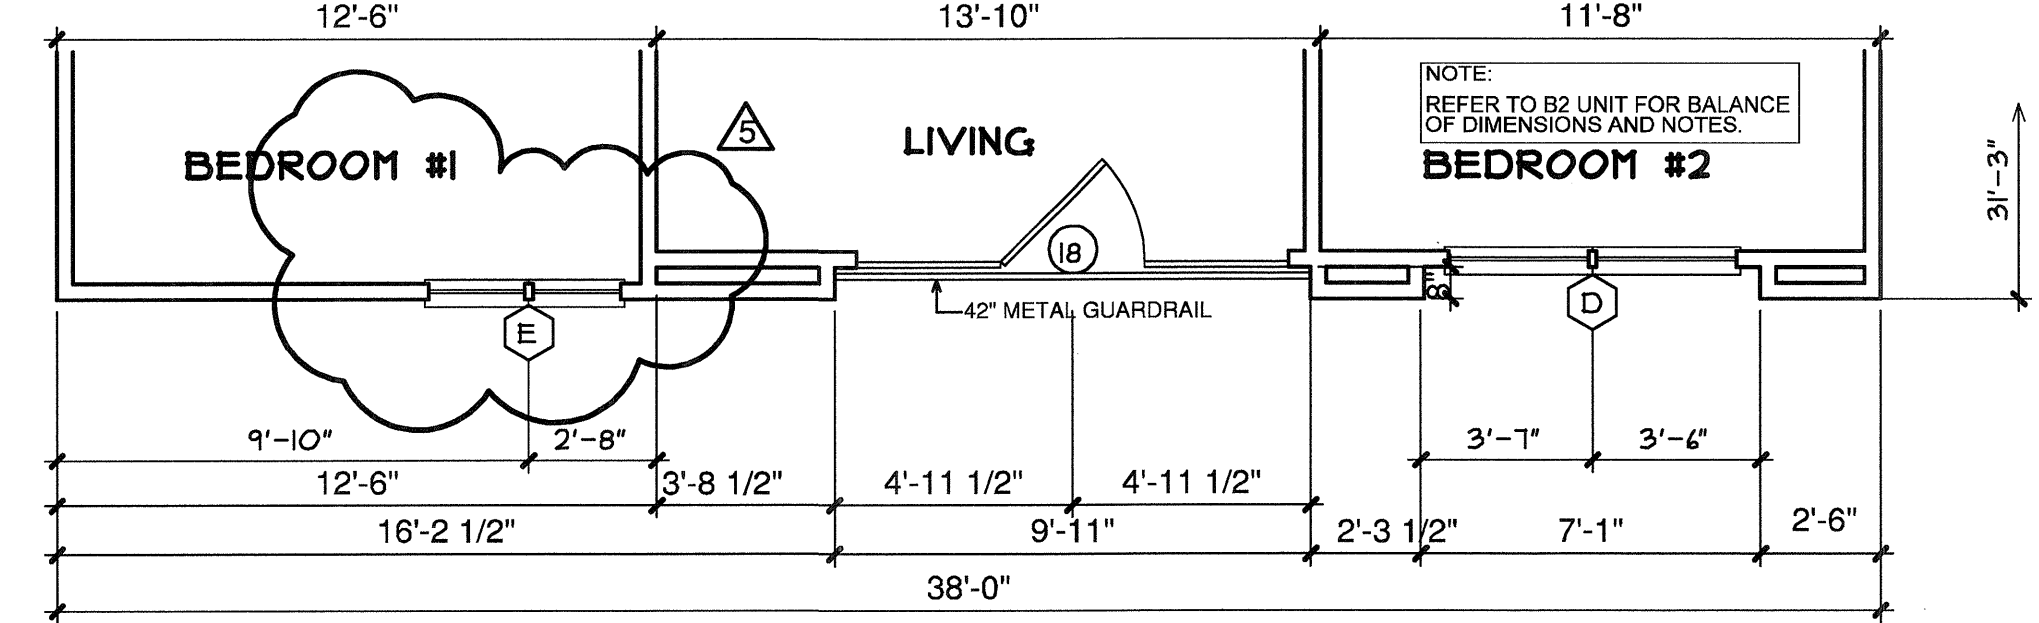

4 ALT 4A 1,167 S.F.
SCALE 1/4"=1'-0" OCCURS AT: (1) TOTAL UNITS ON SITE