
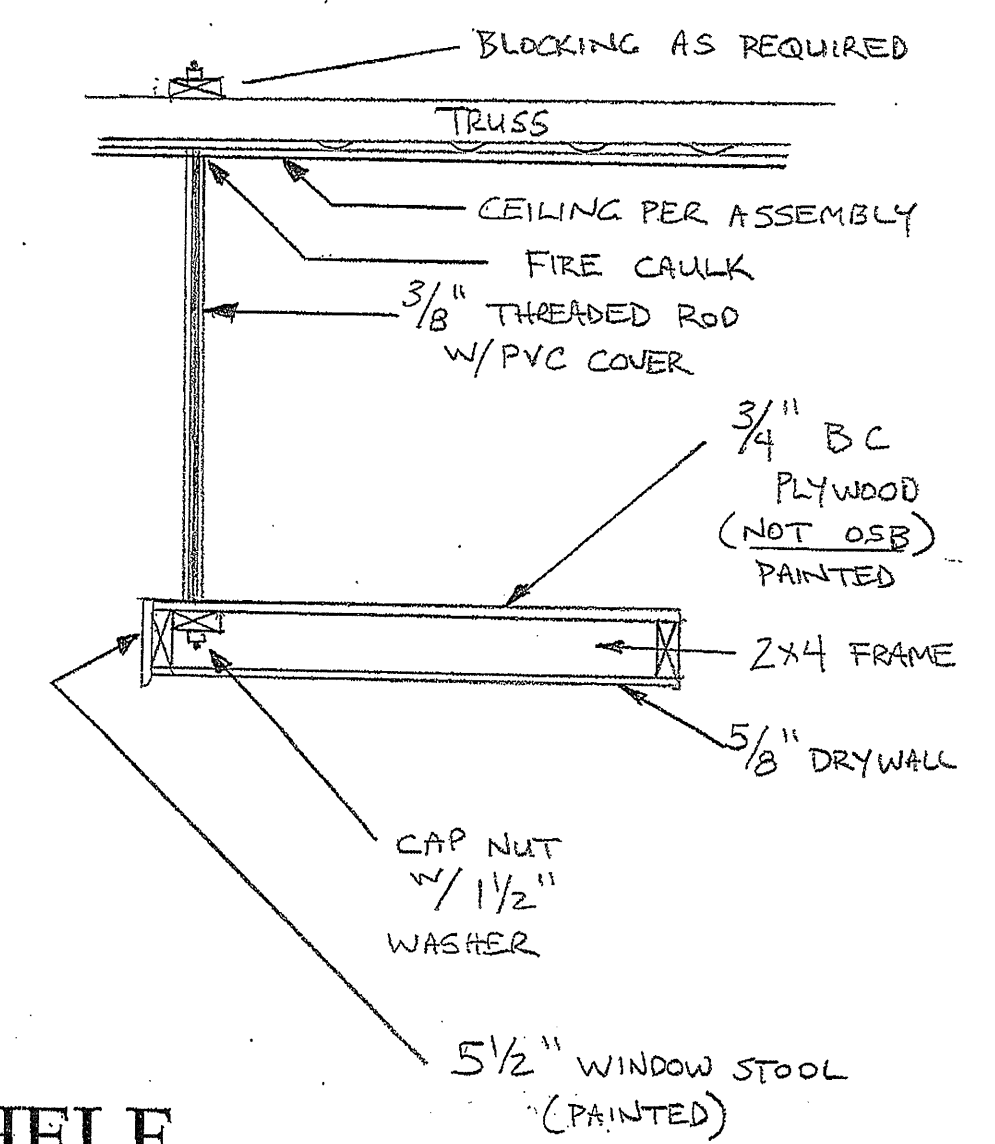


Platform for Tallboy • Lowboy

EMBREY STANDARD DETAIL
S12A112

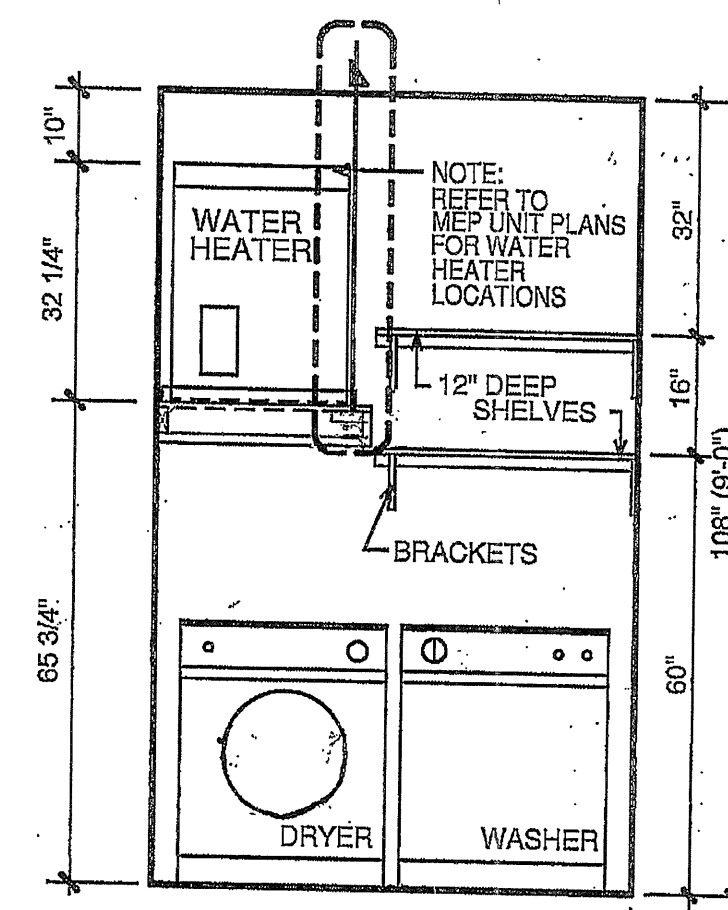

**SUSPENDED
WATER HEATER SHELF**