




1 KITCHEN
SCALE 3/8"=1'-0"

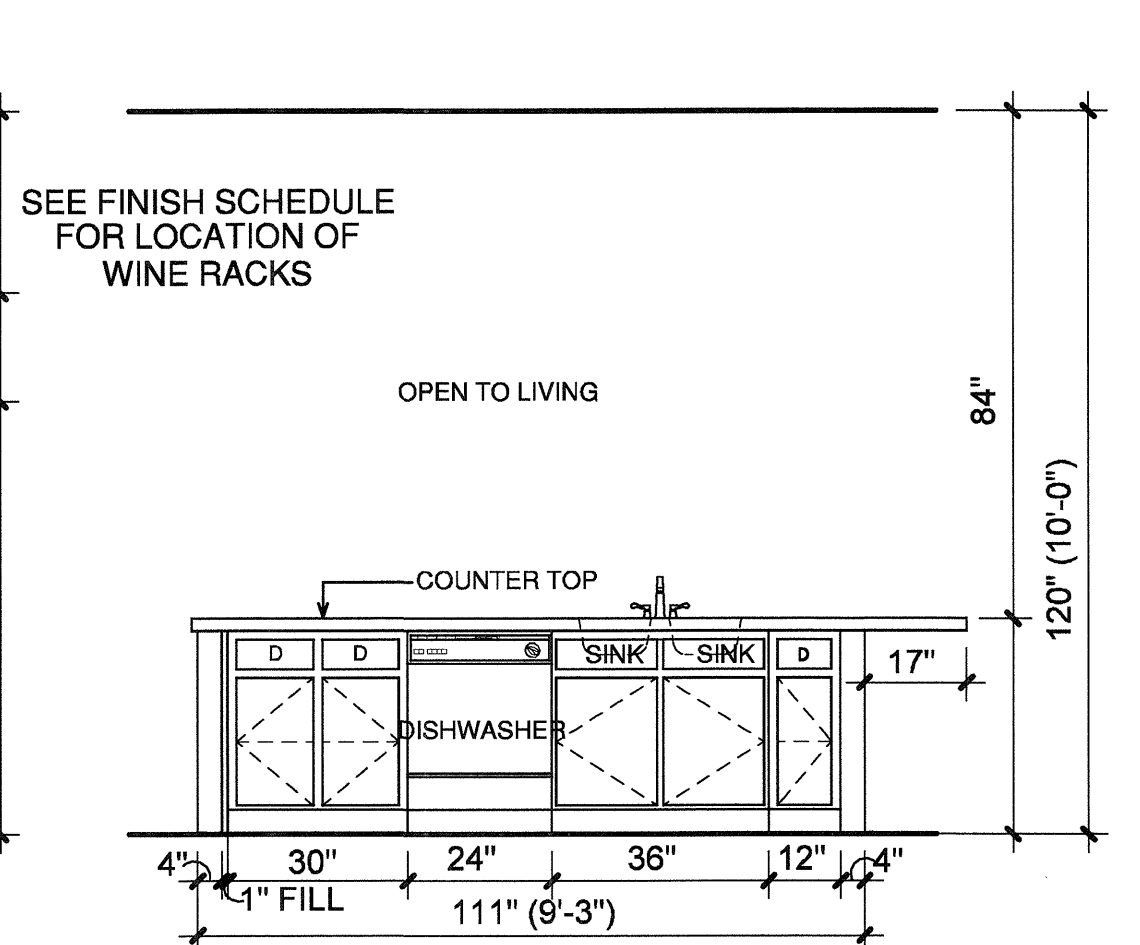

2 KITCHEN
SCALE 3/8"=1'-0"

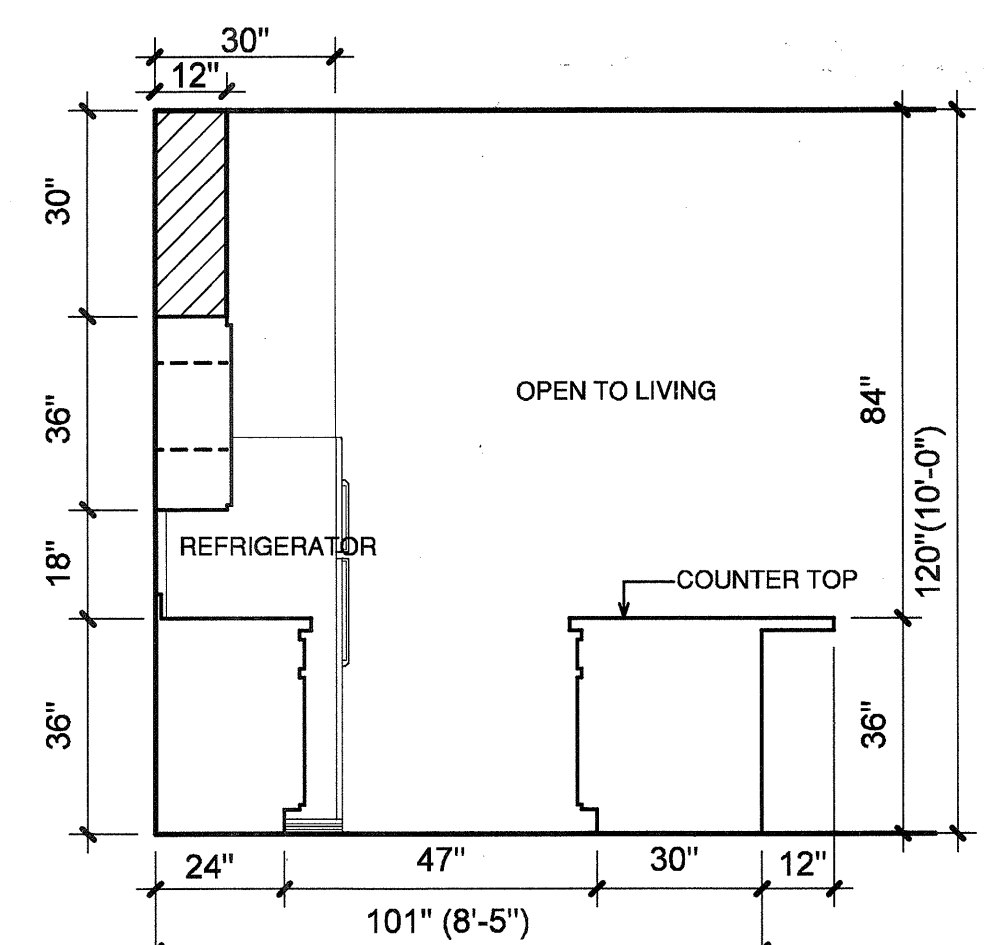

3 KITCHEN
SCALE 3/8"=1'-0"

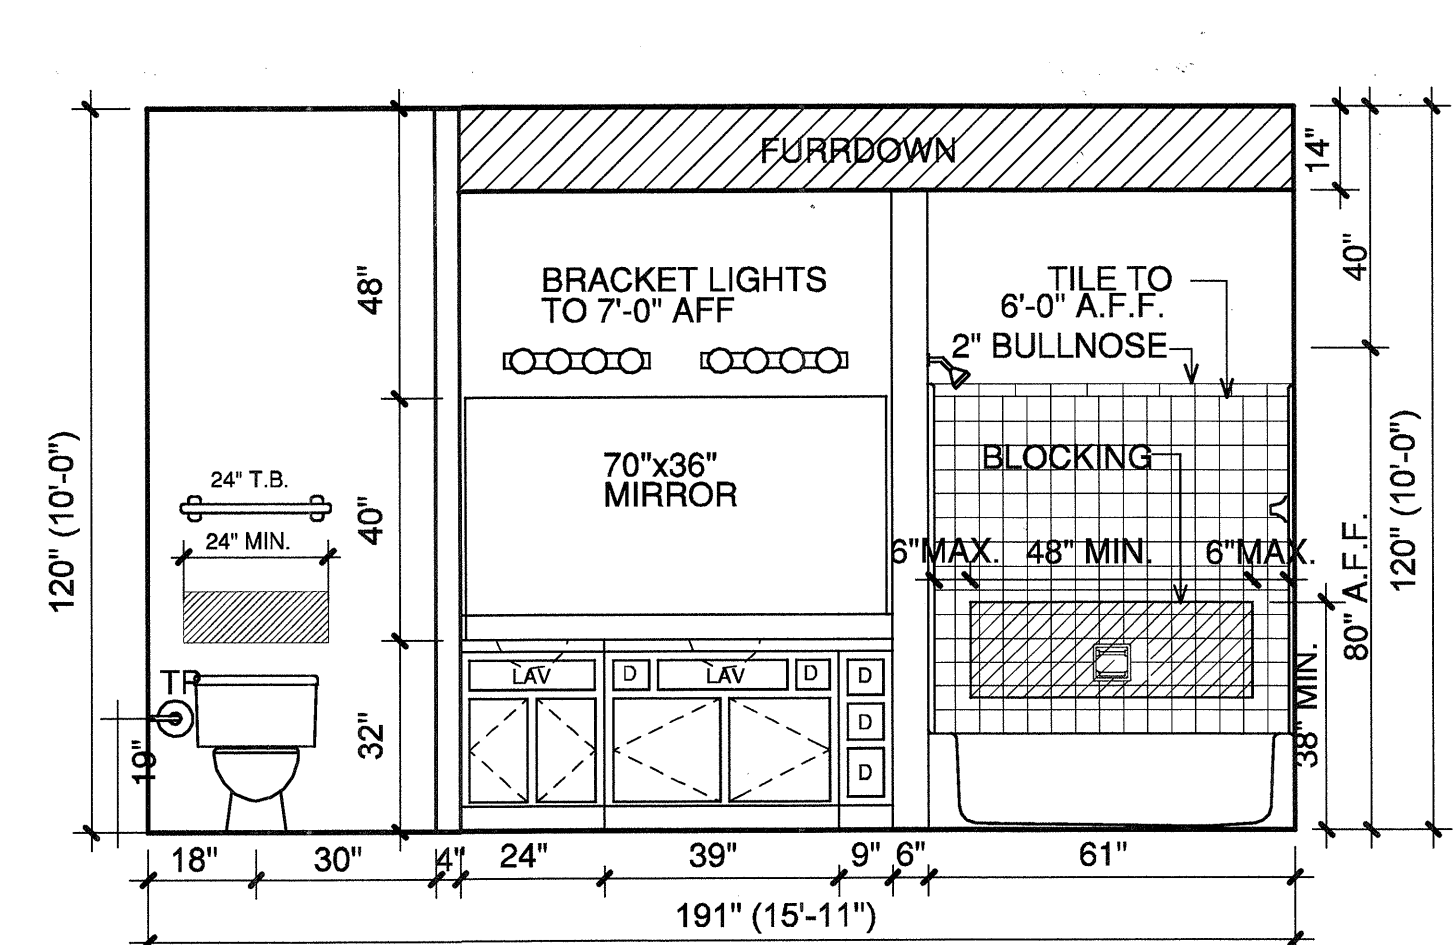

4 BATH #1
SCALE 3/8"=1'-0"


NOTES:
CEILING HEIGHTS ARE 9'-0"
ON THE 2ND, 3RD, AND 4TH FLOORS.
REFERENCE SHEET 31 FOR VARYING
CEILING HEIGHTS AT FIRST FLOOR.

NOTES:
CROSSHATCHING ON PLAN INDICATES
SUFFICIENTLY BLOCKED FOR
GRAB BARS.

1" FURRDOWN


80" X 48" CLEAR FLOOR SPACE

COORDINATE ALL FURRDOWN LOCATIONS WITH MECHANICAL SHOP DRAWINGS

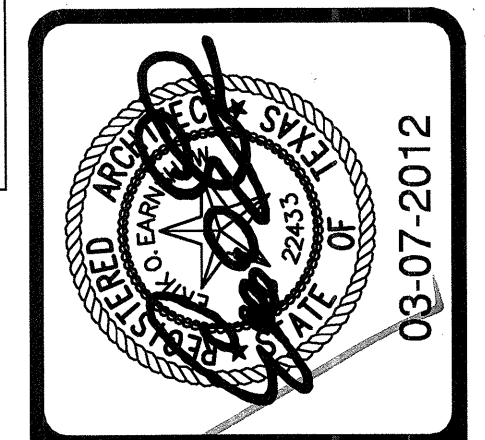


REVISIONS


| | |
|--------------------|------------|
| OWNER COORDINATION | 09-01-2011 |
| ANSI/FHA COMMENTS | 09-13-2011 |
| COORDINATION | 04-17-2012 |

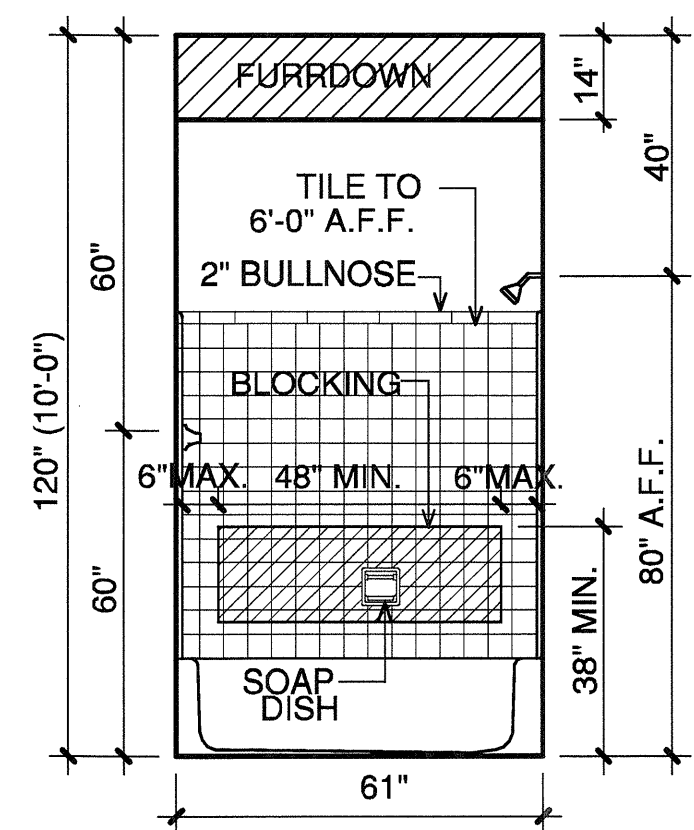


5 BATH #2
SCALE 3/8"=1'-0"

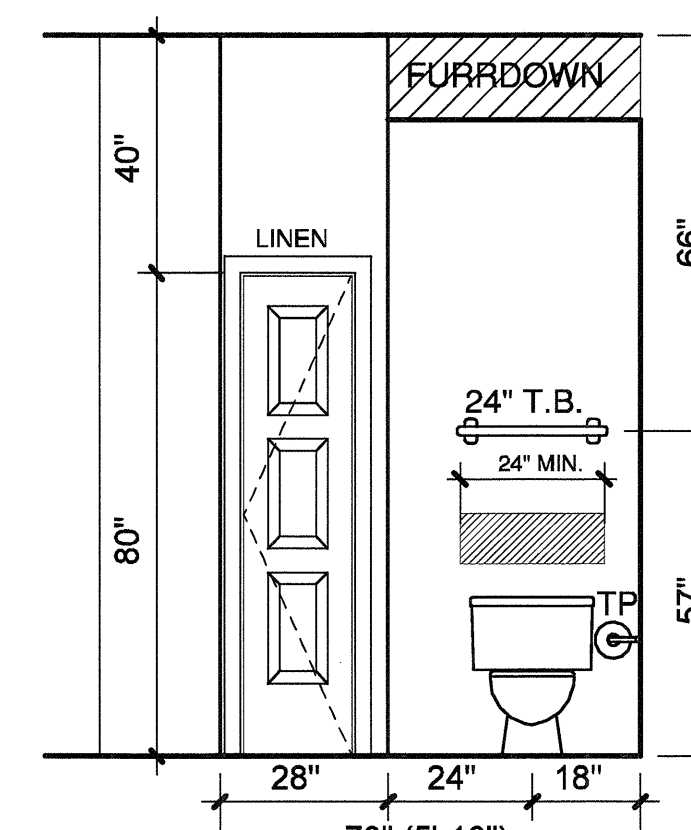


6 BATH #2
SCALE 3/8"=1'-0"

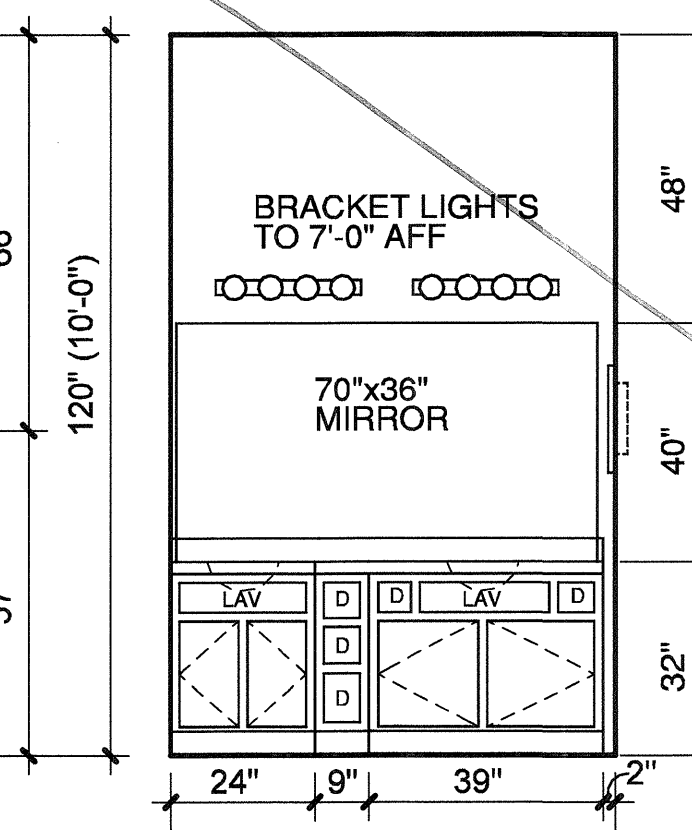


7 BATH #1
SCALE 3/8"=1'-0"

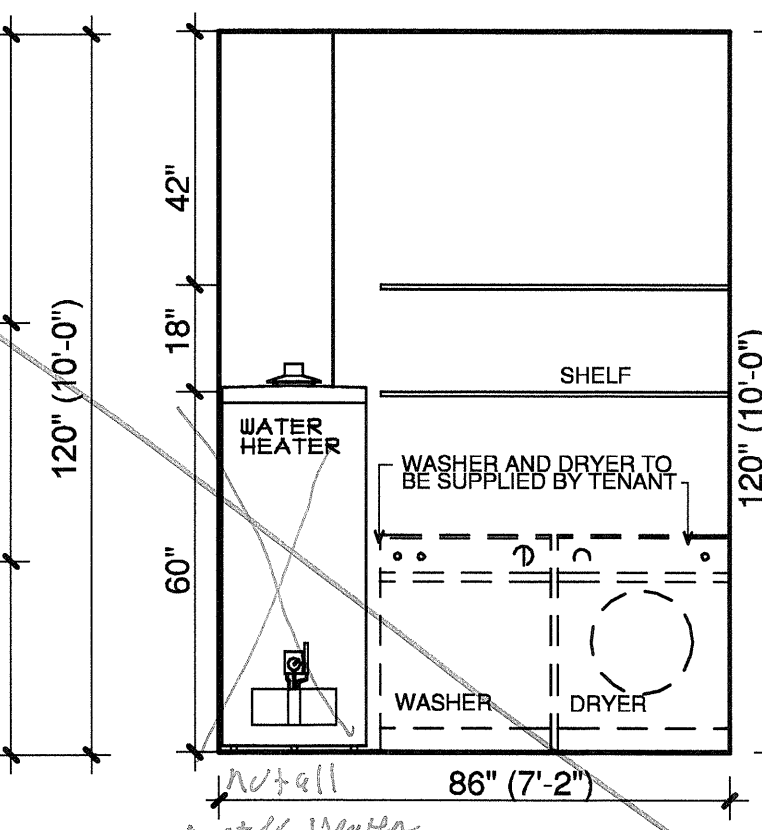


8 UTILITY
SCALE 3/8"=1'-0"

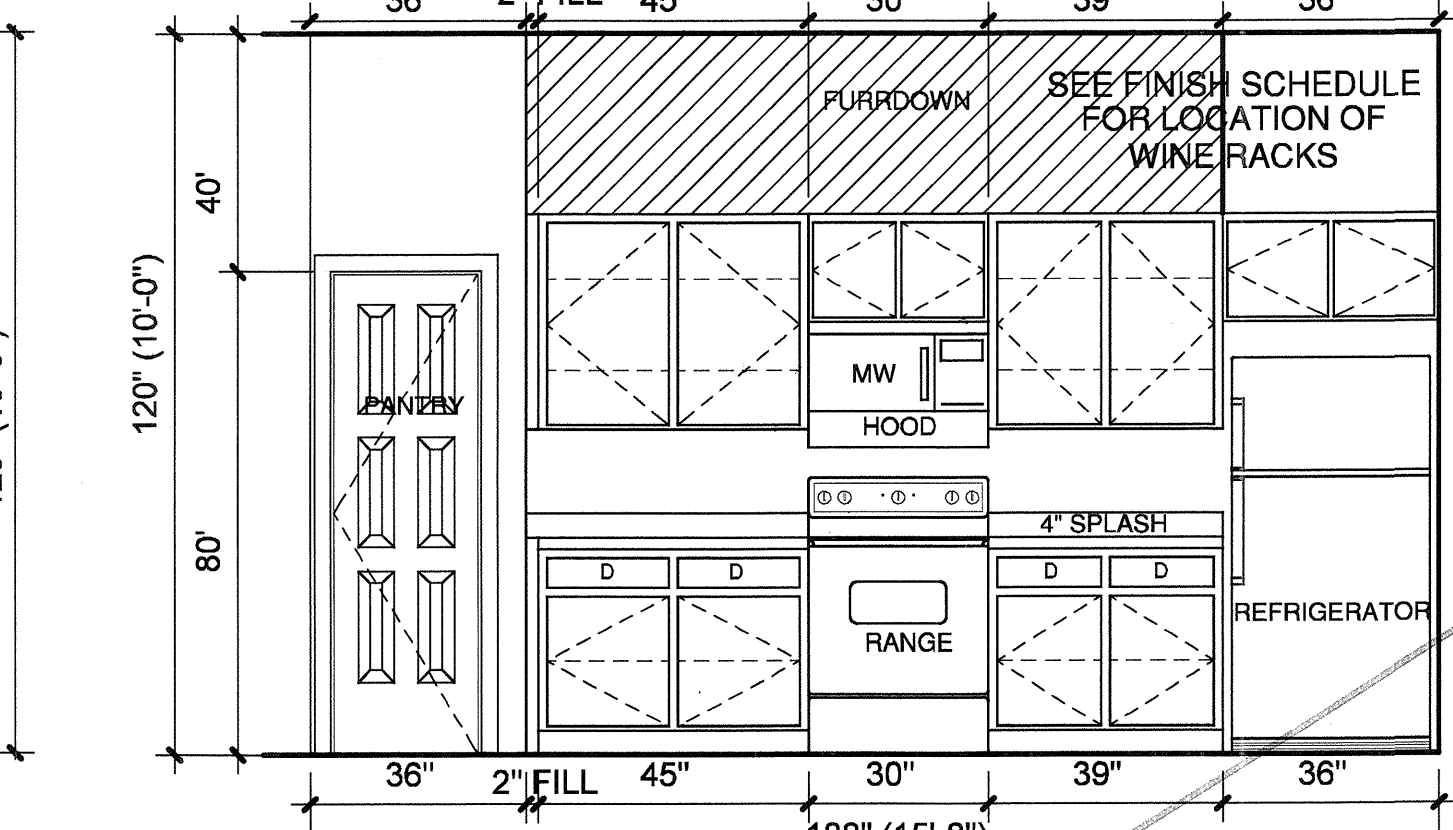


9 KITCHEN
SCALE 3/8"=1'-0"

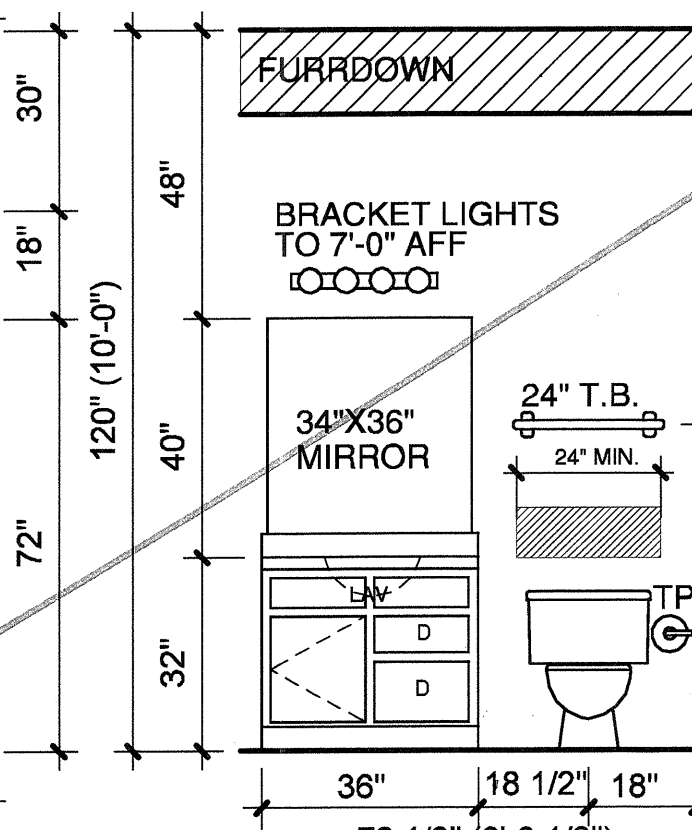

10 BATH #2
SCALE 3/8"=1'-0"

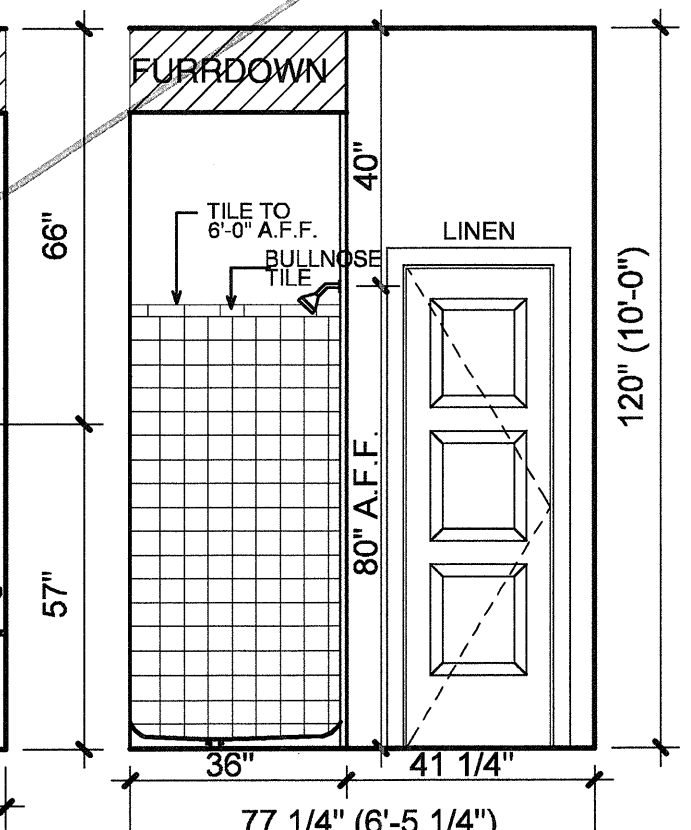


11 BATH
SCALE 3/8"=1'-0"

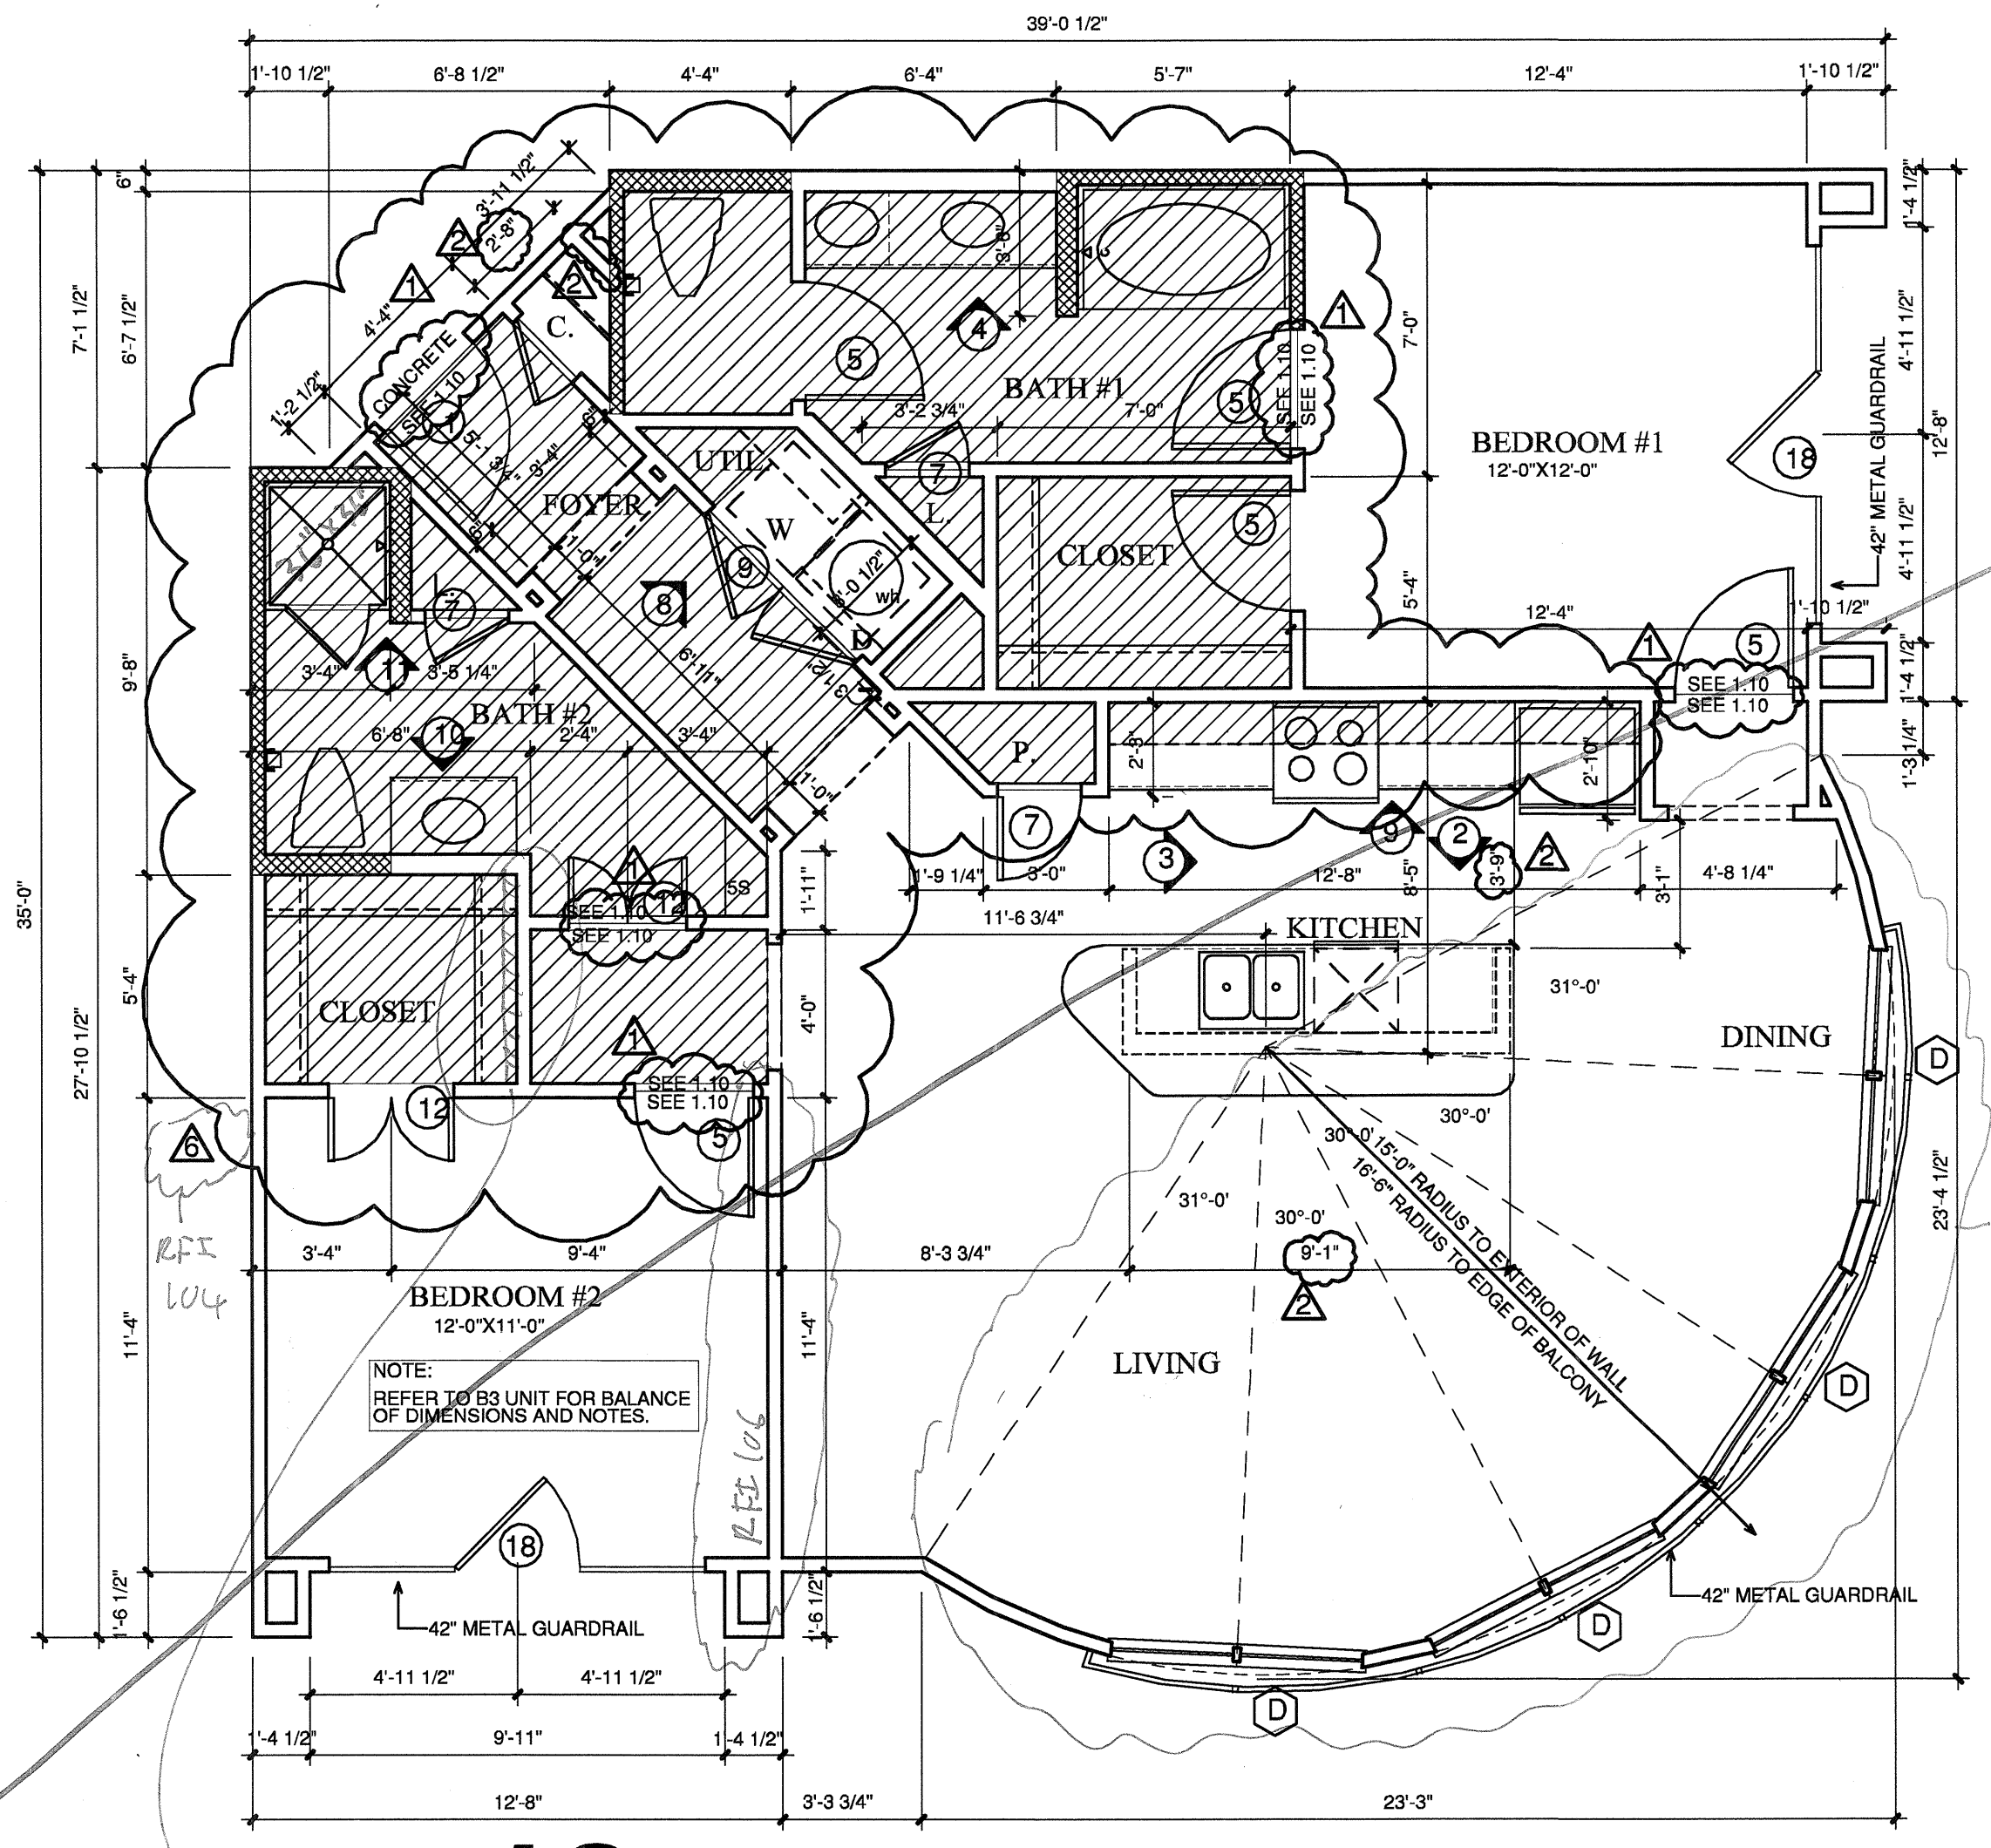

12 ALT A
SCALE 1/4"=1'-0"
1,305 S.F.
OCCURS AT: (3) TOTAL UNITS ON SITE

RFF 126

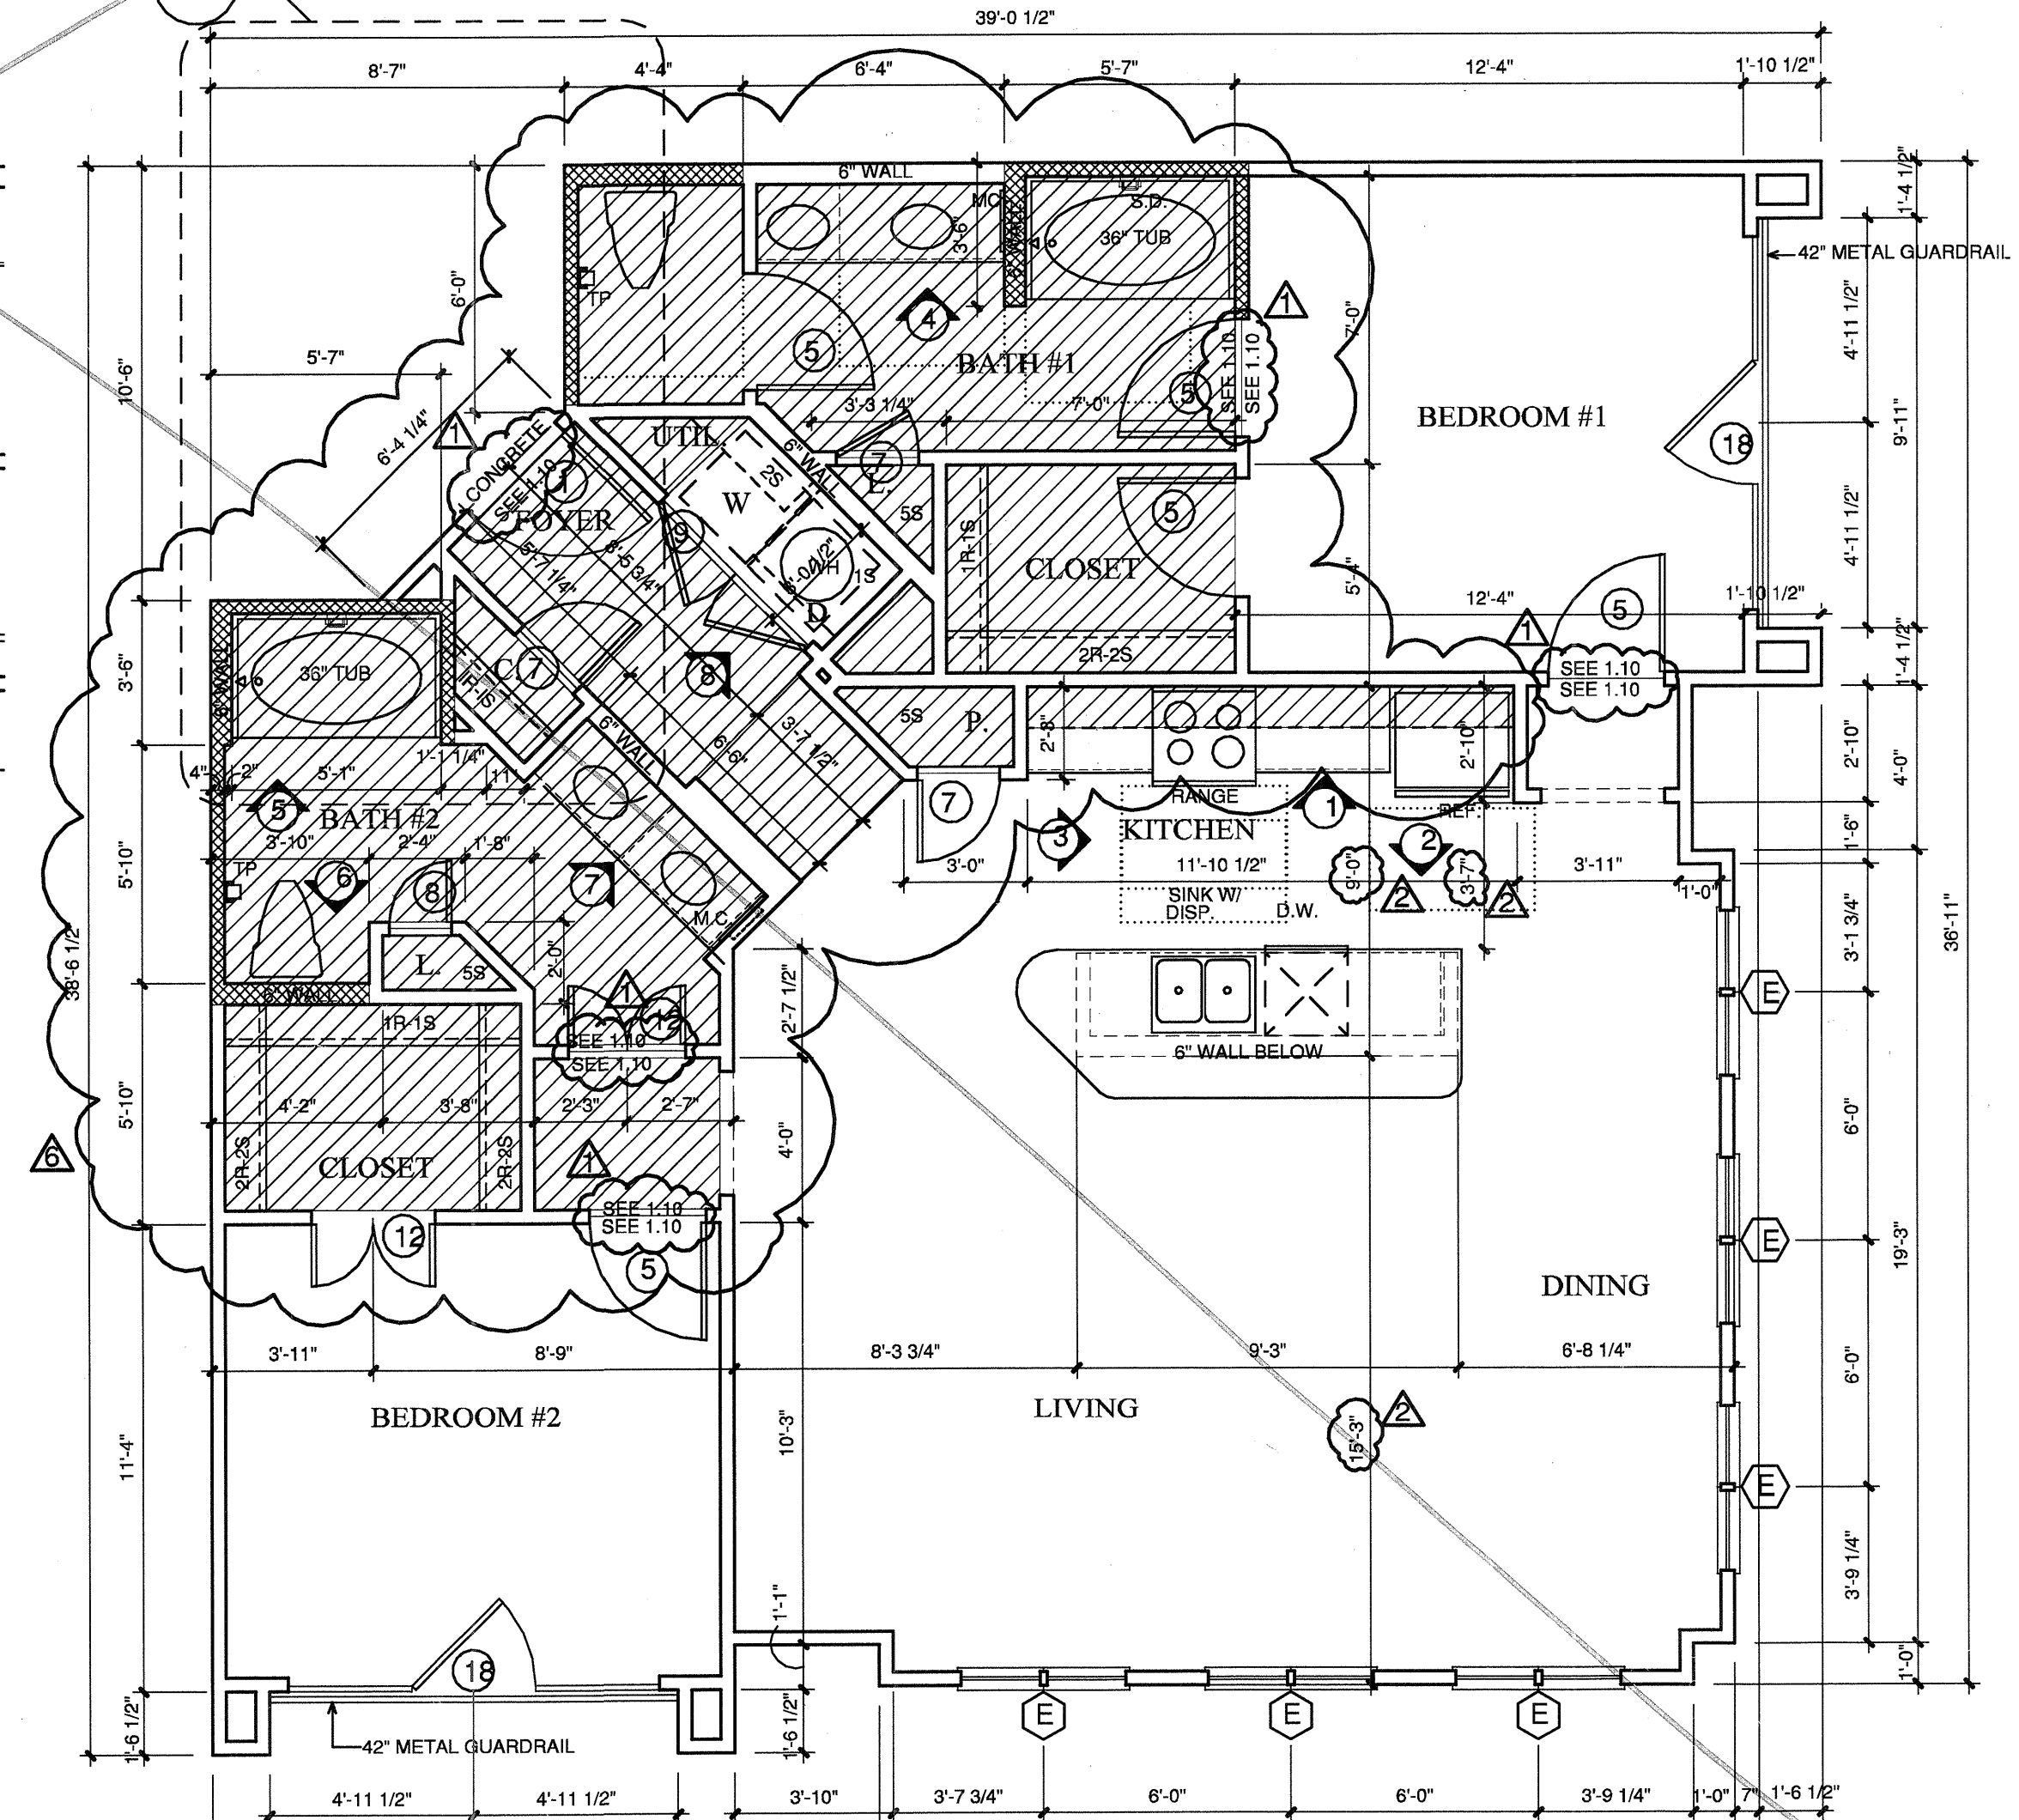

13 ALT B
SCALE 1/4"=1'-0"
1,248 S.F.
OCCURS AT: (3) TOTAL UNITS ON SITE

B3 TWO BEDROOM/TWO BATH
SCALE 1/4"=1'-0"
1,283 S.F.
OCCURS AT: (3) TOTAL UNITS ON SITE

KELLER SPRINGS LOFTS
LOFT APARTMENTS IN ADDISON, TEXAS

CONSTRUCTION ISSUE
10-17-2011

BGO architects
4144 N. Central Expy.
Suite 856
Dallas, TX 75204
214.520.8878
bgoarchitects.com

DATE
08-05-2011

PROJECT
11129

SHEET NUMBER

2.8
B3 UNIT

COPYRIGHT © Beeler Guest Architects All Rights Reserved