


NOTES:
 CEILING HEIGHTS ARE 9'-0" ON THE 2ND, 3RD, AND 4TH FLOORS. REFERENCE SHEET 3.1 FOR VARYING CEILING HEIGHTS AT FIRST FLOOR.

NOTES:
 CROSSHATCHING ON PLAN INDICATES AREAS TO BE SUFFICIENTLY BLOCKED FOR GRAB BARS.
 1" FURRDOWN
 30" X 48" FLOOR SPACE

COORDINATE ALL FURRDOWN LOCATIONS WITH MECHANICAL SHOP DRAWINGS




REVISIONS
 OWNER COORDINATION 09-01-2011
 ANS/FHA COMMENTS 09-13-2011
 COORDINATION 04-17-2012
 RFI - 0149 07-05-2012

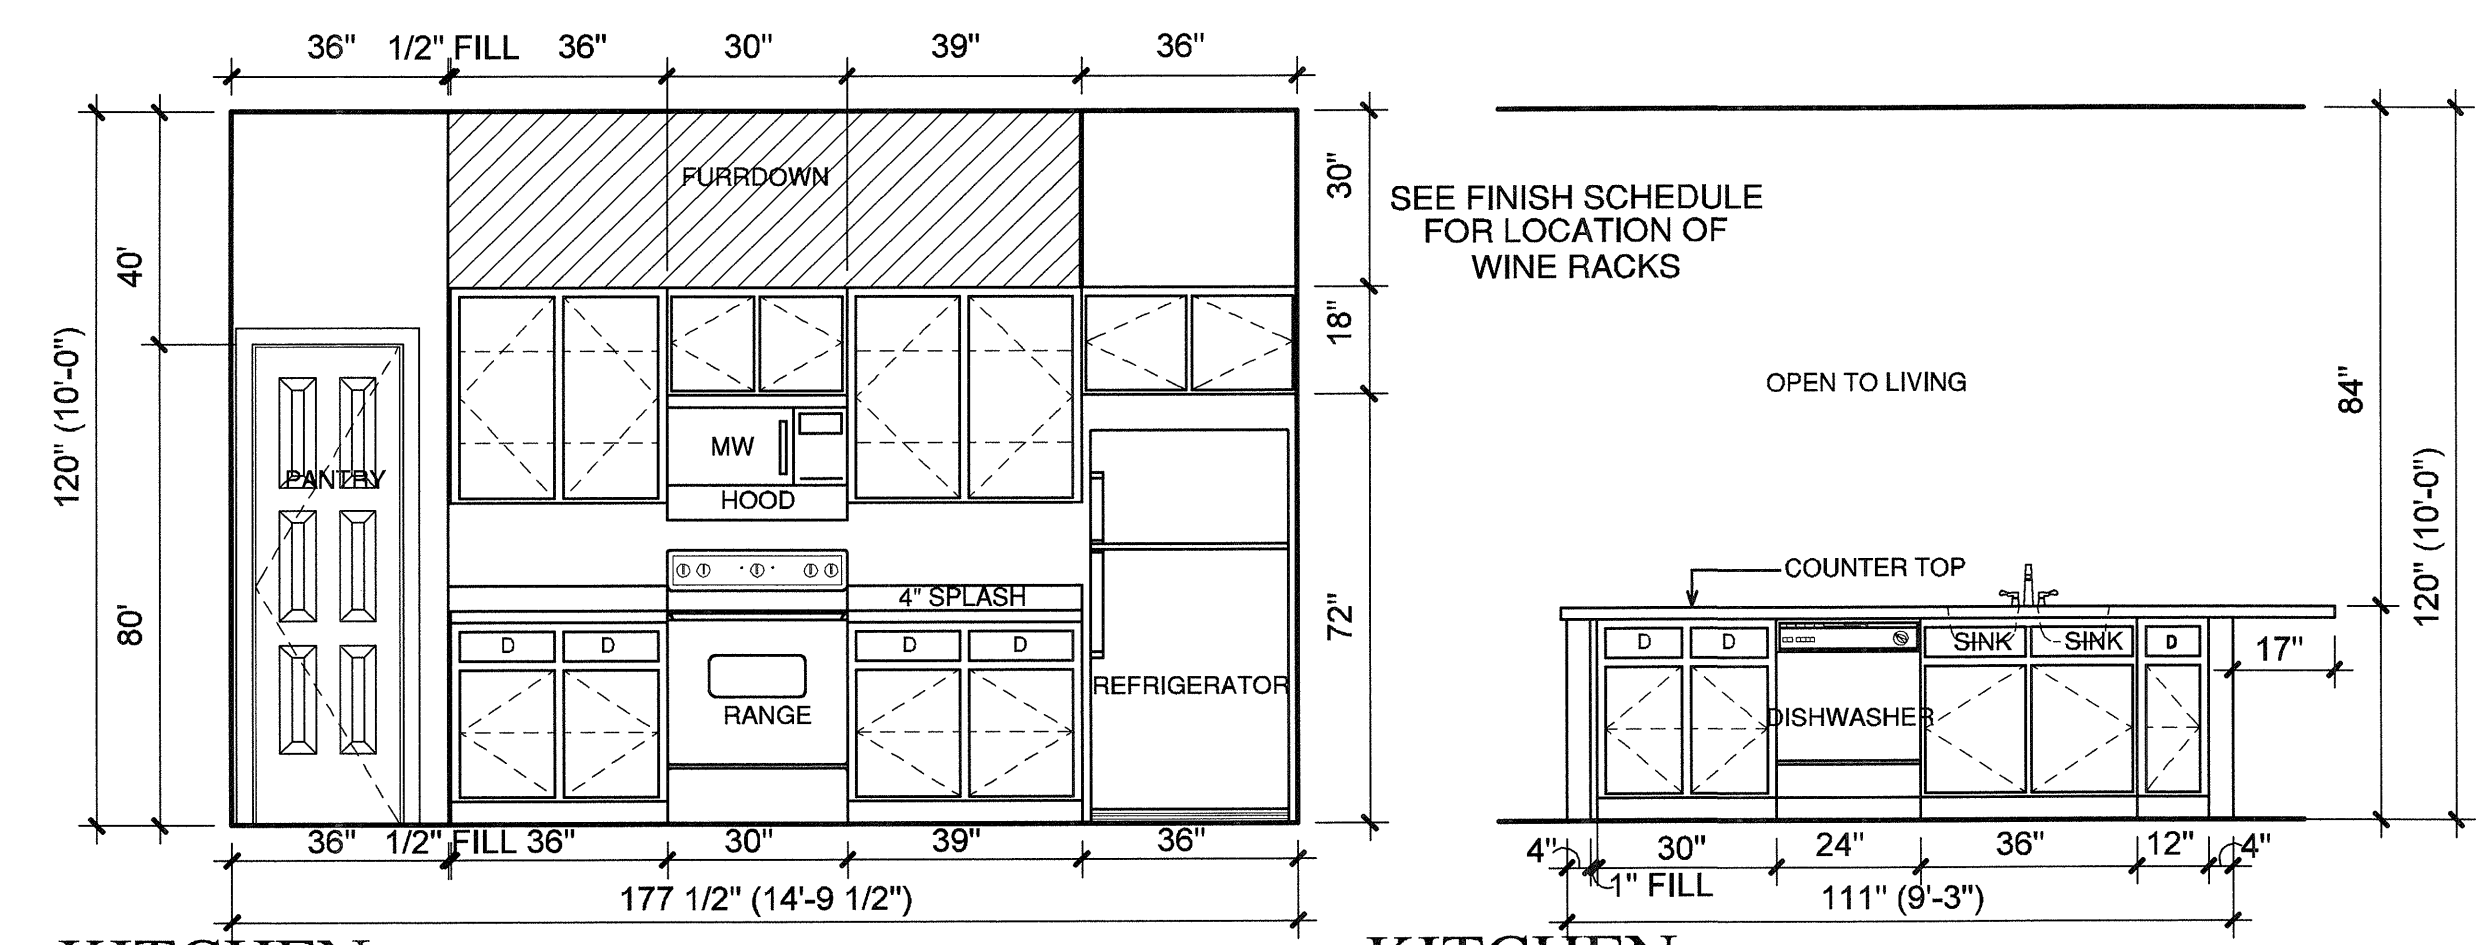


1 KITCHEN
 SCALE 3/8"=1'-0"


2 KITCHEN
 SCALE 3/8"=1'-0"

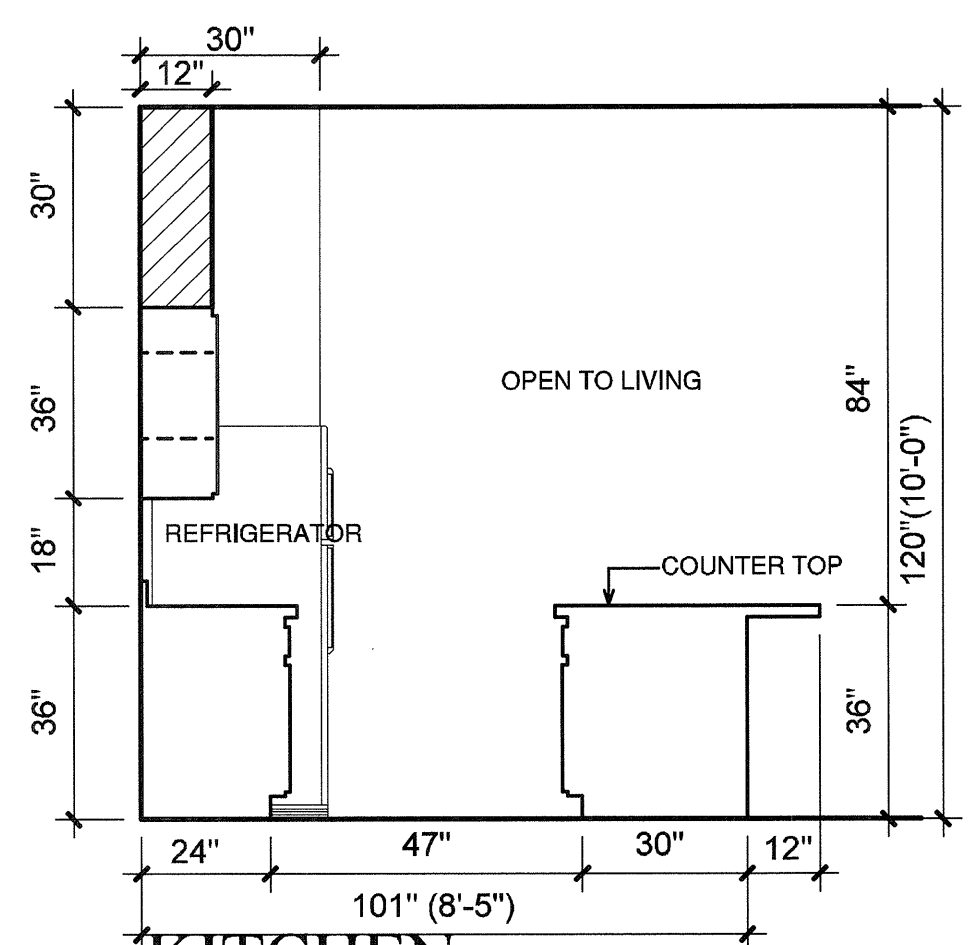


3 KITCHEN
 SCALE 3/8"=1'-0"

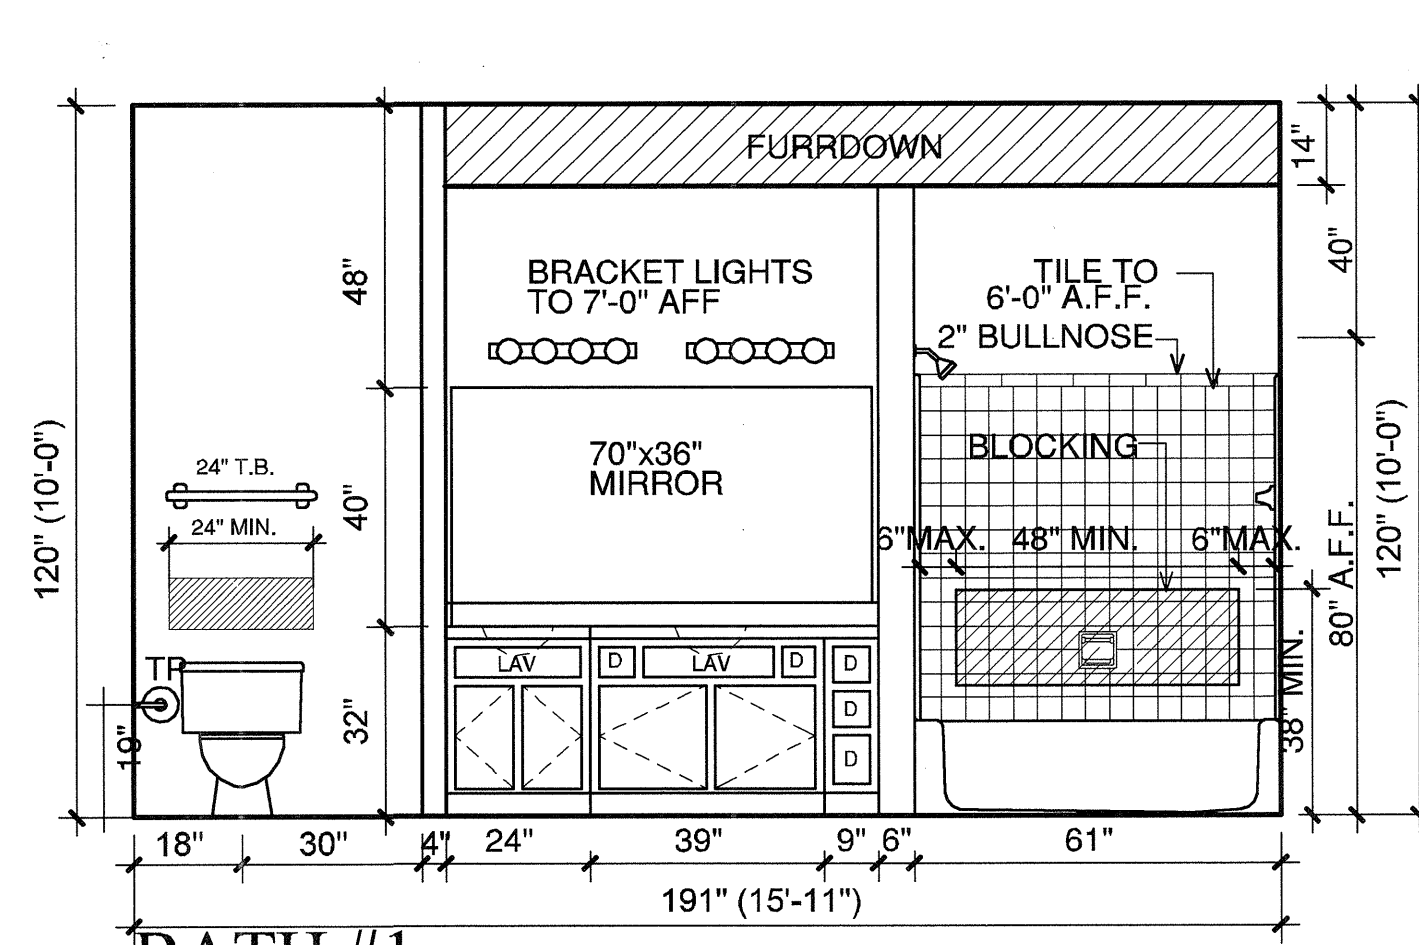


4 BATH #1
 SCALE 3/8"=1'-0"

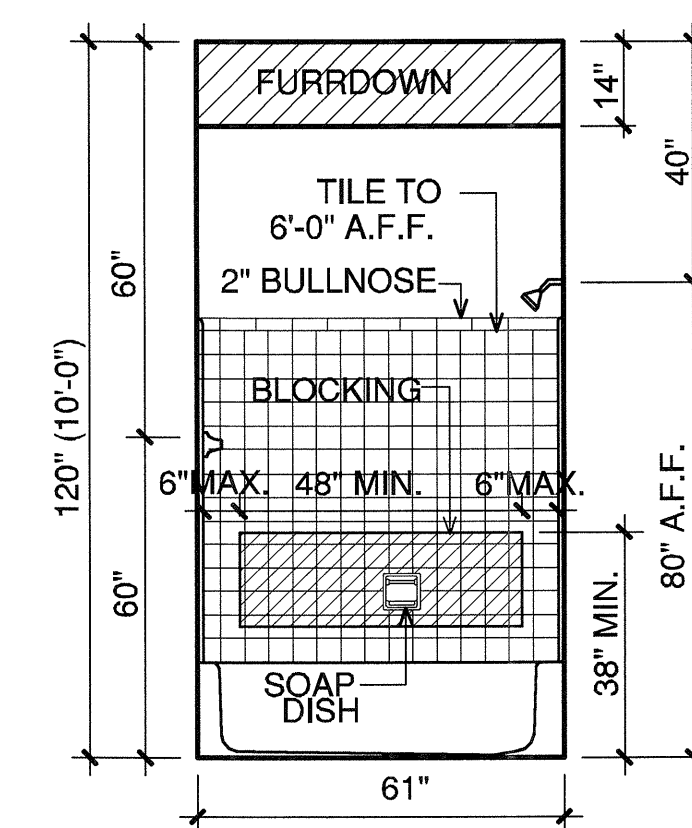


5 BATH #2
 SCALE 3/8"=1'-0"

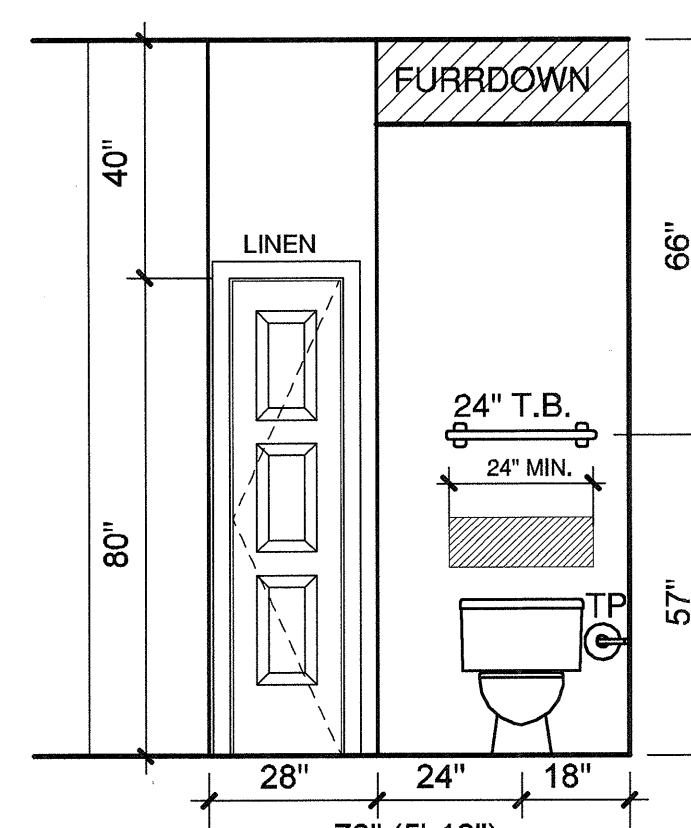


6 BATH #2
 SCALE 3/8"=1'-0"

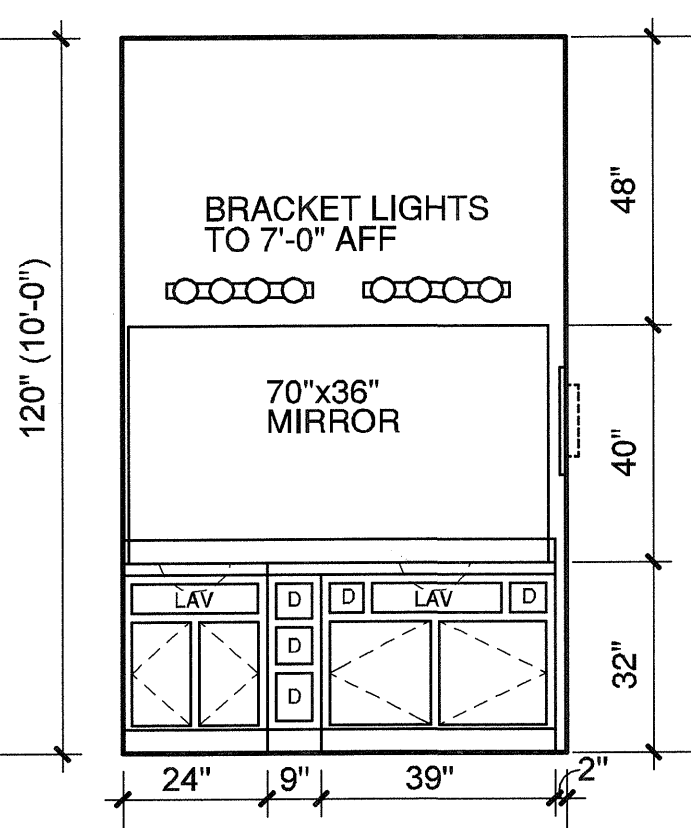


7 BATH #1
 SCALE 3/8"=1'-0"

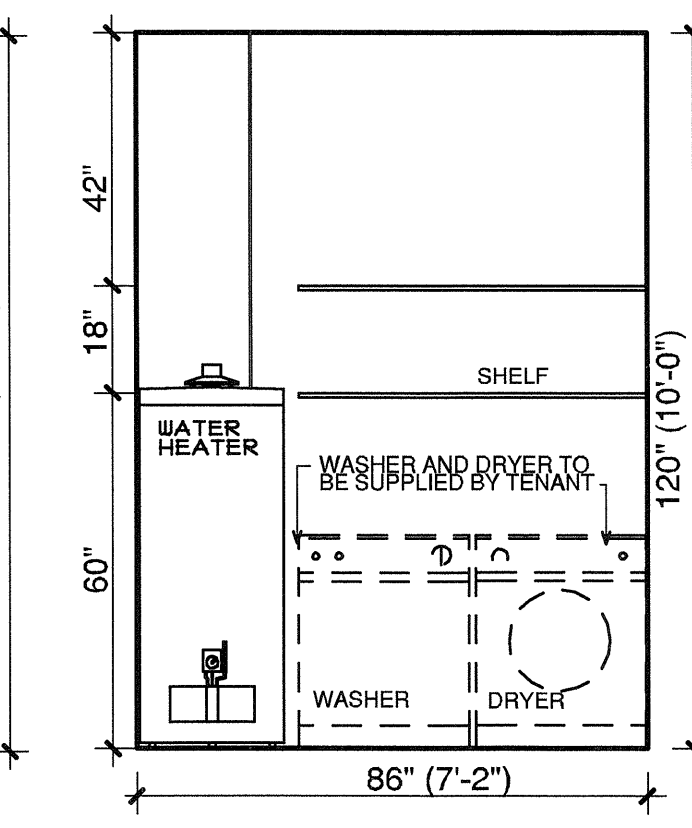


8 UTILITY
 SCALE 3/8"=1'-0"

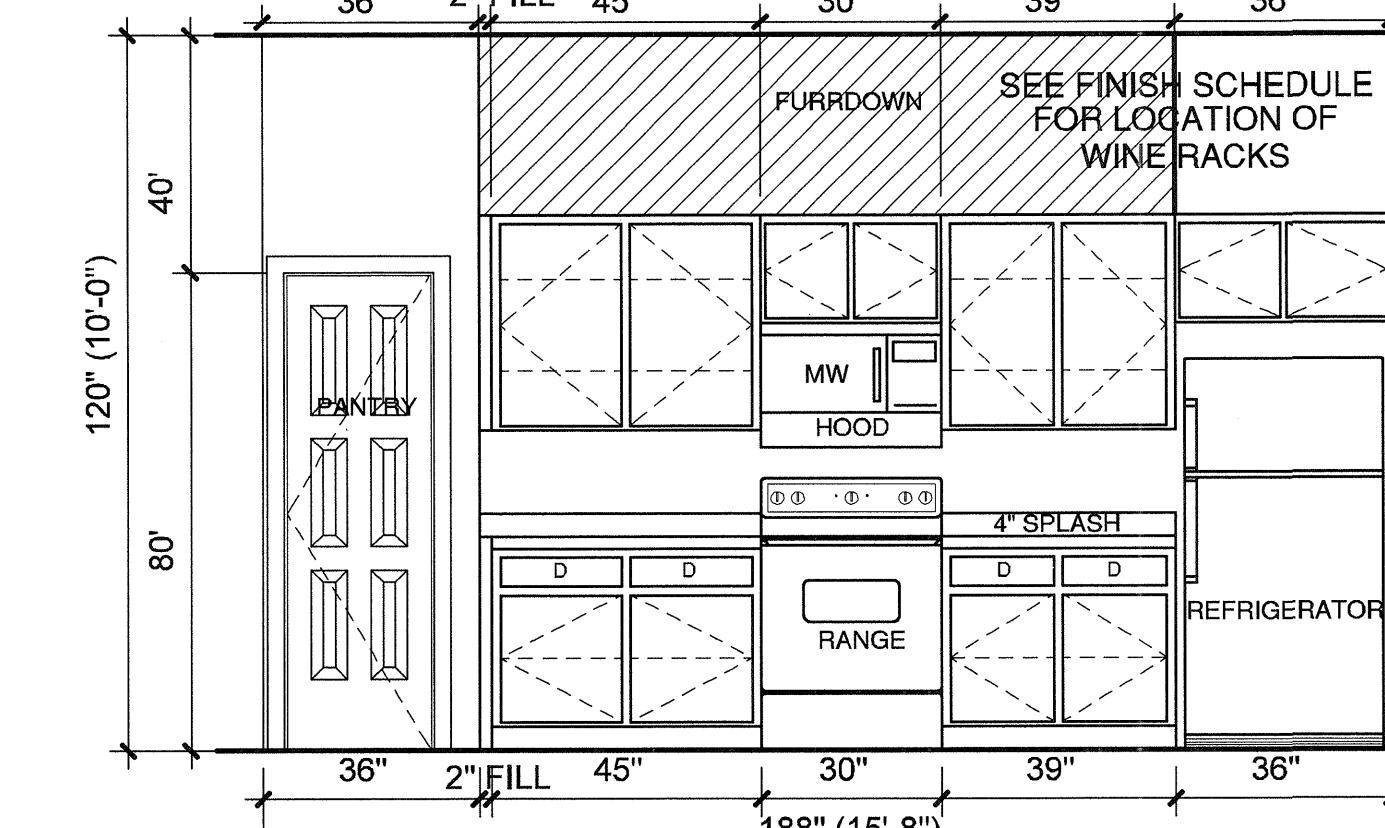


9 KITCHEN
 SCALE 3/8"=1'-0"

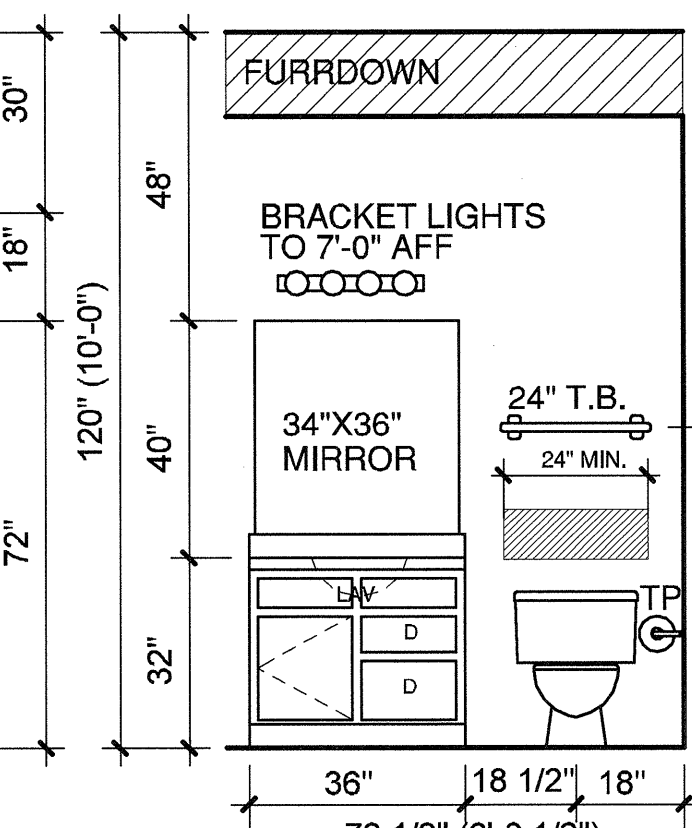

10 BATH #2
 SCALE 3/8"=1'-0"

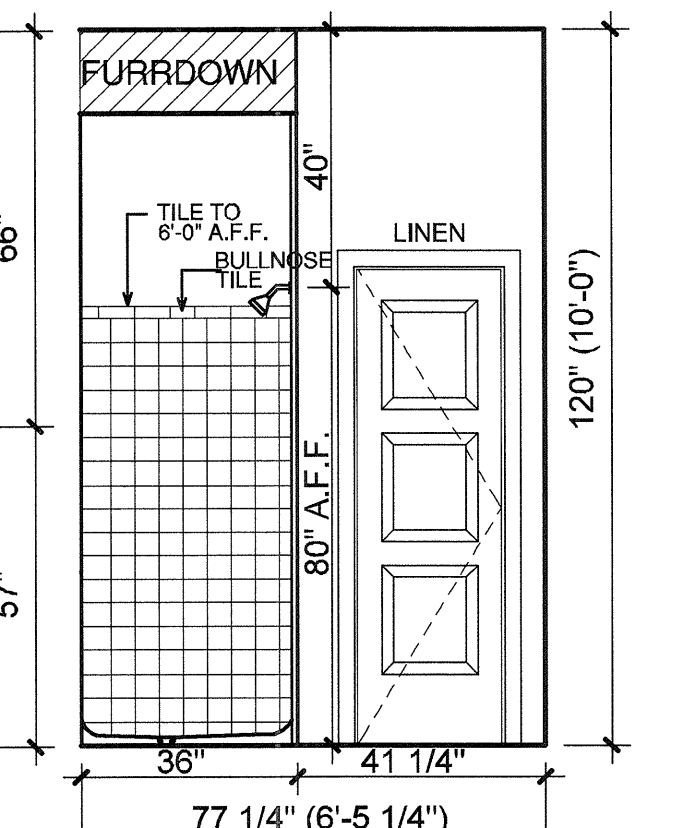


11 BATH
 SCALE 3/8"=1'-0"

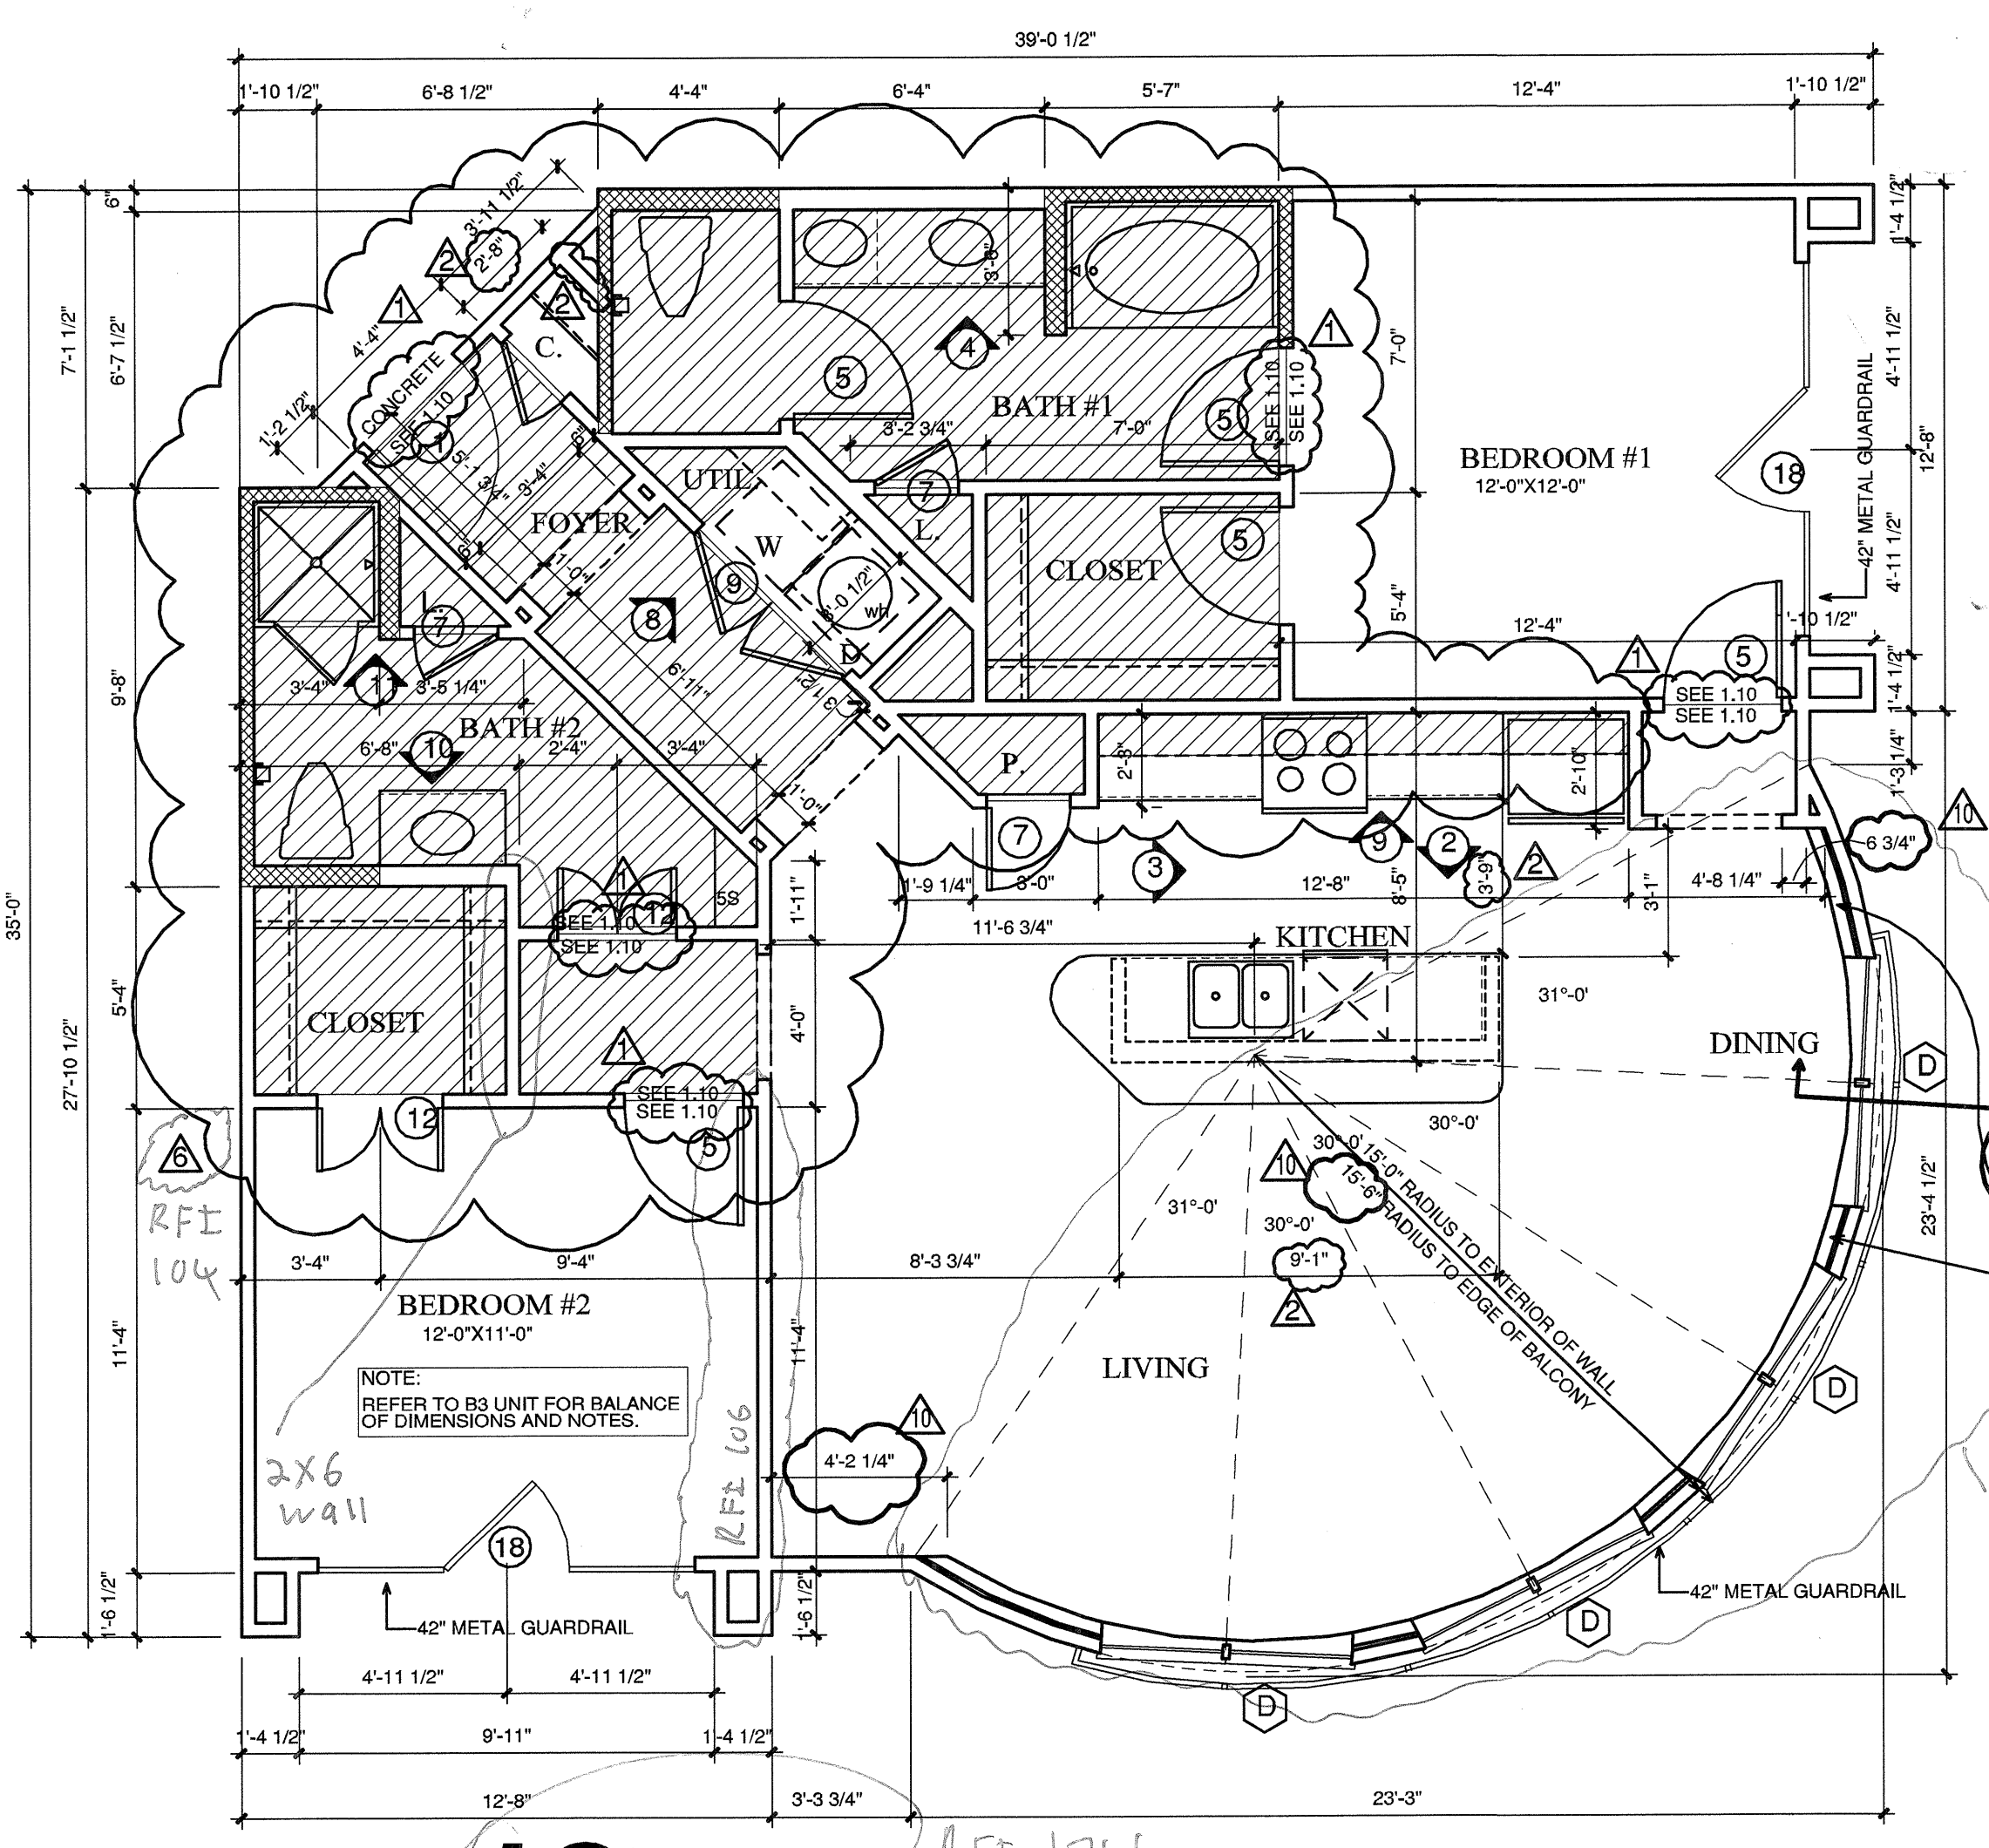


13 ALT B
 SCALE 1/4"=1'-0"

1,248 S.F.
 OCCURS AT: (3) TOTAL UNITS ON SITE

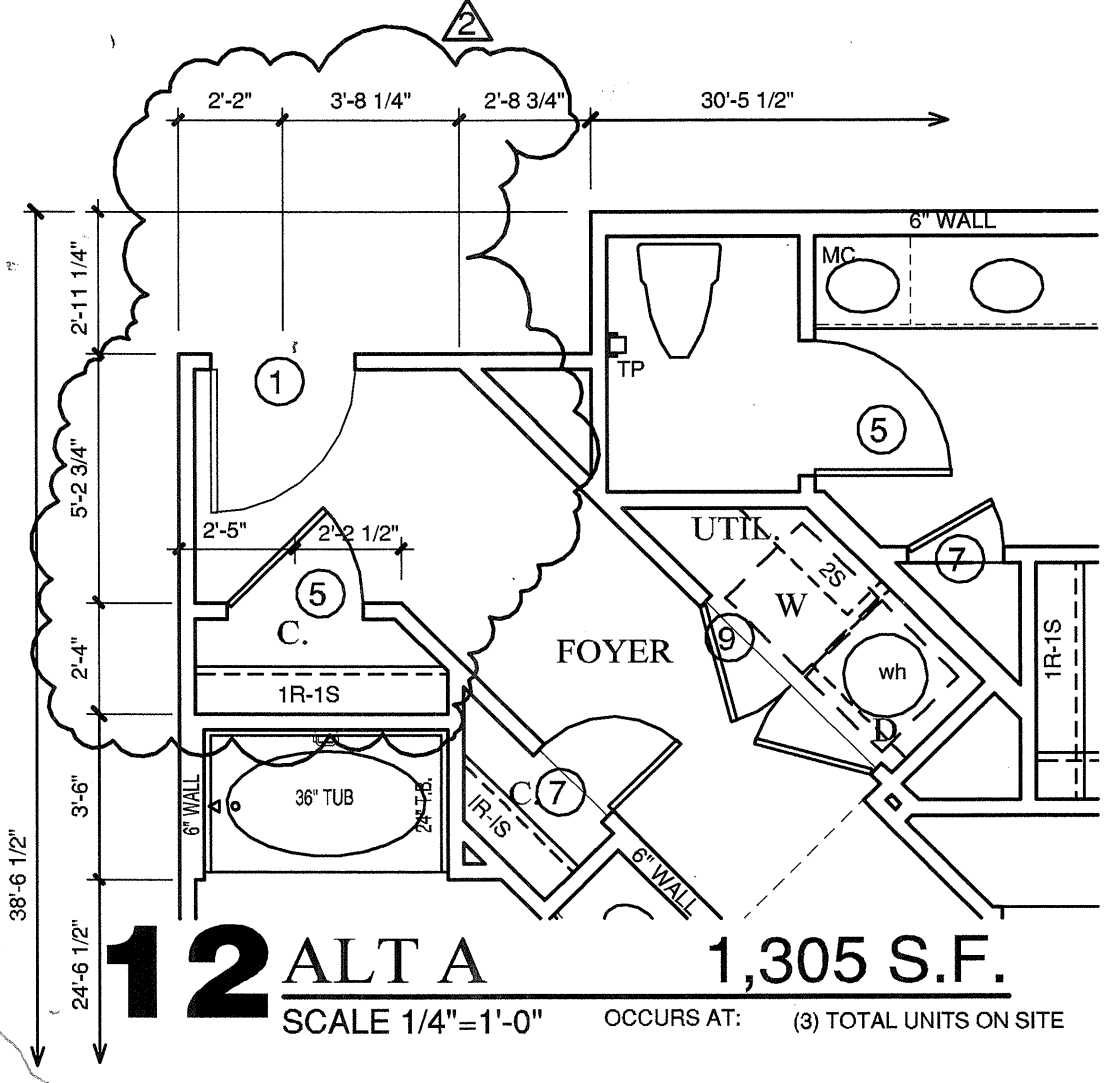

12 ALT A
 SCALE 1/4"=1'-0"

1,305 S.F.
 OCCURS AT: (3) TOTAL UNITS ON SITE

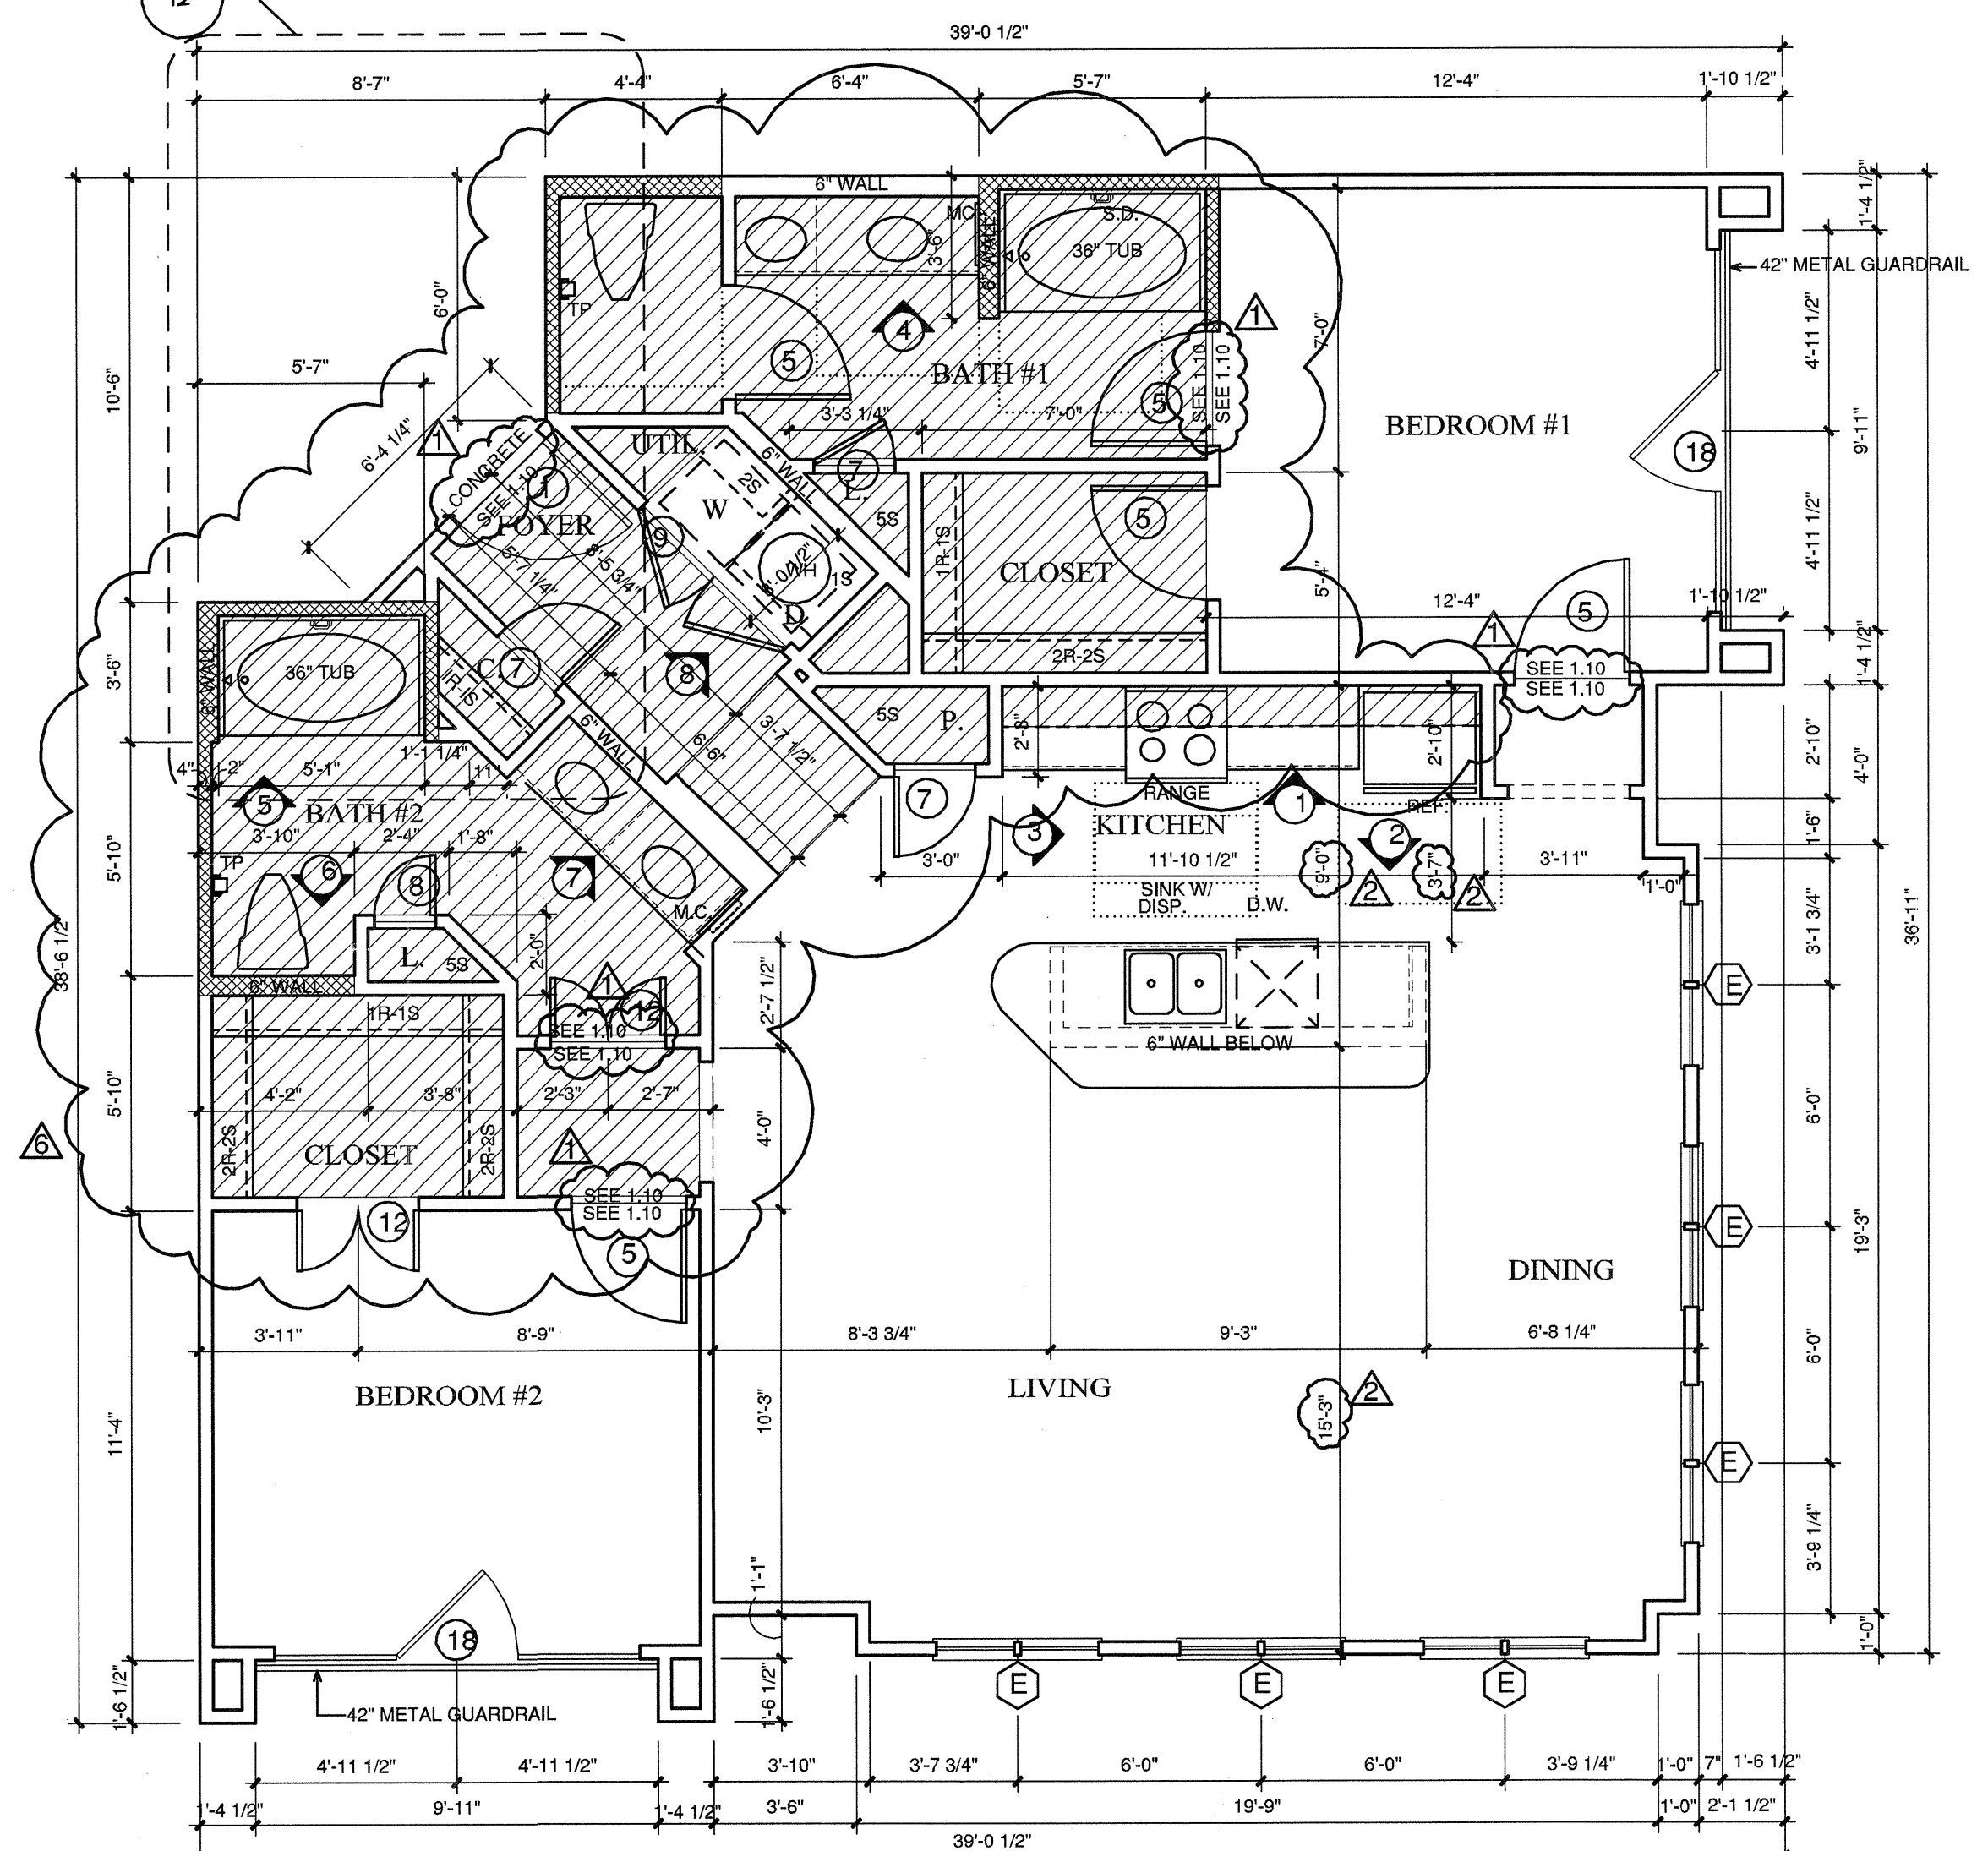

B3 TWO BEDROOM/TWO BATH
 SCALE 1/4"=1'-0"

1,283 S.F.
 OCCURS AT: (3) TOTAL UNITS ON SITE

KELLER SPRINGS LOFTS
 LOFT APARTMENTS IN ADDISON, TEXAS

CONSTRUCTION ISSUE
 10-17-2011

BGO architects
 4144 N. Central Expy. Suite 855
 Dallas, TX 75204
 214.520.8878
 bgoarchitects.com

DATE
08-05-2011
 PROJECT
11129
 SHEET NUMBER

2.8
B3 UNIT

COPYRIGHT © Beeler, Guest Owens Architects ALL RIGHTS RESERVED