



| REVISIONS | |
|--------------------|------------|
| OWNER COORDINATION | 09-01-2011 |
| ANSI/FHA COMMENTS | 09-13-2011 |

KELLER SPRINGS LOFTS

LOFT APARTMENTS IN ADDISON, TEXAS

CONSTRUCTION ISSUE
10-17-2011


BGO architects
4144 N. Central Expy.
Suite 855
Dallas, TX 75204
214.520.8878
bgoarchitects.com

DATE
08-05-2011

PROJECT
11129

SHEET NUMBER

2.8A
B3 UNIT

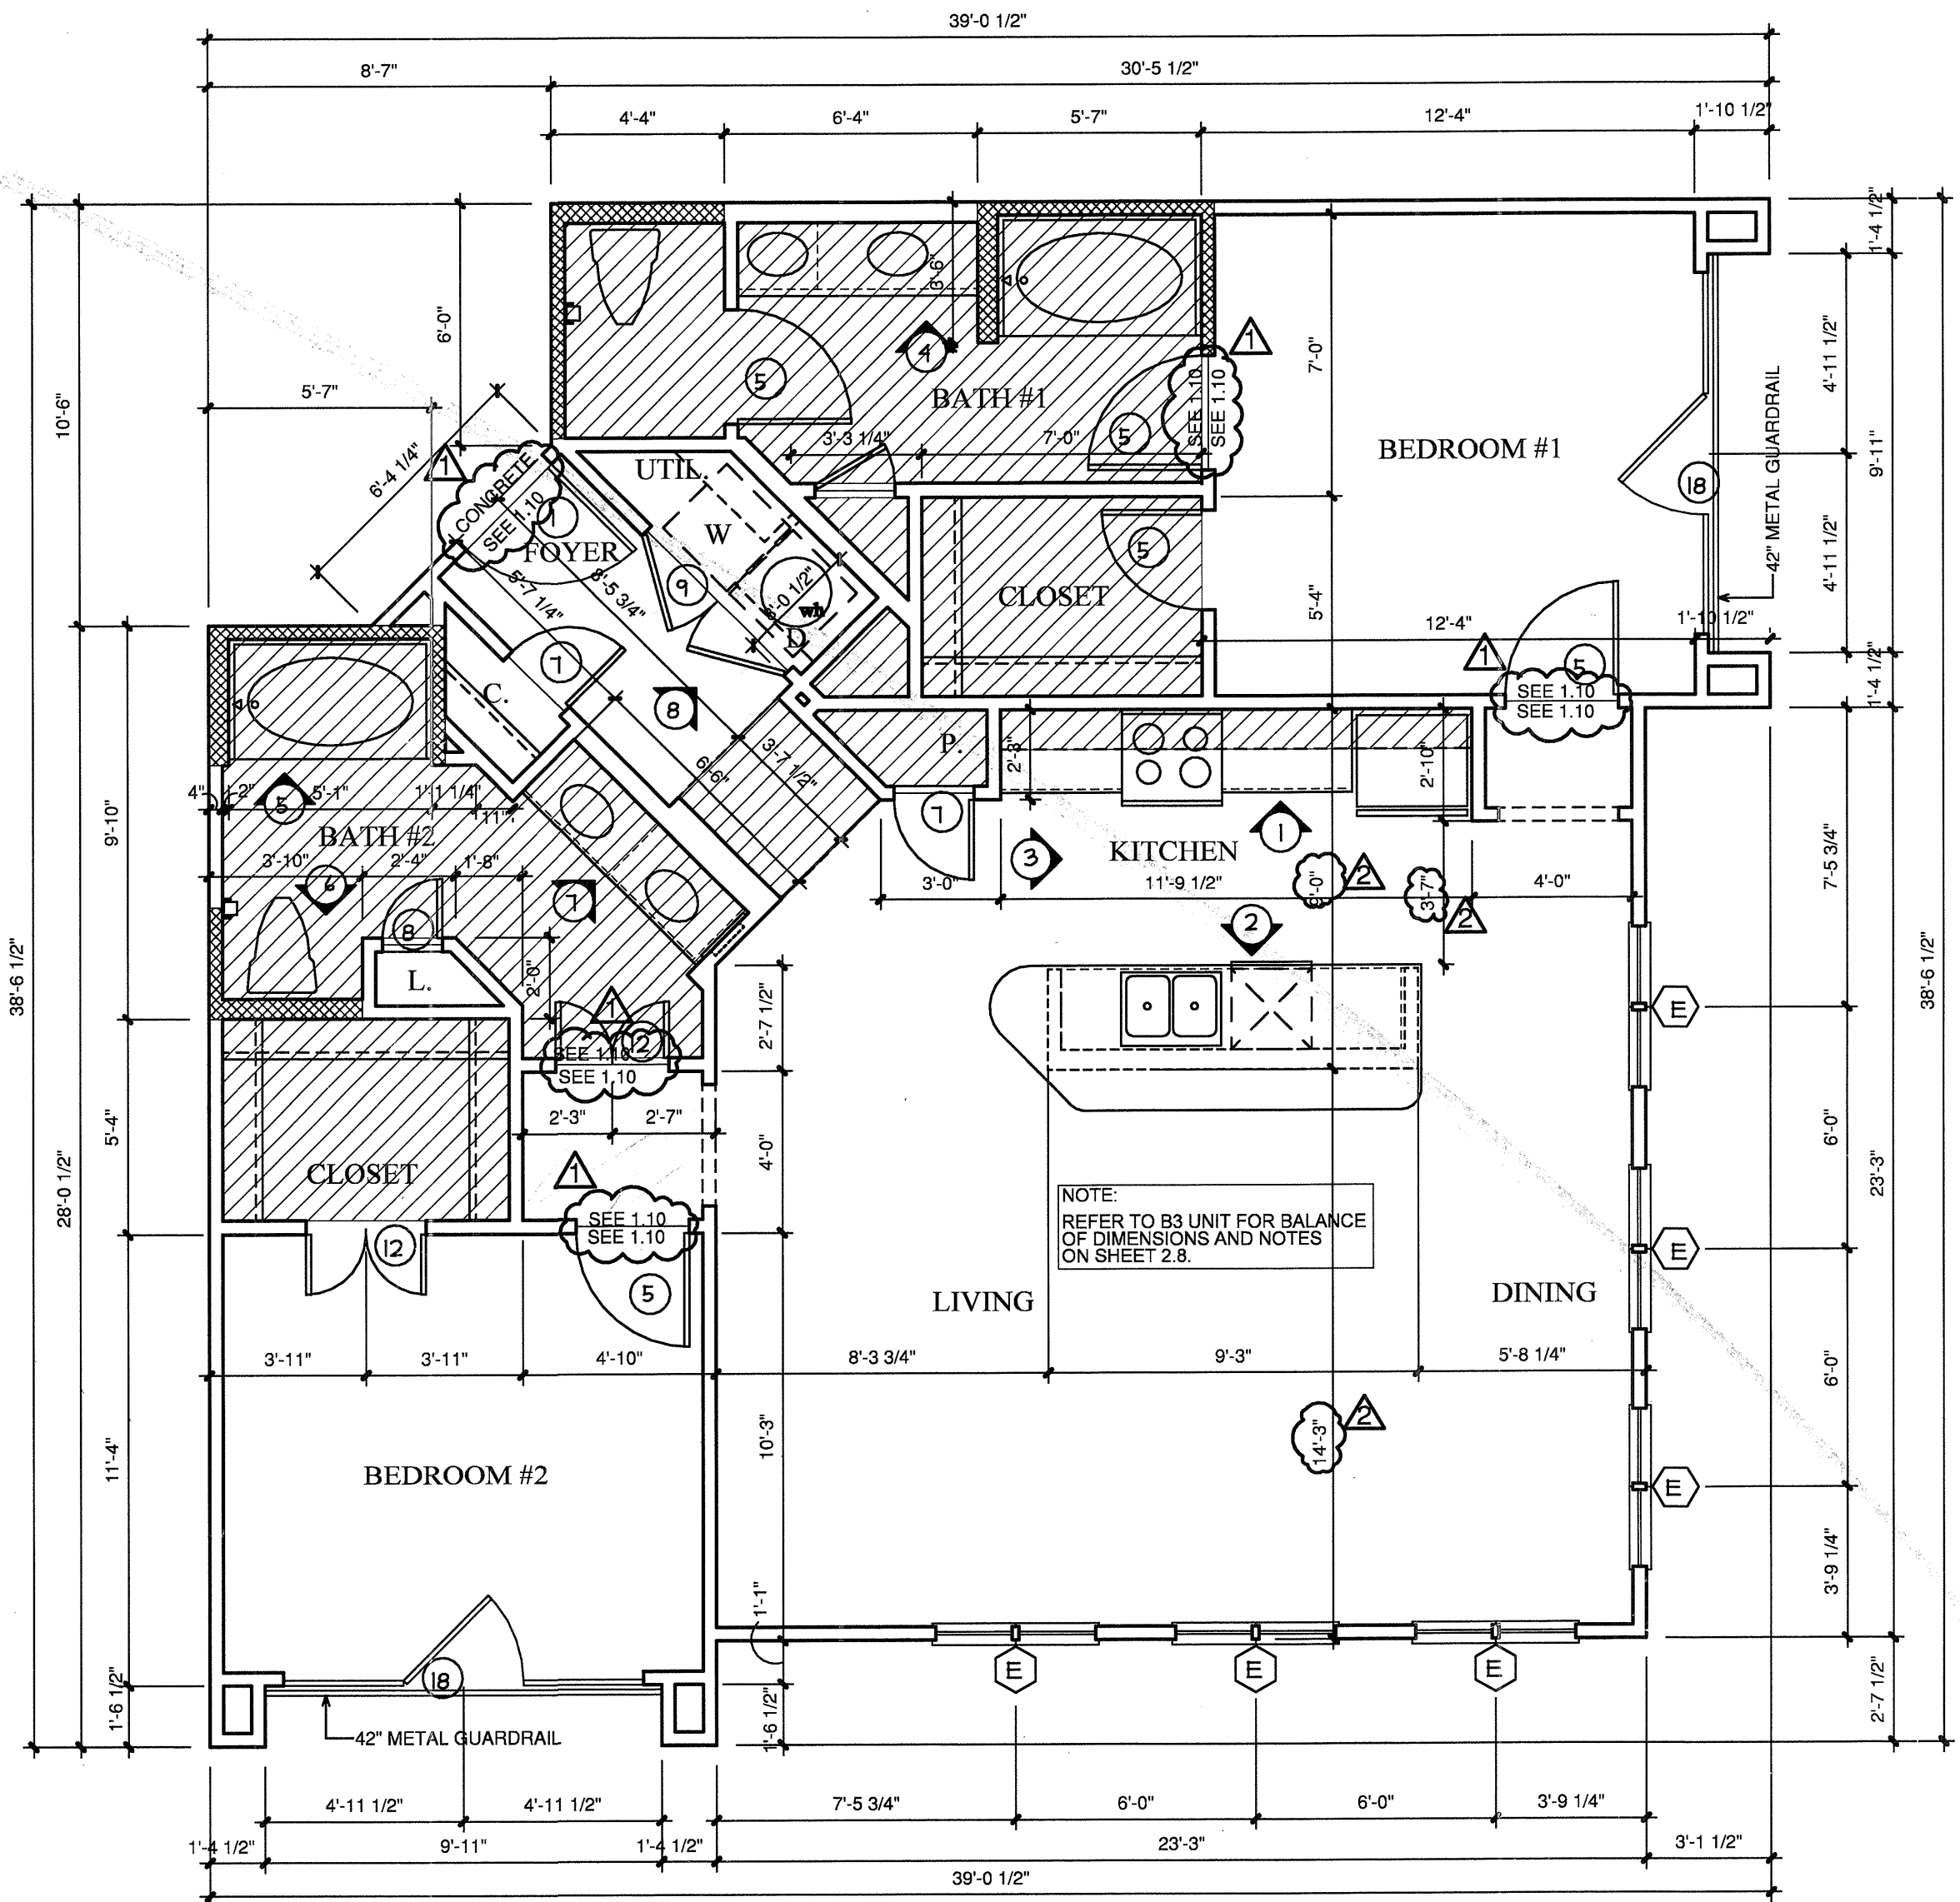

B3 TWO BEDROOM/TWO BATH (ALTC) 1,243 S.F.
SCALE 1/4"=1'-0" OCCURS AT: (1) TOTAL UNITS ON SITE

COPYRIGHT © Beeler Guest Owens Architects ALL RIGHTS RESERVED