


**1** DIVISION 'B' FIRST FLOOR PLAN  
1/8"=1'-0"

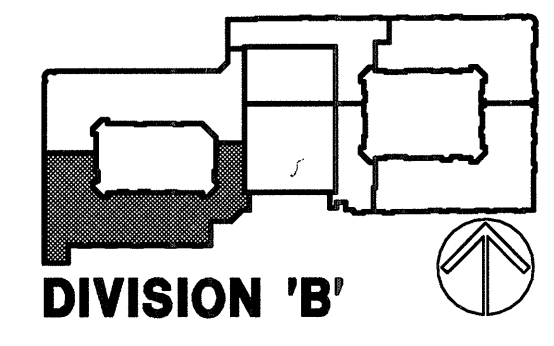


**BGO**  
architects  
4144 N. Central Expy.  
Suite 855  
Dallas, TX 75204  
214.520.8878  
bgoarchitects.com

CONSTRUCTION ISSUE  
10-17-2011

REVISIONS  
 △ ANS/FHA COMMENTS  
09-13-2011  
 △ COORDINATION  
10-17-2011

**KELLER SPRINGS LOFTS**  
LOFT APARTMENTS IN ADDISON, TEXAS

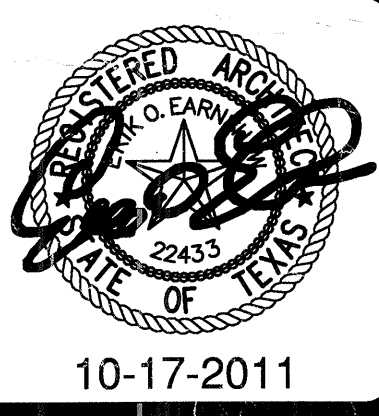

COPYRIGHT © Beiler Guest Owens Architects ALL RIGHTS RESERVED  
 DATE  
08-05-2011  
 PROJECT  
11129

SHEET NUMBER  
**3.1B**  
BLDG PLAN 'B'