


NOTE:  
 ALL PATIO GUARD RAILS  
 TO BE 48" ABOVE PATIO F.F.  
 ALL 1ST FLOOR WINDOWS  
 PROTECTION REF. TO 1/2.0A

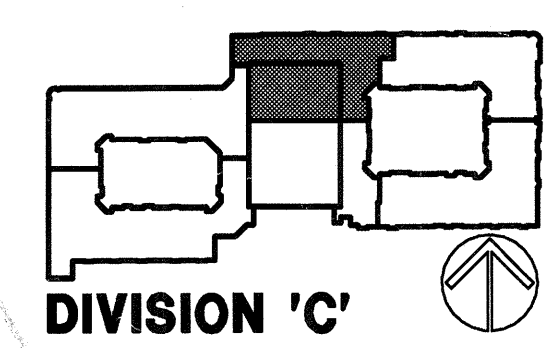

**BGO**  
 architects

4144 N. Central Expy.  
 Suite 855  
 Dallas, TX 75204  
 214.520.8878  
 bgoarchitects.com

CONSTRUCTION ISSUE  
 10-17-2011

REVISIONS

COORDINATION	10-17-2011
GARAGE REVISIONS PER SHOP DWGS	01-03-2012

**KELLER SPRINGS LOFTS**

LOFT APARTMENTS IN ADDISON, TEXAS

REGISTERED ARCHITECT  
 STATE OF TEXAS  
 22433

01-03-2012

DATE  
 08-05-2011

PROJECT  
 11129

SHEET NUMBER  
**3.1C**

BLDG PLAN 'C'

**1** DIVISION 'C' FIRST FLOOR PLAN  
 1/8"=1'-0"