


NOTE:
 ALL PATIO GUARD RAILS
 TO BE 48" ABOVE PATIO F.F.
 ALL 1ST FLOOR WINDOWS
 PROTECTION REF. TO 1/2.0A

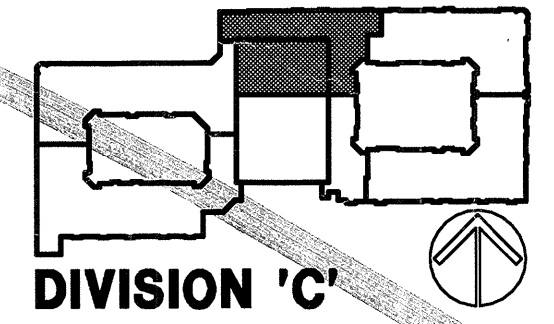

DIVISION 'C'

COPYRIGHT © Beeler Guest Owens Architects. ALL RIGHTS RESERVED.

1 DIVISION 'C' FIRST FLOOR PLAN
 1/8" = 1'-0"

BGO
 architects

4144 N. Central Expy.
 Suite 855
 Dallas, TX 75204
 214.520.8878
 bgoarchitects.com

CONSTRUCTION ISSUE
 10-17-2011

REVISIONS

△	COORDINATION	10-17-2011
---	--------------	------------

KELLER SPRINGS LOFTS

LOFT APARTMENTS IN ADDISON, TEXAS



DATE	08-05-2011
PROJECT	11129
	10-17-2011

SHEET NUMBER	3.1C
BLDG PLAN 'C'	