



3
4.1

RFD 2.00 see two pages back

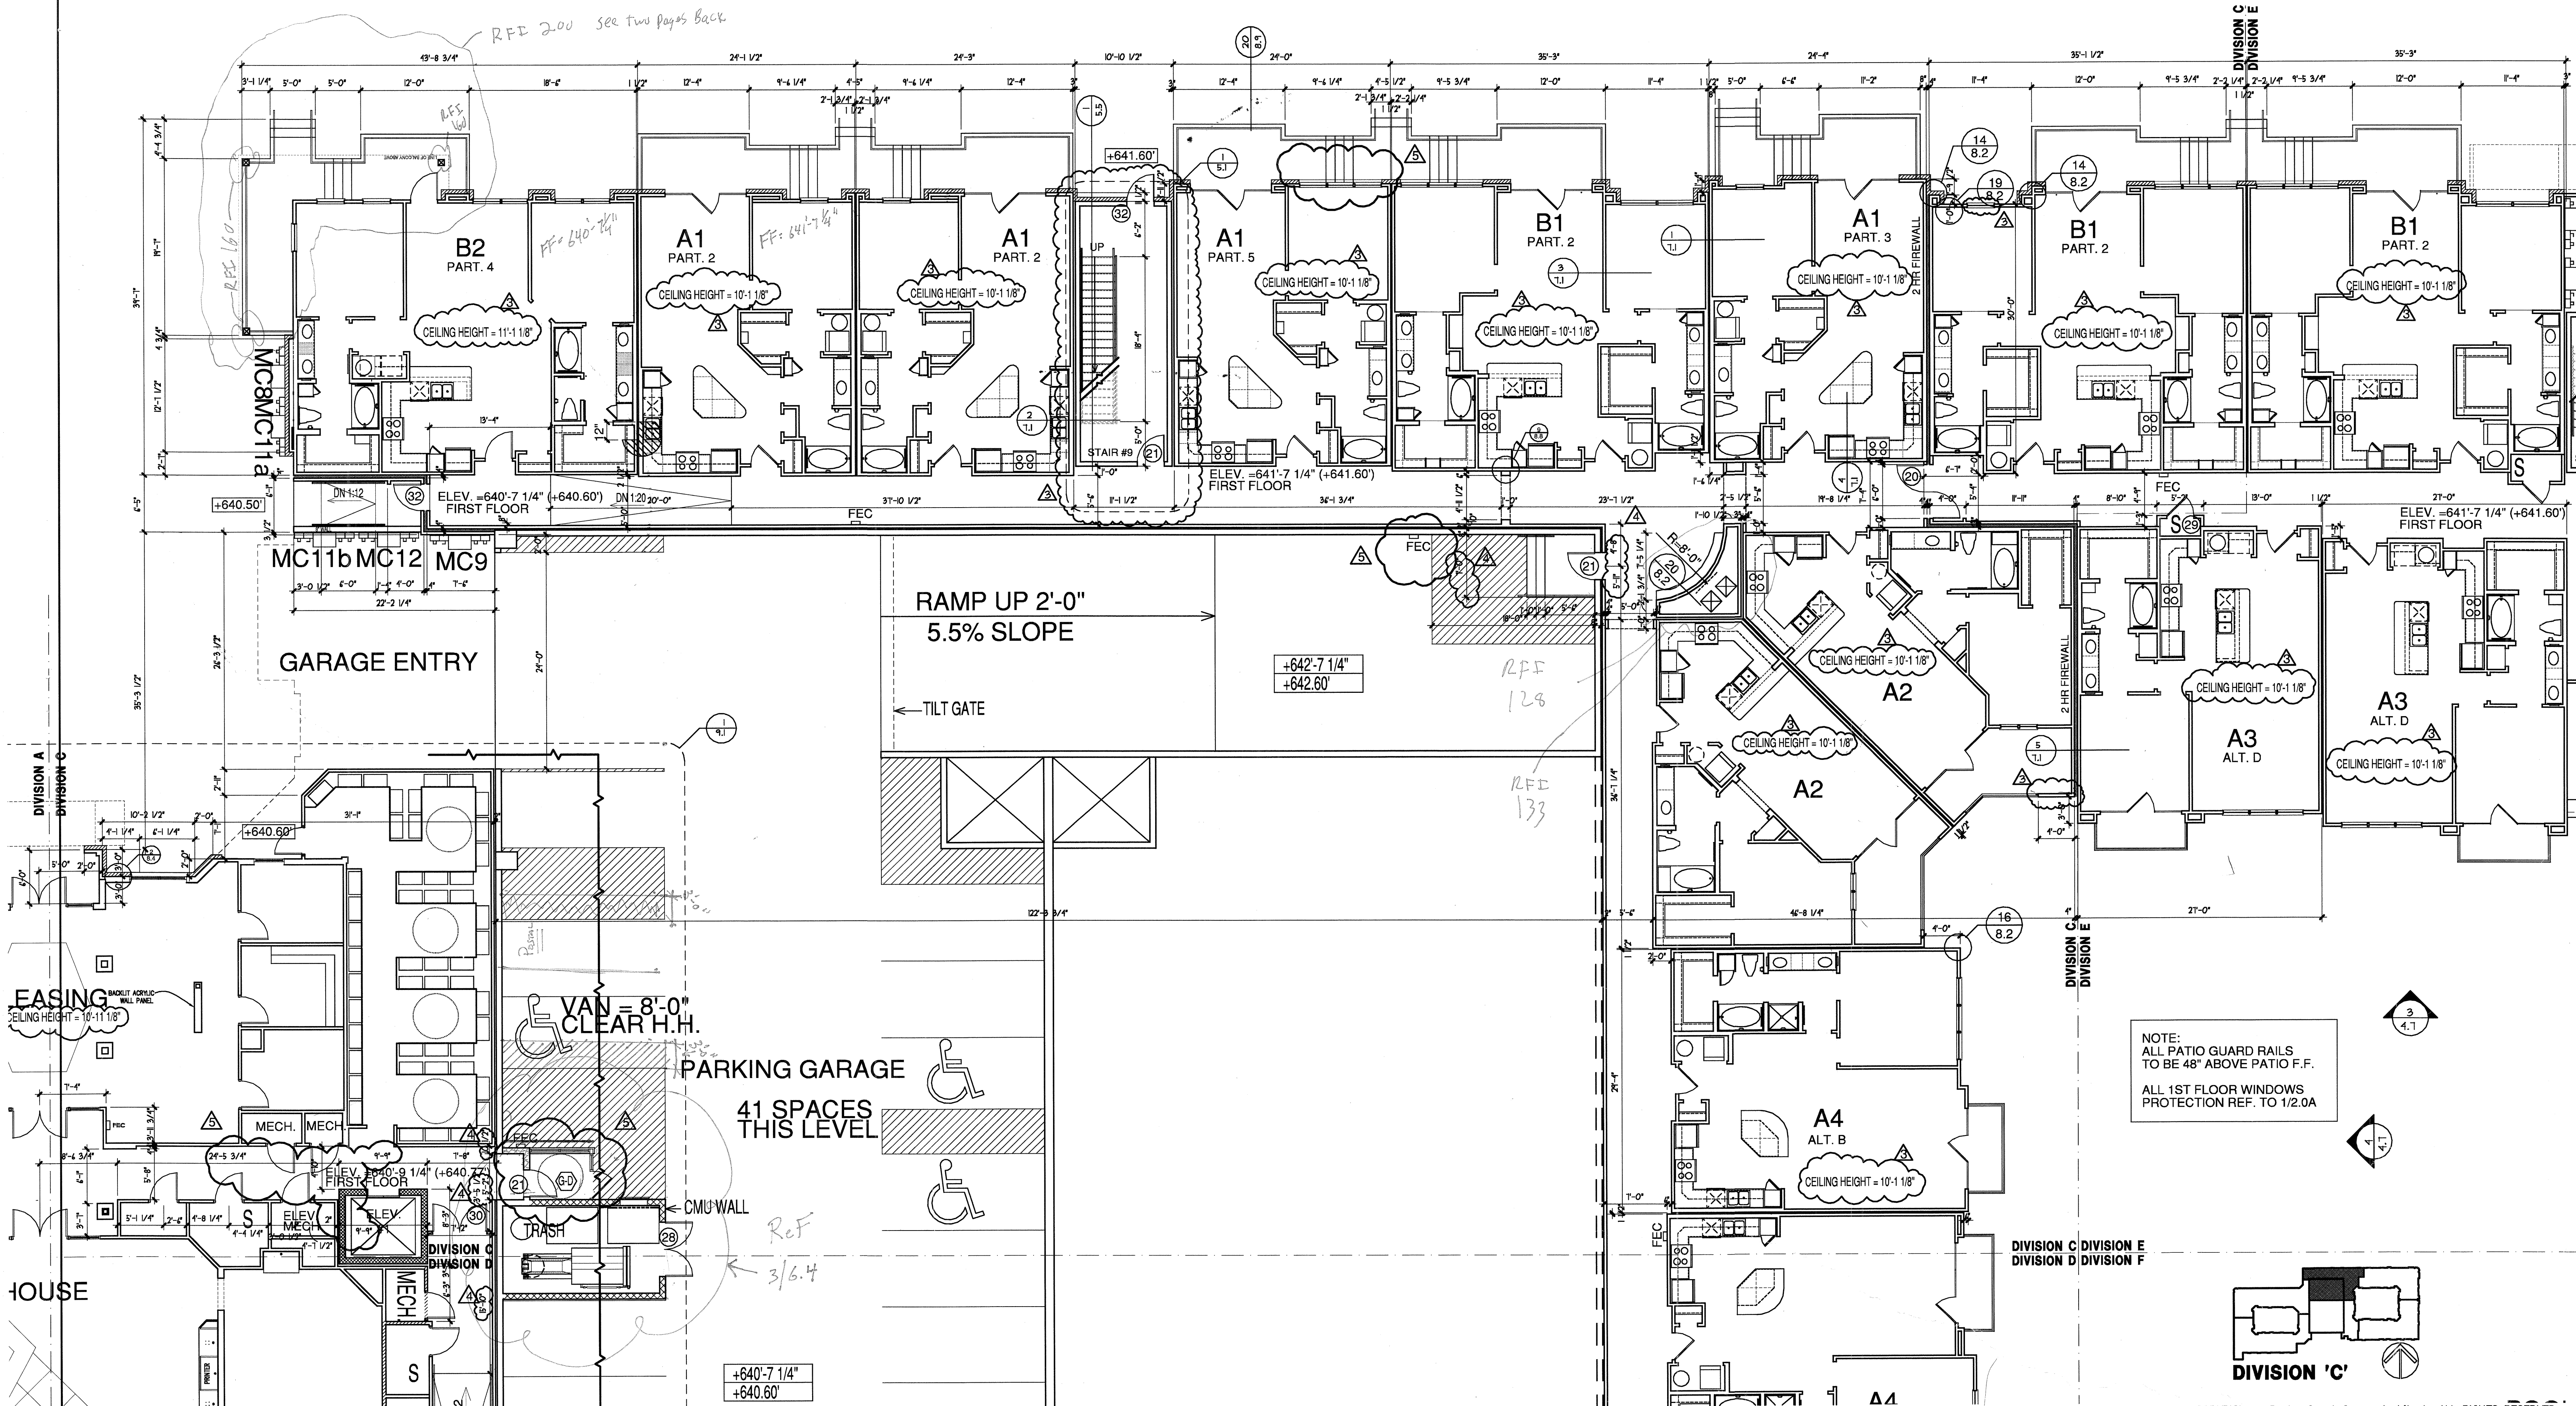

NOTE:
ALL PATIO GUARD RAILS
TO BE 48" ABOVE PATIO F.F.
ALL 1ST FLOOR WINDOWS
PROTECTION REF. TO 1/2.0A

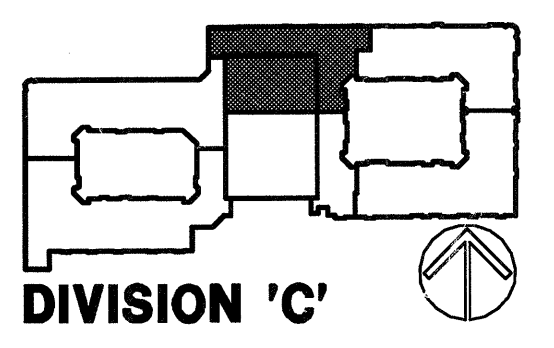

COPYRIGHT © Beeler Guest Owens Architects ALL RIGHTS RESERVED

BGO
architects

4144 N. Central Expy.
Suite 855
Dallas, TX 75204
214.520.8878
bgoarchitects.com

CONSTRUCTION ISSUE
10-17-2011

REVISIONS	DATE
COORDINATION	10-17-2011
GARAGE REVISIONS PER SHOP DWGS	01-03-2012
COORDINATION	02-29-2012

KELLER SPRINGS LOFTS

LOFT APARTMENTS IN ADDISON, TEXAS

REGISTERED ARCHITECT
STATE OF TEXAS
01-03-2012

DATE
08-05-2011

PROJECT
11129

SHEET NUMBER
3.1C
BLDG PLAN 'C'

1 DIVISION 'C' FIRST FLOOR PLAN
1/8"=1'-0"