EMBREY BUILDERS, LLC. 1020 N. E. Loop 410, Suite 700 San Antonio, TX 78209 Ph : (210) 824-6044 Fax: (210) 824-7656

RFI

To: Erik Earnshaw **BGO Architects** 4144 N. Central Expressway Suite 855 Dallas, TX 75205 Ph: (214)520-8878

RFI#: 21 Date: 1/3/2012 Job: EB-02 Keller Springs Lofts Phone: 877-777-5115

CC: Trent Perkins (Parkin Perkins Olsen)

Subject: Elevation eastside of garage Drawing: 3.1D


Company

Spec Section: Cost Impact: None Schedule Impact: None Date Required: 1/10/2012 Sheet 3.1D shows elevation= 641'-1 1/4" at the corridor of the building on the eastside of garage near A4 alt G. unit and romp. Shouldn't the elevation be 641'-7 1/4"? Requested by: Bryan Pickler Embrey Partners, Ltd. Correct 641'-7 1/4" as this part of the corridor on sheet 3.1C Erik Earnshaw Answered by BGO Architects

Page 1 of 1

01-05-2012

RFE 197 SK-15A

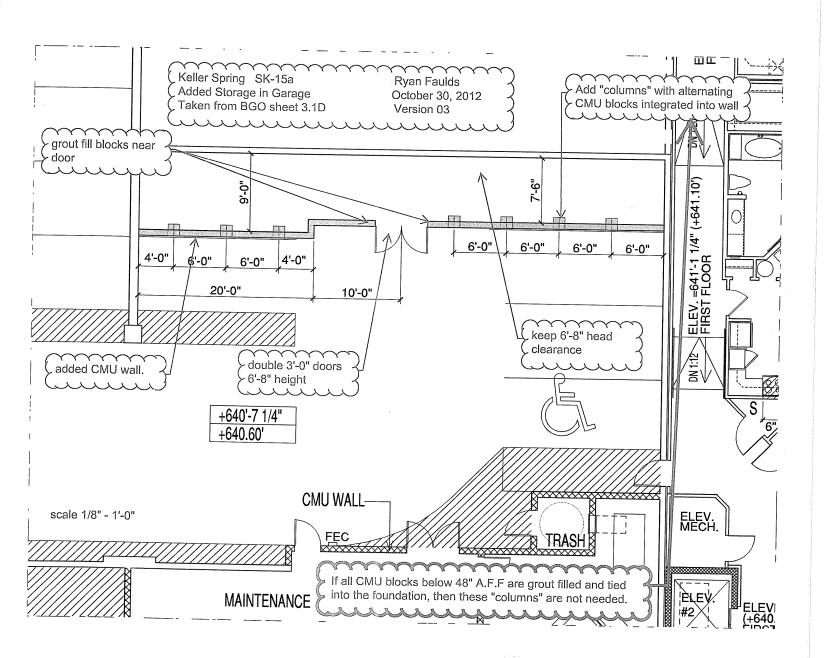

Embrey Builders, LLC 1020 N. E. Loop 410, Suite 700 San Antonio, TX 78209

Ph : (210) 824-6044 Fax: (210) 824-7656

CC: Walter Kilroy (BGO)

Company

RFI

To: Ryan Faulds RFI #: 197 B.G.O. Architects, Inc. Date: 10/12/2012 4245 N. Central Expressway Job: EB-02 Keller Springs Lofts Dallas, TX 75205 Phone: 877-777-5115 Ph: (210)829-1898 Fax: (210)829-1899

Subject: Required spacing measurement between top of CMU wall and bottom of double T flange Drawing: SK-15

Spec Section: Cost Impact: None Schedule Impact: None Date Required: 10/19/2012 Please provide the required spacing measurement between the top of the cmu wall and the bottom of the double T flange. The camber of the double T across the width of the garage should be considered in this gap measurement, along with the potential deflection from vehicle traffic on the precast drive surface. Also, we will need the detail/spec for sealing the top of the cmu to the bottom of the double T flange. Requested by: Bryan Pickler Embrey Partners, Ltd. Response: This RFI was answered with architectural SK-15. Ryan Faulds **BGO** architects October 16, 2012 Answered by

Page 1 of 1

2nd FLOOR OF PARKING GARAGE - MINERAL WOOL - SHEET METAL added CMU wall Keller Spring SK-15b
Added Storage in Garage > scale 1 1/2"=1'-0" PARKING STORAGE ≻ Ryan Faulds GARAGE Cotober 16, 2012 ≻ Version 01 ##BGO architects mmmm