


NOTE:
ALL PATIO GUARD RAILS
TO BE 48" ABOVE PATIO F.F.
ALL 1ST FLOOR WINDOWS
PROTECTION REF. TO 1/2.0A

1 DIVISION 'D' FIRST FLOOR PLAN
1/8" = 1'-0"

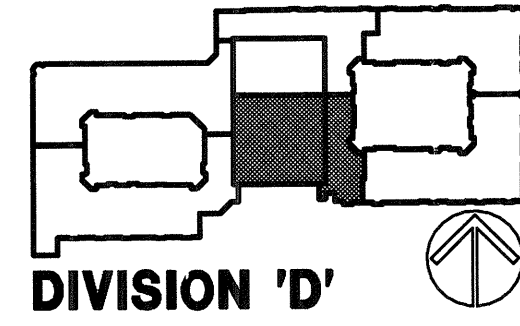

BGO
architects
4144 N. Central Expy.
Suite 855
Dallas, TX 75204
214.520.8878
bgoarchitects.com

CONSTRUCTION ISSUE
10-17-2011

- REVISIONS
- △ COORDINATION
10-17-2011
 - △ GARAGE REVISIONS
PER SHOP DWGS
01-03-2012

KELLER SPRINGS LOFTS
LOFT APARTMENTS IN ADDISON, TEXAS

REGISTERED ARCHITECT
D. EARLY
22433
STATE OF TEXAS
01-03-2012

COPYRIGHT © Beeler Guest Owens Architects ALL RIGHTS RESERVED
DATE
08-05-2011
PROJECT
11129

SHEET NUMBER
3.1D
BLDG PLAN 'D'