


NOTE:
ALL PATIO GUARD RAILS
TO BE 48" ABOVE PATIO F.F.
ALL 1ST FLOOR WINDOWS
PROTECTION REF. TO 1/2.0A

+640'-7 1/4"
+640.60'

+640'-7 1/4"
+640.60'

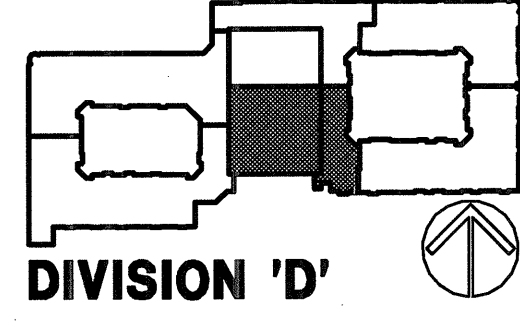

1 DIVISION 'D' FIRST FLOOR PLAN
1/8" = 1'-0"

BGO architects
4144 N. Central Expy.
Suite 855
Dallas, TX 75204
214.520.8878
bgoarchitects.com

CONSTRUCTION ISSUE
10-17-2011

REVISIONS

COORDINATION	10-17-2011
--------------	------------

KELLER SPRINGS LOFTS
LOFT APARTMENTS IN ADDISON, TEXAS

REGISTERED ARCHITECT
STATE OF TEXAS
22433

DATE: 08-05-2011
PROJECT: 11129
SHEET NUMBER: 3.1D
BLDG PLAN 'D'

10-17-2011

COPYRIGHT © Beeler Guest Owens Architects ALL RIGHTS RESERVED