## EMBREY BUILDERS, LLC.

1020 N. E. Loop 410, Suite 700 San Antonio, TX 78209 Ph: (210) 824-6044 Fax: (210) 824-7656

RFI

To: Erik Earnshaw **BGO Architects** 4144 N. Central Expressway Suite 855 Dallas, TX 75205

RFI#: 9 Date: 12/14/2011

Job: EB-02 Keller Springs Lofts Phone: 877-777-5115

CC: Enviro Design Landscape, David Gallagher (Embrey Build (Embrey Construction LLC)

Subject: MC 13A difference on layouts

Ph: (214)520-8878

Spec Section:

Drawing: E3.1 E sheet 3.1E Cost Impact: None Schedule Impact: None

Date Required: 12/21/2011 MC 13A is not shown on Arch sheet 3.1E. the wall layout is diffrent on the two sheets 3.1E and E3.1E please give direction also should elevation at MC 13A location be 639.1 as indicated on S2.15 Arch sheet 3.1E shows 6" drop should that be 2' 6" drop? Requested by: Bryan Pickler Embrey Partners, Ltd.

I spoke to JandS and verified we do infact have enough wall space for the required meters shown on the electrical drawings. The foundation plan shows a 2'-6" drop which is correct. The architectural drawing are being revised and will be issues in a few days.

Erik Earnshaw

Answered by

12-15-2011

Company

Page 1 of 1

**EMBREY BUILDERS, LLC.** 

1020 N. E. Loop 410, Suite 700 San Antonio, TX 78209 Ph: (210) 824-6044 Fax: (210) 824-7656

To: Erik Earnshaw Beeler Guest Owens Architects 4245 N. Central Expressway

Suite 300 Dallas, TX 75205 Ph: 214/520-8878 Fax: 214/520-8879

Subject: 2 HR Assembly at Stairwells/2 HR Firewall Drawing: A3.1E & 1/A5.2

Cost Impact: None

Spec Section: Schedule Impact: None

RFI

RFI #: 89

Date: 3/27/2012

Phone: 877-777-5115

Job: EB-02 Keller Springs Lofts

The typical stair tower detail on 1/A5.2 calls for two layers of 5/8" gyp on the inside walls of the stair tower. It shows two layers on the outside walls also, but is not called out. Please provide a cut showing how the two walls are to be sheathed and spaced properly. Please provide a detail showing how the 2HR Firewall is to be installed at a stepped location, as shown on the left side of Requested by: David Miller Embrey Builders LLC

NOTE: see RFI-087 for answers to some of these questions.

The 2 layers ARE called out. If you look close, the arrows are aligned.

If you look at 5/ A7.1 at the bottom you see the wall can thought of in 3 parts, each part being 4". For a 2HR fire wall at a slab step, 8" will be on the lower elevation, and 4" will be on the higher elevation.

For the area between Stairs and a Unit, there are 3" between the two to allow for sheathing and (because no 2x4 is perfect) any possible bowing in the lower elevation wall. With 3" of "wiggle room" to play with, your means and method should not be an

All of your non-fire wall detail callouts are on the last page of RFI-087.

Ryan Faulds

Company

Answered by BGO architects

April 04, 2012

Page 1 of 1

EMBREY BUILDERS, LLC.

1020 N. E. Loop 410, Suite 700 San Antonio, TX 78209 Ph: (210) 824-6044 Fax: (210) 824-7656

RFI

To: Erik Earnshaw Beeler Guest Owens Architects 4245 N. Central Expressway Suite 300

Job: EB-02 Keller Springs Lofts Phone: 877-777-5115 Dallas, TX 75205

Ph: 214/520-8878 Fax: 214/520-8879 cc: Trent Perkins (Parkin Perkins Olsen)

Subject: A1 Part 2 Window

Drawing: 9/A2.2, A3.1E & 19/A8.2 Cost Impact: None

Spec Section: Schedule Impact: None

RFI#: 103


Date: 4/3/2012

Date Required: 4/11/2012 9/A2.2 shows a signle Mark H window in the bedroom. A3.1E shows a twin window in the bedroom and has the window pushed to the brick per 19/A8.2. What is the correct window and placement of the window? Requested by: David Miller Embrey Builders LLC

A1 unit plans on 2.2 are dimensioned accurately. (I added it at the end of this PDF just for reference, but this RFI has not changed that sheet) Sheer 3.1E has been updated to coordinate. Please see next page of this PDF.

Ryan Faulds Answered by BGO architects April 17, 2012 Company

Page 1 of 1

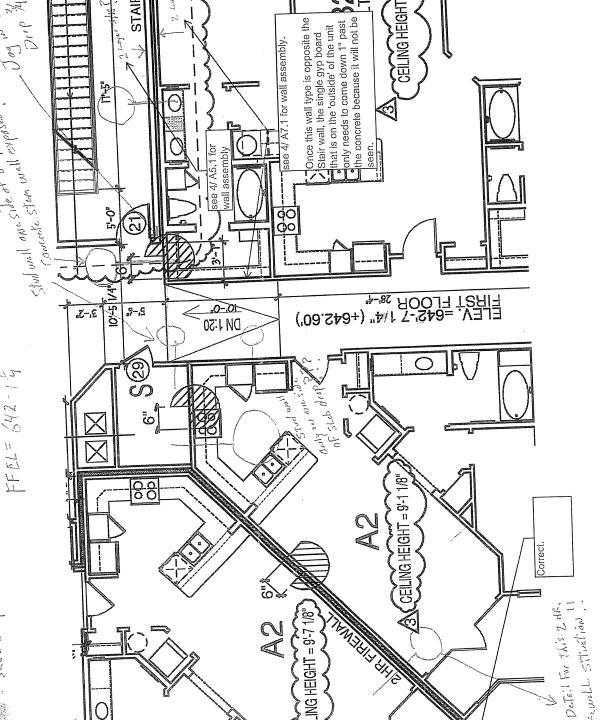

EMBREY BUILDERS, LLC. 1020 N. E. Loop 410, Suite 700 San Antonio, TX 78209

Ph: (210) 824-6044 Fax: (210) 824-7656

RFI

To: Trent Perkins RFI#: 107 Parkin Perkins Olsen Date: 4/9/2012 9330 LBJ Freeway, Suite 1055 Job: EB-02 Keller Springs Lofts Dallas, TX 75243 Phone: 877-777-5115 Ph: (214)221-2220 Fax: (214)221-2252

**CC:** Erik Earnshaw (Beeler Guest Owens Architects)

Subject: Structural/Architectural Difference at Courtyard Entry

Drawing: S2.15 & A3.1E; S2.12 & A3.1B Cost Impact: None

Spec Section: Schedule Impact: None

Date Required: 4/17/2012 S2.15 shows sloping concrete on the interior of the building entry from the courtyard. A3.1E does not show that. It only shows slope outside the door. S2.12 shows a slope down and then flat at the door. A3.1B does not show a slope. Please confirm which is

Requested by: David Miller Embrey Builders LLC

Structural plans are in agreement with Architectural Forming plans. Architect to confirm that this information is the design intent. R. Trent Perkins, P.E. May 28, 2012 Parkin-Perkins-Olsen Consulting Engineering, Inc. Trent is correct, and Yes, this is the design intent. Ryan Faulds **BGO** architects May 29, 2012 Answered by Company

Page 1 of 1

