

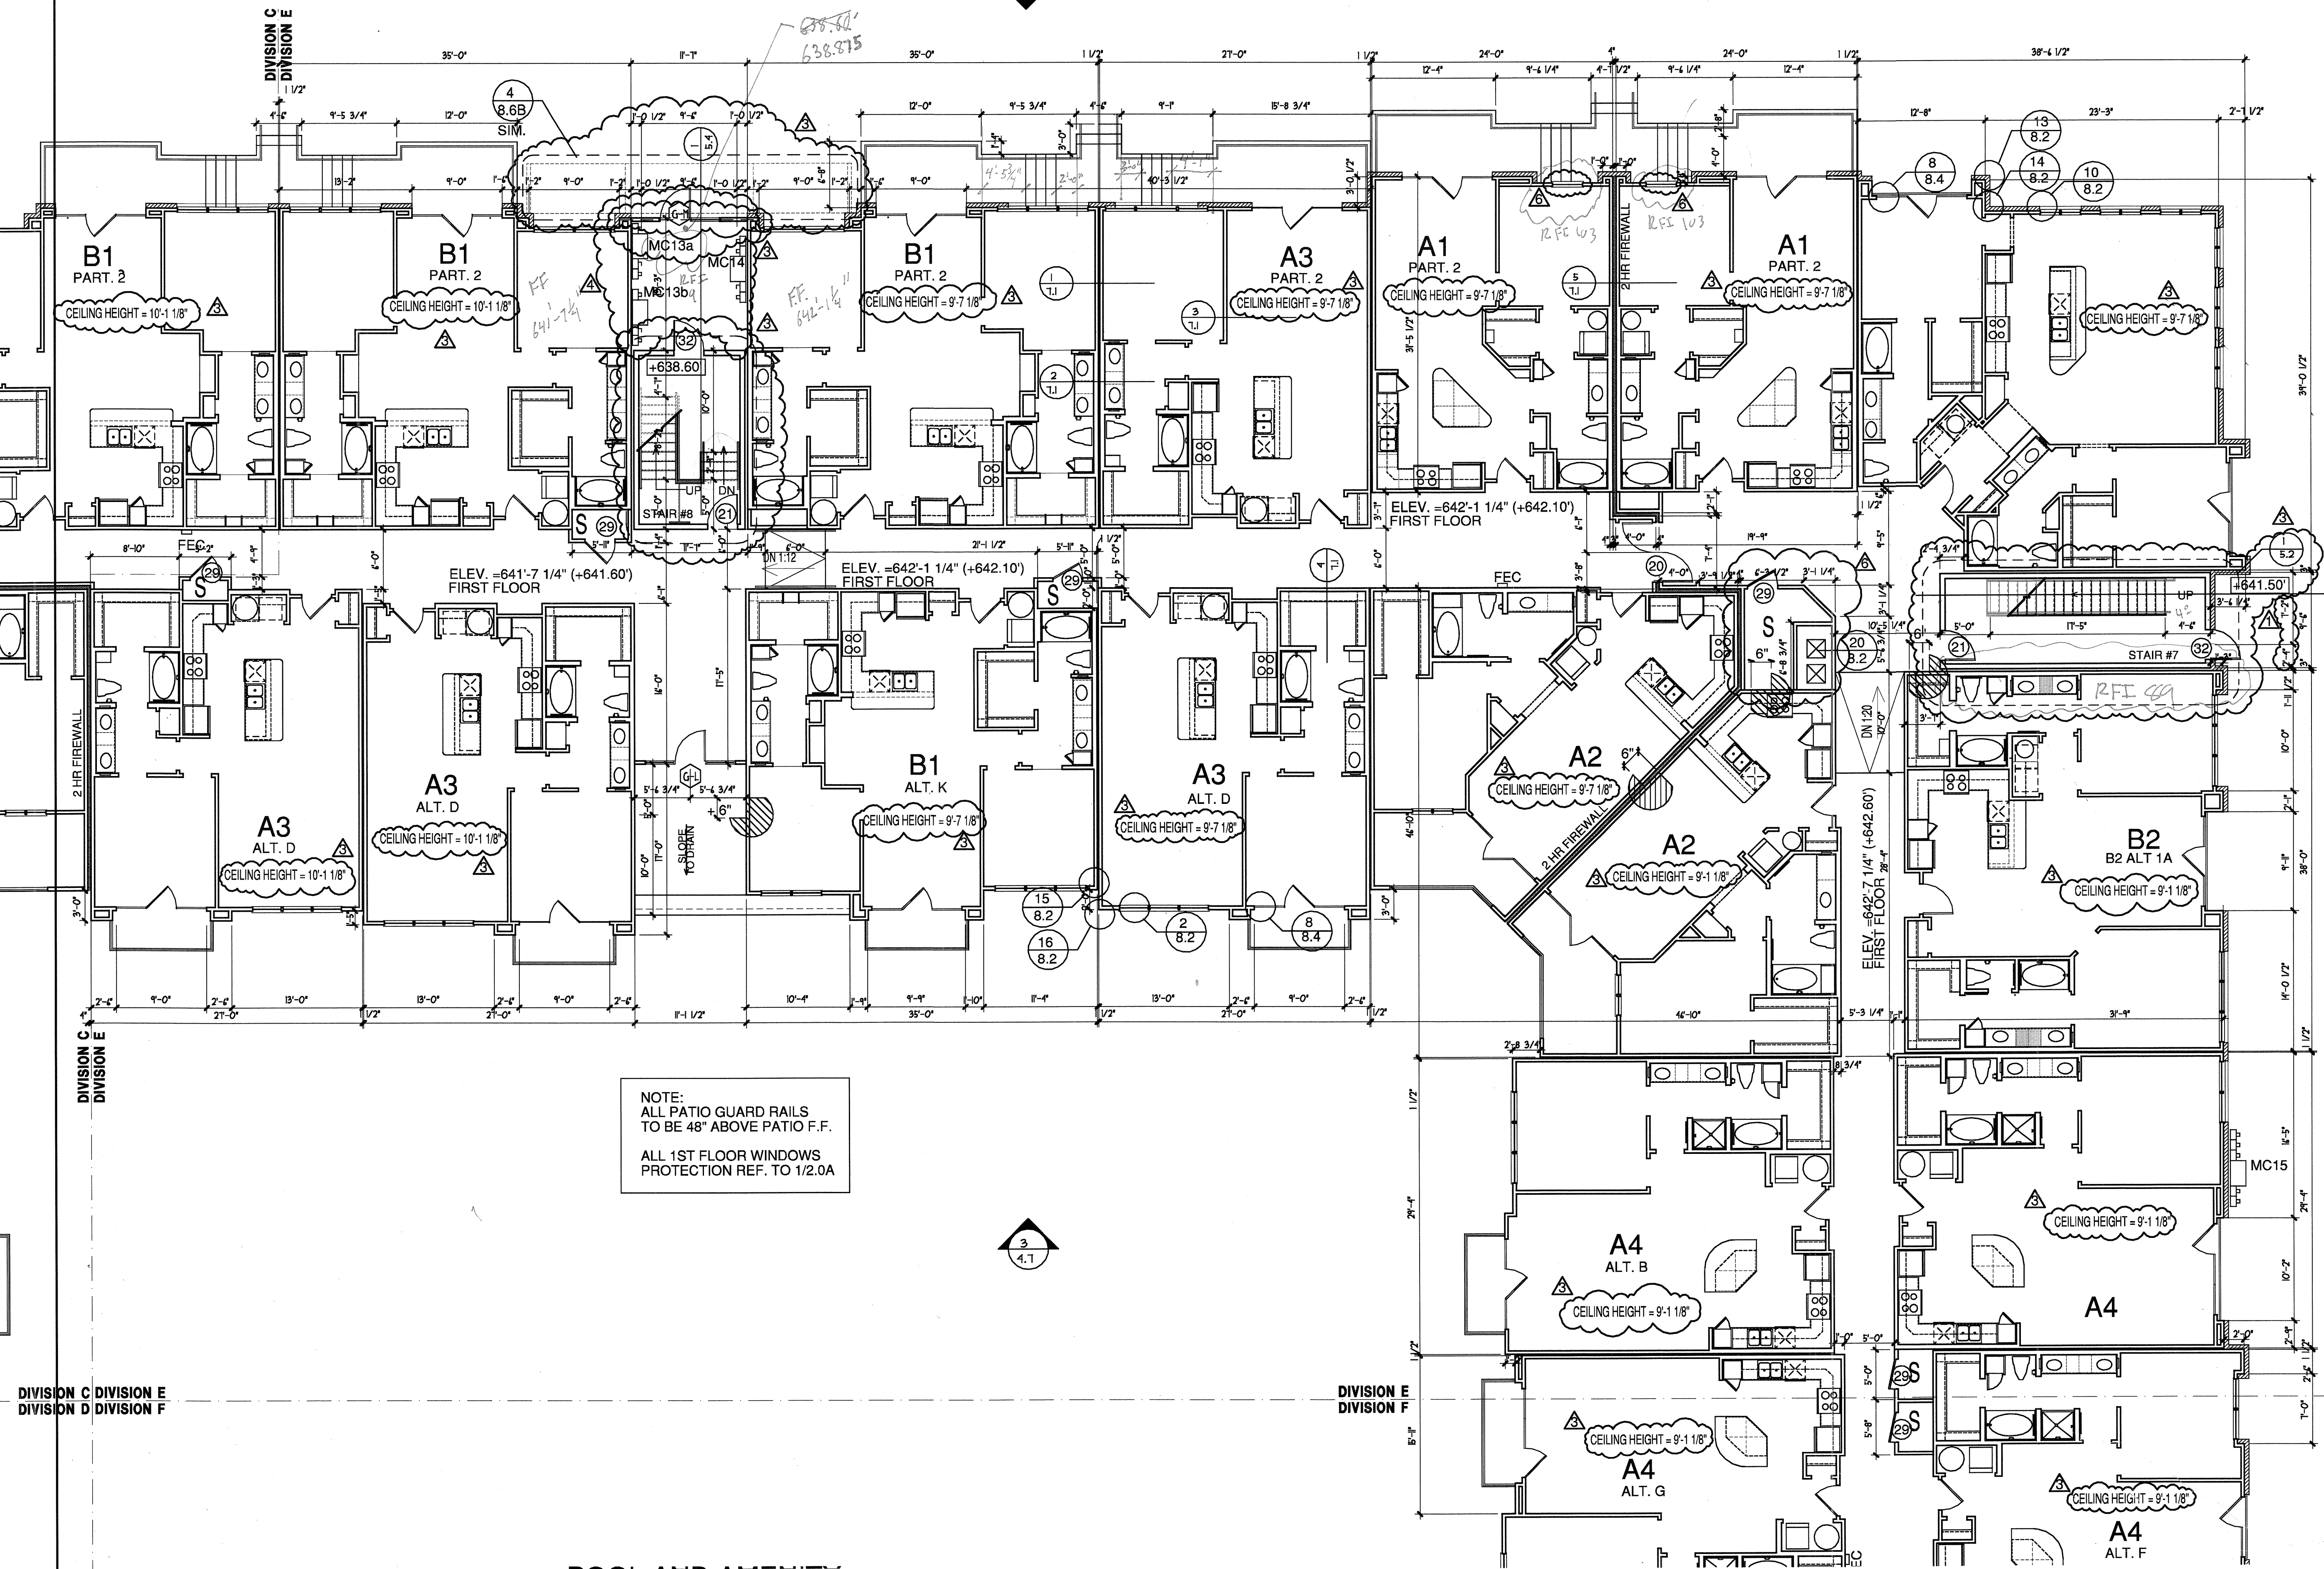


As per Ryan (BGO)
8/05/12
638.975

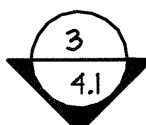

NOTE:
ALL PATIO GUARD RAILS
TO BE 48" ABOVE PATIO F.F.
ALL 1ST FLOOR WINDOWS
PROTECTION REF. TO 1/2.0A

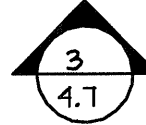

DIVISION C DIVISION E
DIVISION D DIVISION F

1 DIVISION 'E' FIRST FLOOR PLAN
1/8"=1'-0"

BGO
architects
4144 N. Central Expy.
Suite B55
Dallas, TX 75204
214.520.8878
bgoarchitects.com

CONSTRUCTION ISSUE
10-17-2011

REVISIONS
ANSI/FHA COMMENTS
09-13-2011
COORDINATION
10-17-2011
COORDINATION
04-17-2012

KELLER SPRINGS LOFTS
LOFT APARTMENTS IN ADDISON, TEXAS

REGISTERED ARCHITECT
STATE OF TEXAS
22433
01-03-2012

DATE
08-05-2011
PROJECT
11129

SHEET NUMBER
3.1E
BLDG PLAN 'E'