

DIVISION C DIVISION E
DIVISION D DIVISION F


DIVISION E
DIVISION F

DIVISION E
DIVISION F

POOL AND AMENITY

NOTE:
ALL PATIO GUARD RAILS
TO BE 48" ABOVE PATIO F.F.

ALL 1ST FLOOR WINDOWS
PROTECTION REF. TO 1/2.0A

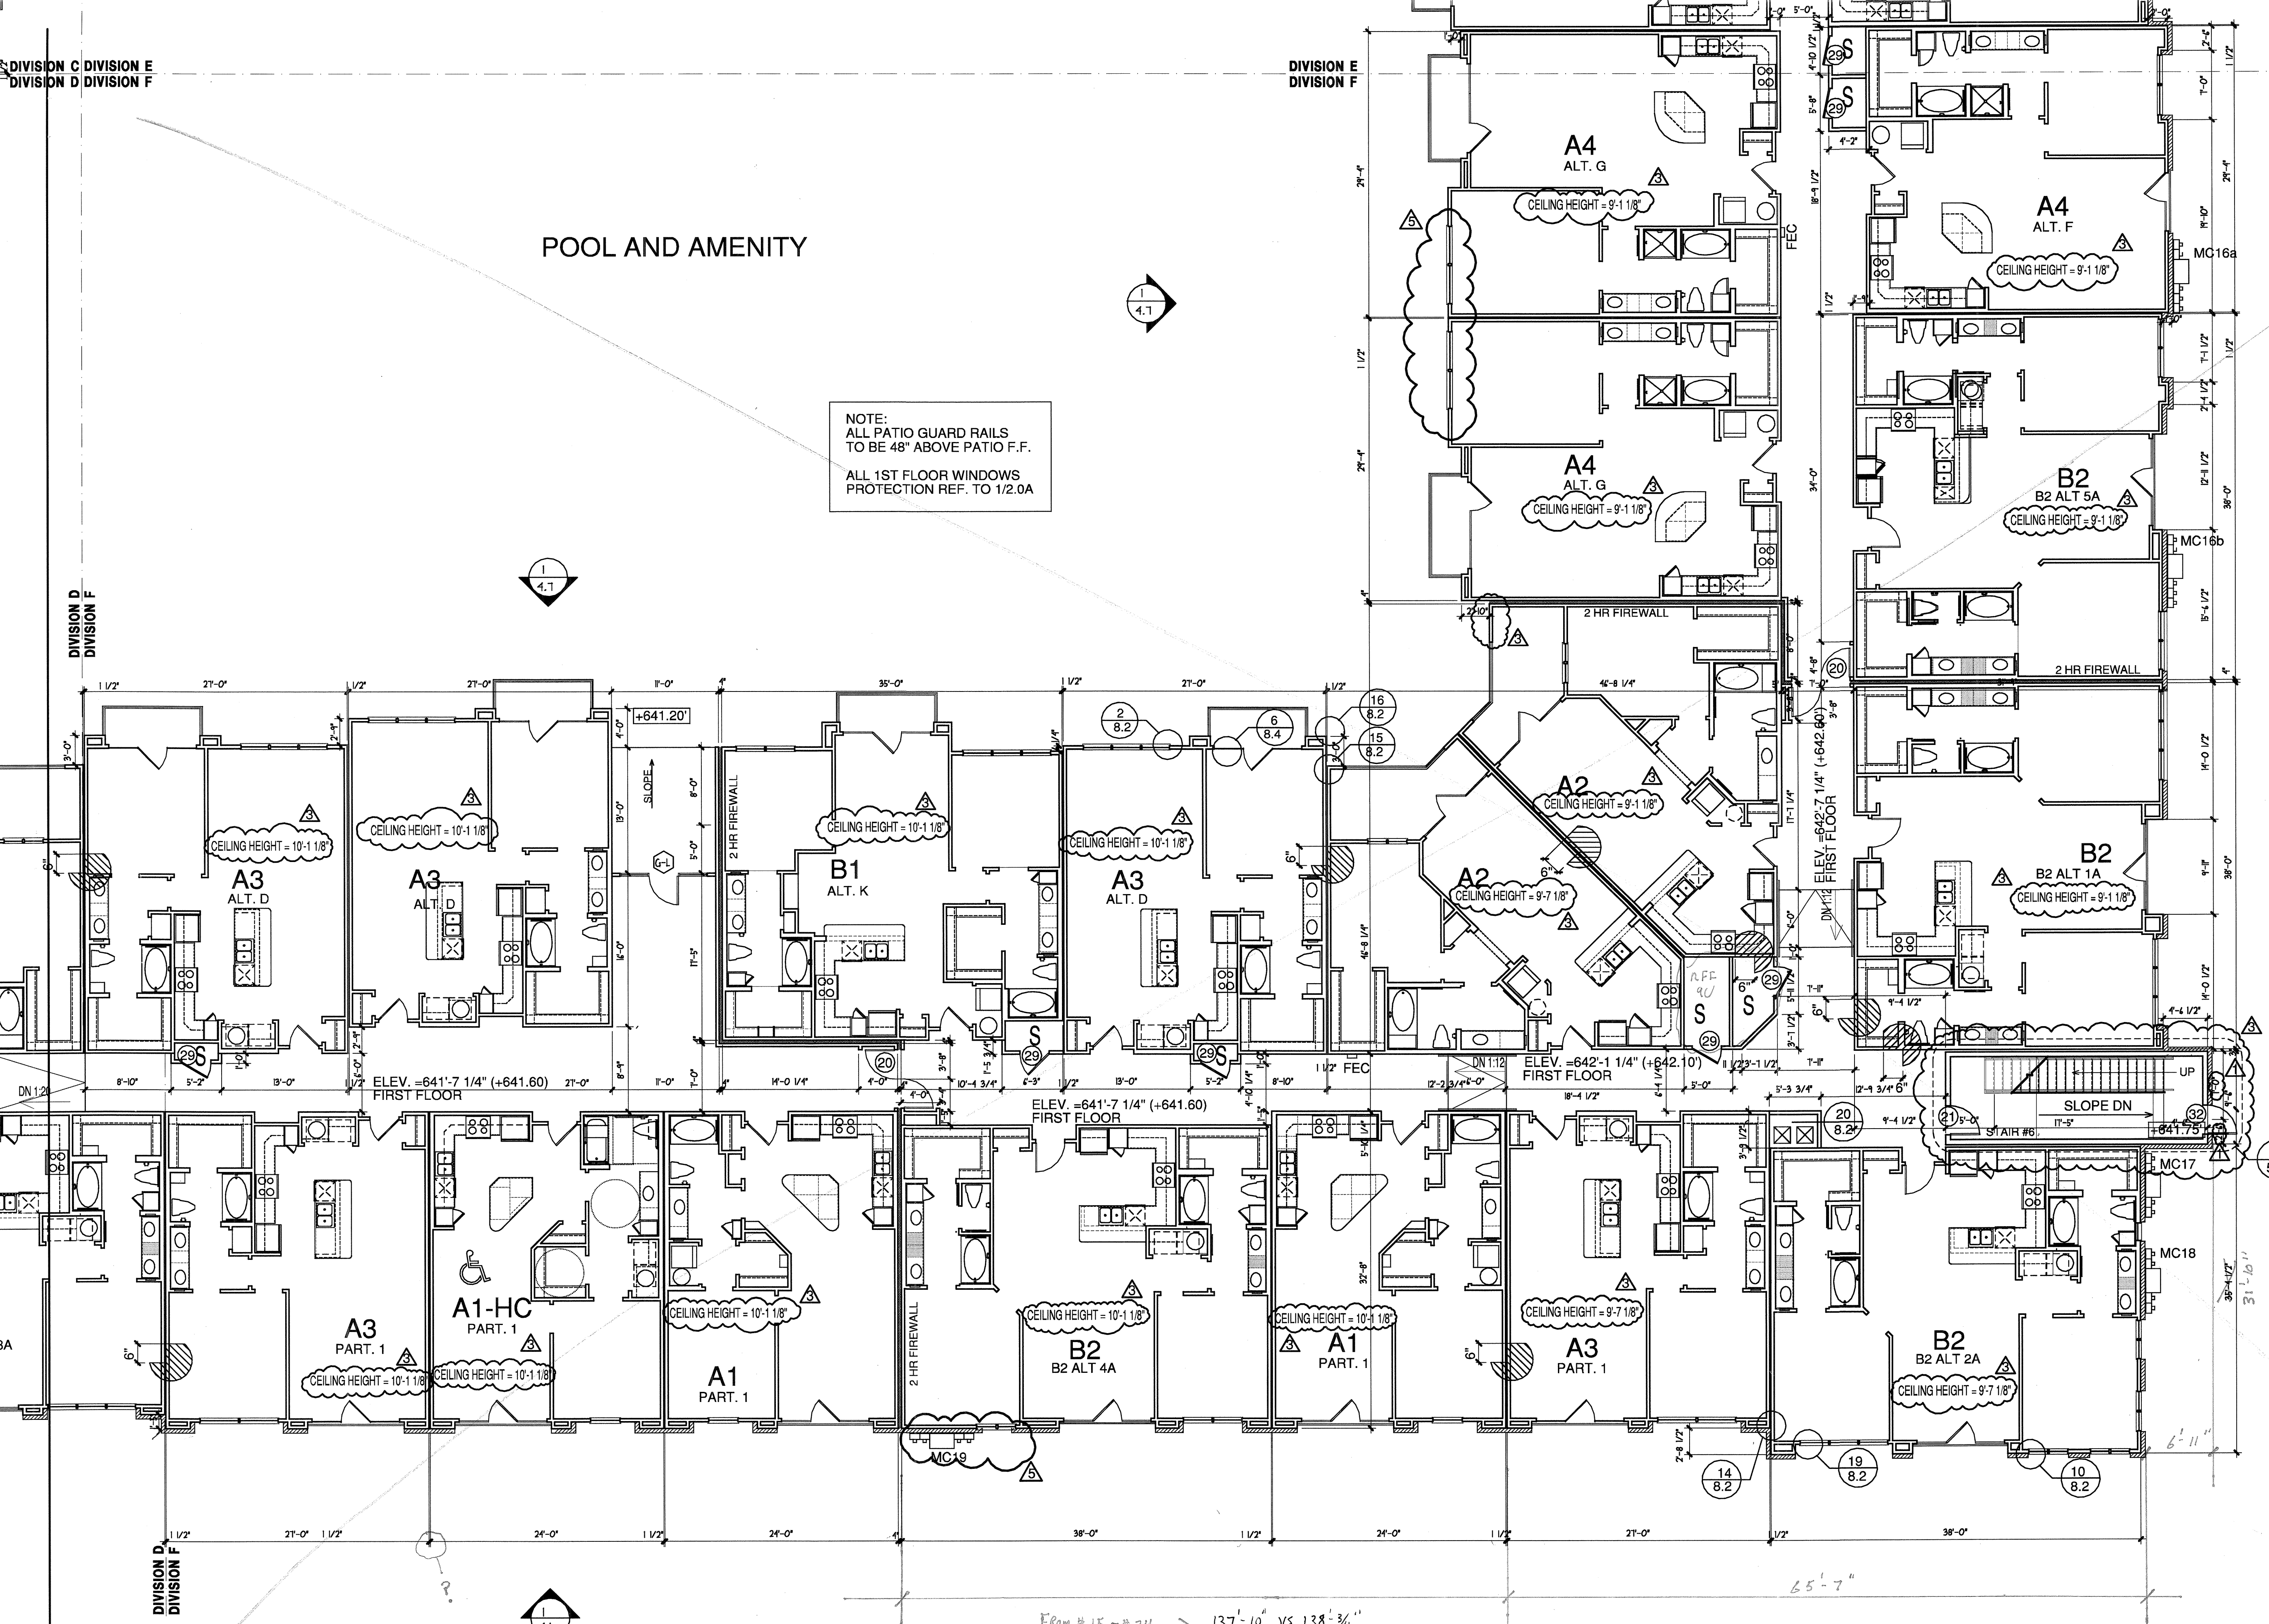

From # 15 to # 24 → 137'-10" vs 138'-3/4"

DIVISION 'F' FIRST FLOOR PLAN

1/8"=1'-0"

DIVISION 'F'

BGO
architects

4144 N. Central Expy.
Suite 855
Dallas, TX 75204
214.520.8878
bgoarchitects.com

CONSTRUCTION ISSUE
10-17-2011

REVISIONS

ANSI/FHA COMMENTS	09-13-2011
COORDINATION	10-17-2011
COORDINATION	02-29-2012

KELLER SPRINGS LOFTS

LOFT APARTMENTS IN ADDISON, TEXAS



01-03-2012

COPYRIGHT © Beeler Guest Owens Architects ALL RIGHTS RESERVED

DATE	08-05-2011
PROJECT	11129

SHEET NUMBER	3.1F
BLDG PLAN 'F'	