

DIVISION C DIVISION E
DIVISION D DIVISION F


DIVISION E
DIVISION F

DIVISION E
DIVISION F


POOL AND AMENITY

NOTE:
ALL PATIO GUARD RAILS
TO BE 48" ABOVE PATIO F.F.

ALL 1ST FLOOR WINDOWS
PROTECTION REF. TO 1/2.0A

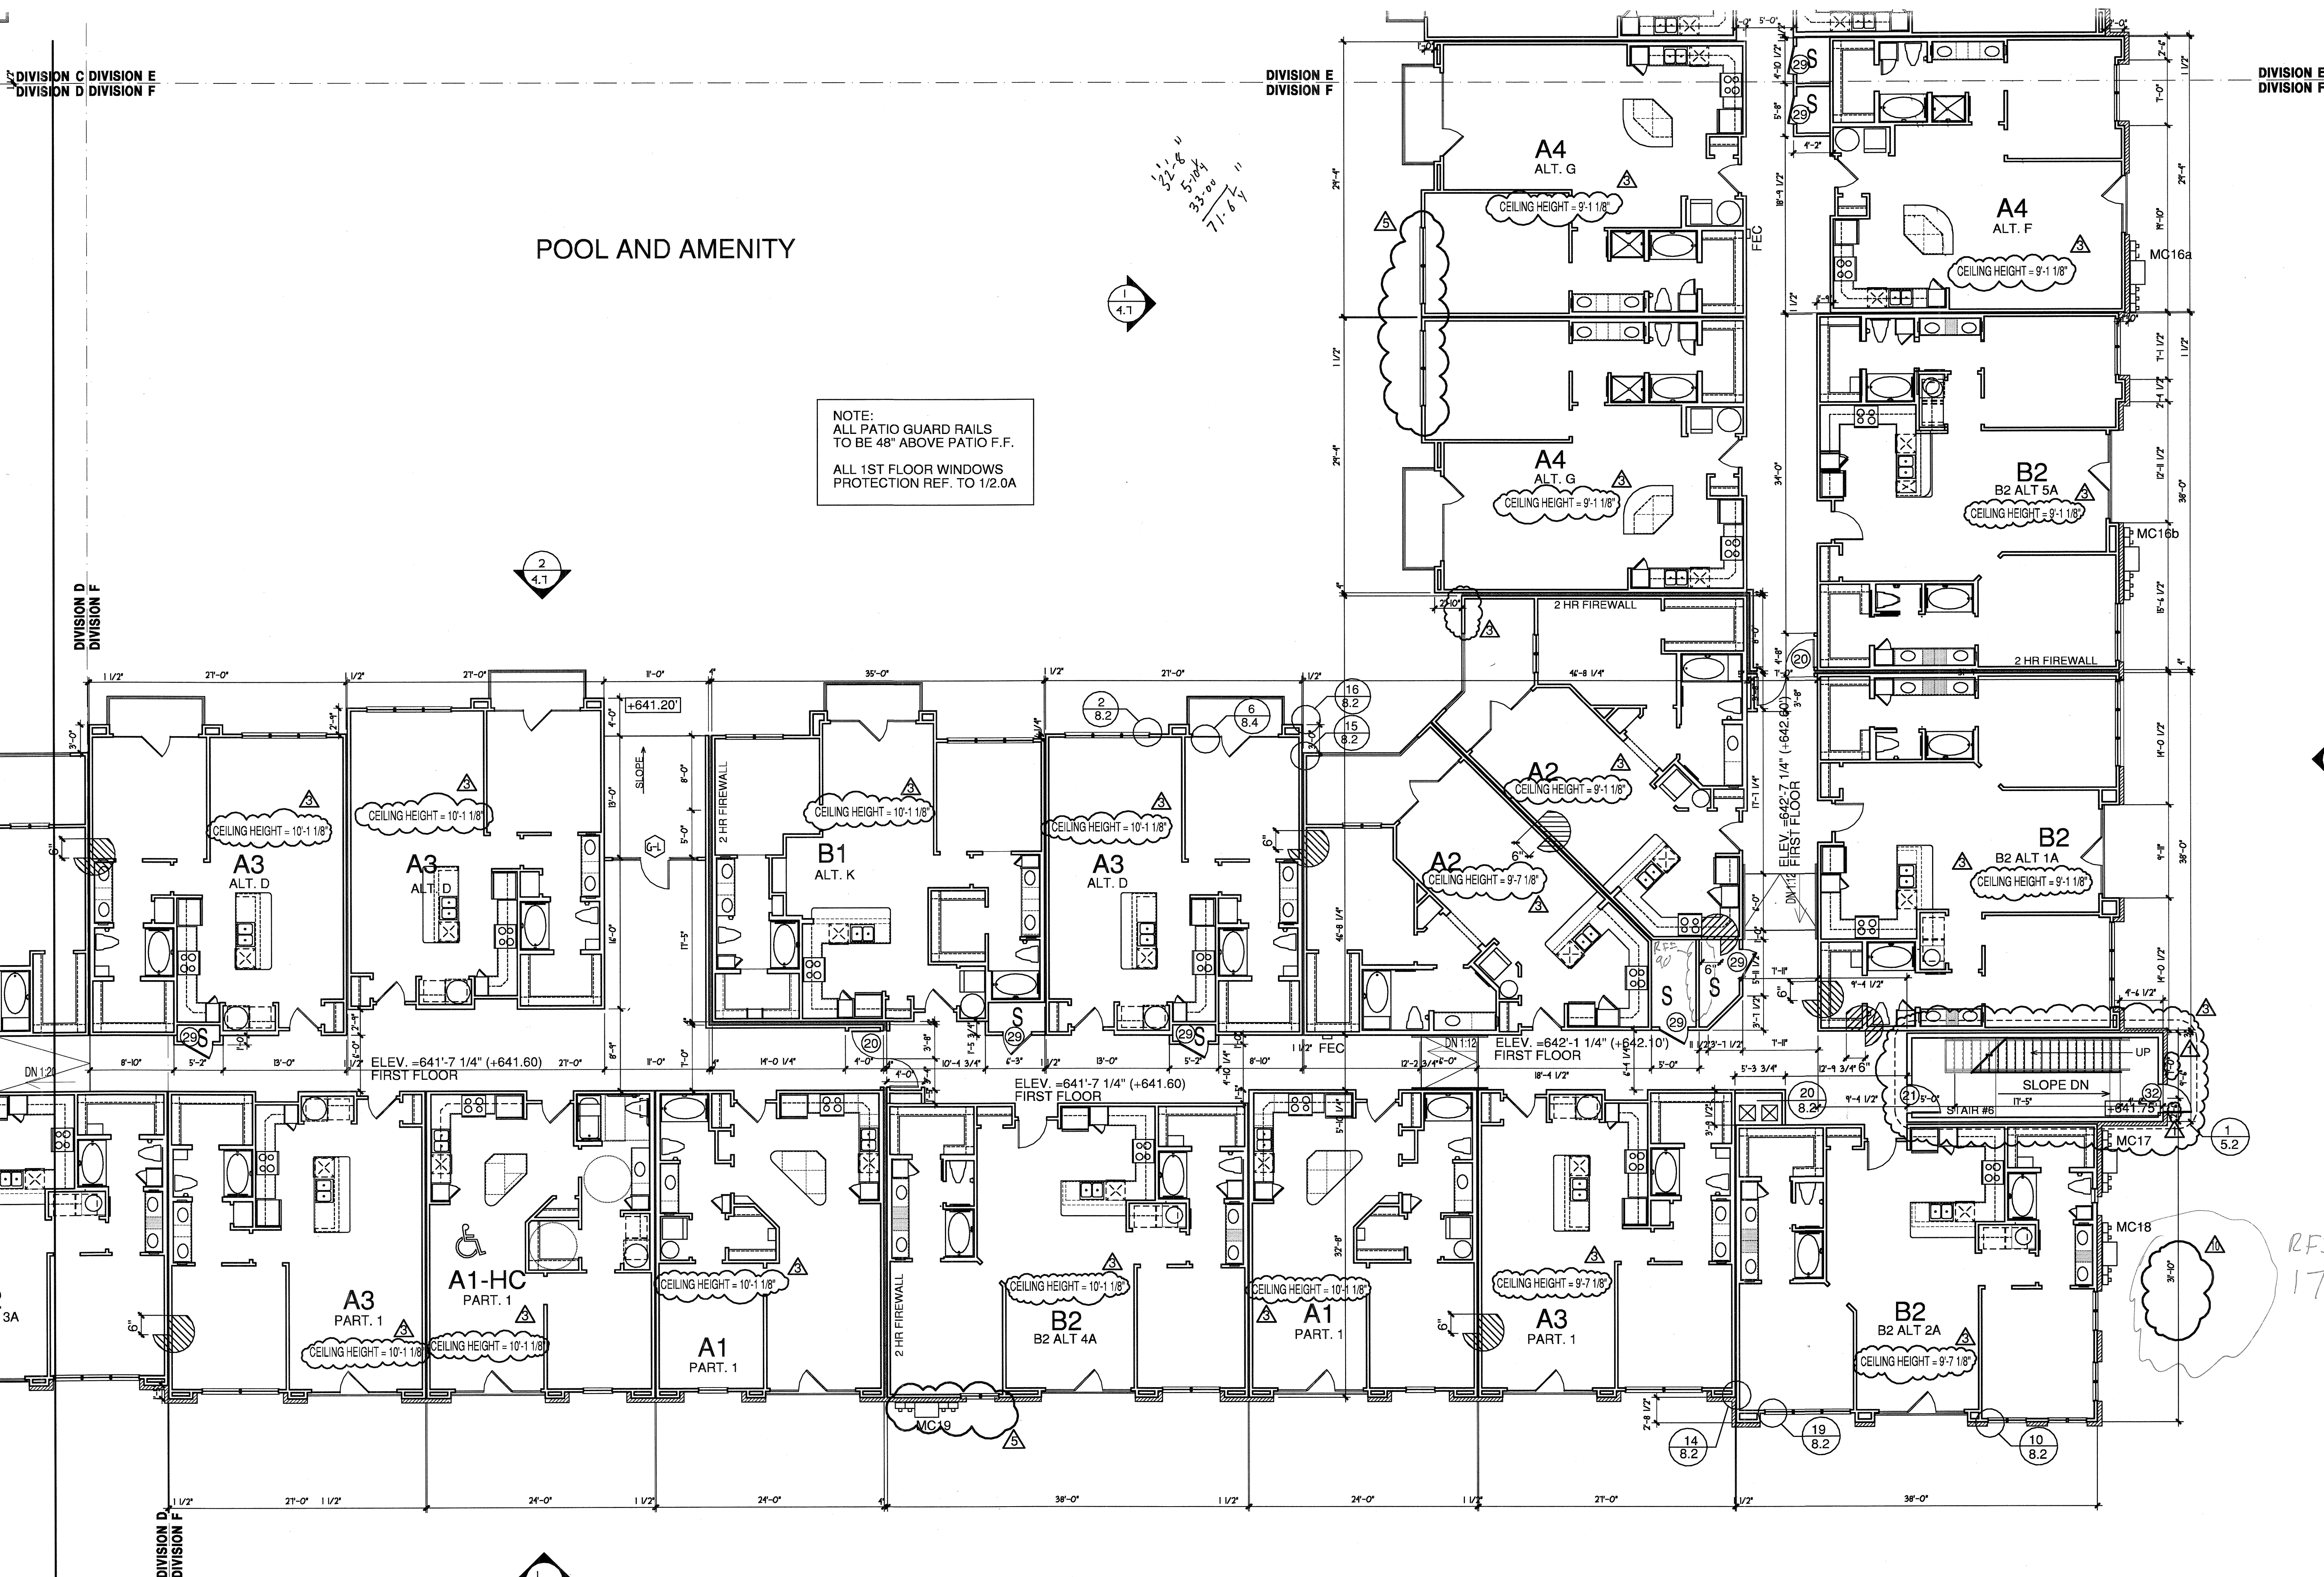

1 DIVISION 'F' FIRST FLOOR PLAN
1/8"=1'-0"

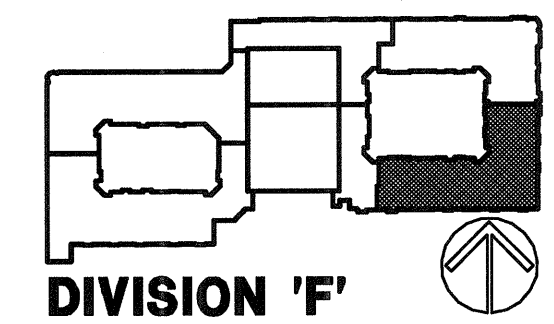

BGO
architects

4144 N. Central Expy.
Suite 855
Dallas, TX 75204
214.520.8878
bgoarchitects.com

CONSTRUCTION ISSUE
10-17-2011

REVISIONS	
ANSI/FHA COMMENTS 09-13-2011	RFI-173 07-30-2012
COORDINATION 10-17-2011	
COORDINATION 02-29-2012	

KELLER SPRINGS LOFTS

LOFT APARTMENTS IN ADDISON, TEXAS



DATE
08-05-2011

PROJECT
11129

SHEET NUMBER
3.1F
BLDG PLAN 'F'