


1 DIVISION 'A' SECOND FLOOR PLAN
1/8"=1'-0"

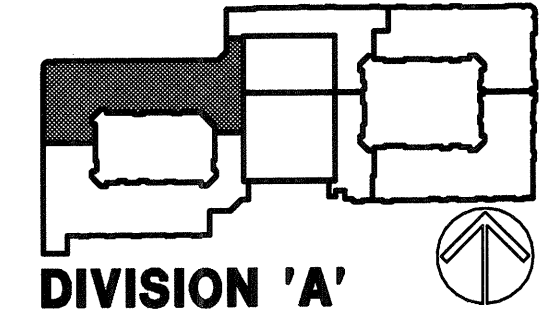


BGO
architects
4144 N. Central Expy.
Suite 855
Dallas, TX 75204
214.520.8878
bgoarchitects.com

CONSTRUCTION ISSUE
10-17-2011

REVISIONS

3	COORDINATION	10-17-2011
4	GARAGE REVISIONS PER SHOP DWGS	01-03-2012

KELLER SPRINGS LOFTS
LOFT APARTMENTS IN ADDISON, TEXAS

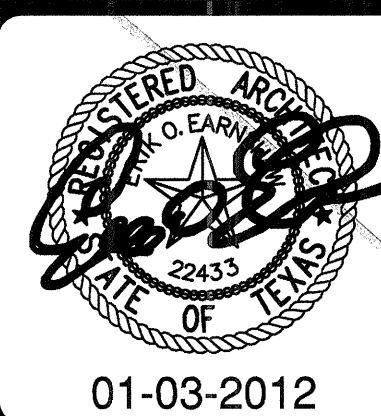

DATE
08-05-2011
PROJECT
11129

SHEET NUMBER
3.2A
BLDG PLAN 'A'

COPYRIGHT © Beeler Guest Owens Architects ALL RIGHTS RESERVED