


**1** DIVISION 'A' SECOND FLOOR PLAN  
1/8"=1'-0"

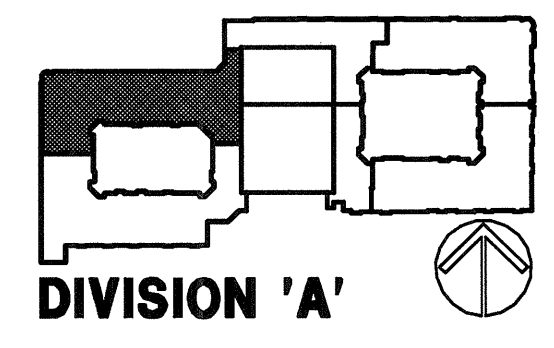

**BGO**  
architects  
4144 N. Central Expy.  
Suite 855  
Dallas, TX 75204  
214.520.8978  
bgoarchitects.com

CONSTRUCTION ISSUE  
10-17-2011

REVISIONS	
△	COORDINATION 10-17-2011
△	GARAGE REVISIONS PER SHOP DWGS 01-03-2012
△	COORDINATION 02-29-2012

**KELLER SPRINGS LOFTS**  
LOFT APARTMENTS IN ADDISON, TEXAS



DATE	08-05-2011
PROJECT	11129

SHEET NUMBER	<b>3.2A</b>
BLDG PLAN 'A'	

COPYRIGHT © Beeler Guest Owens Architects ALL RIGHTS RESERVED