



RFD 176

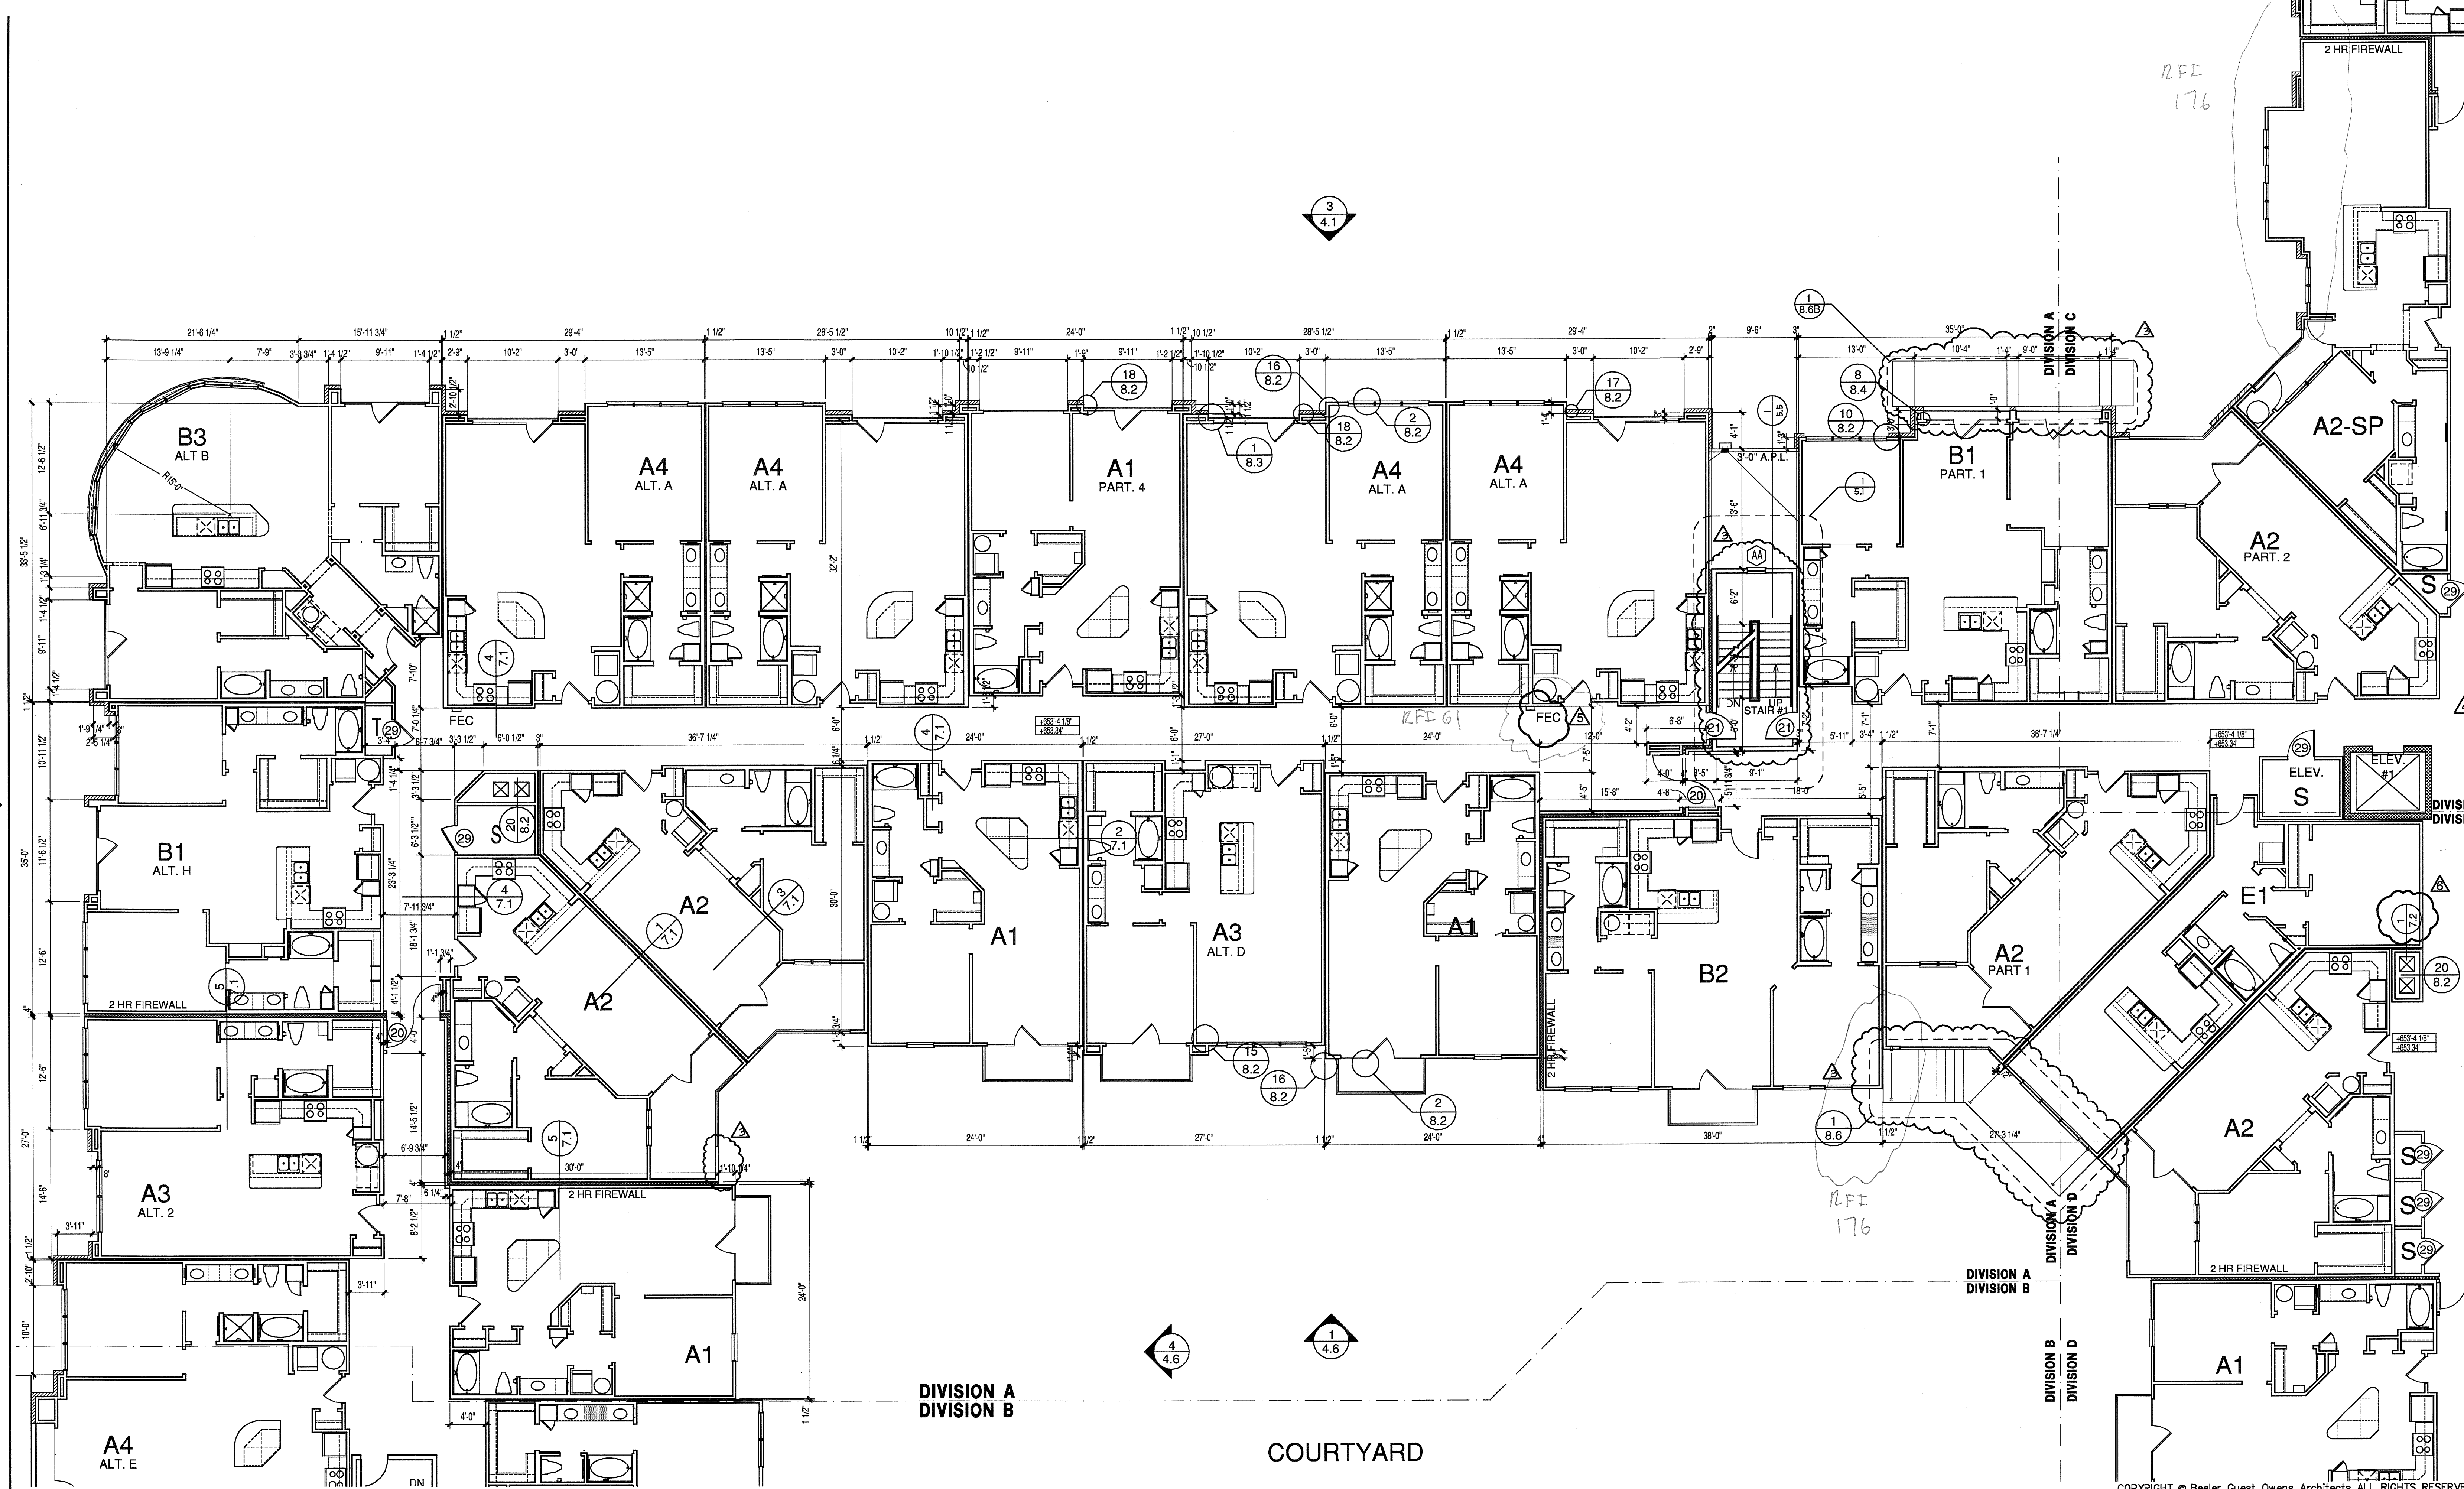

1 DIVISION 'A' SECOND FLOOR PLAN
1/8"=1'-0"

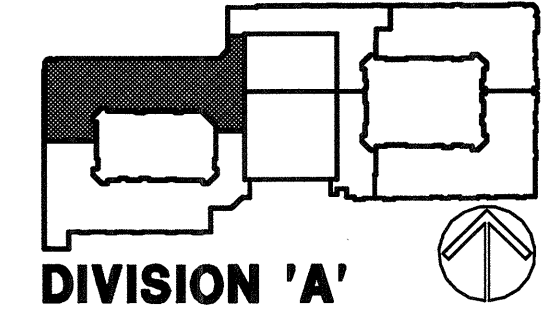

BGO architects
4144 N. Central Expy.
Suite 855
Dallas, TX 75204
214.520.8878
bgoarchitects.com

CONSTRUCTION ISSUE
10-17-2011

REVISIONS	
△ COORDINATION 10-17-2011	△ COORDINATION 04-17-2012
△ GARAGE REVISIONS PER SHOP DWGS 01-03-2012	
△ COORDINATION 02-29-2012	

KELLER SPRINGS LOFTS
LOFT APARTMENTS IN ADDISON, TEXAS

REGISTERED ARCHITECT
O. EARN
22433
STATE OF TEXAS
01-03-2012

DATE
08-05-2011
PROJECT
11129

SHEET NUMBER
3.2A
BLDG PLAN 'A'

COPYRIGHT © Beeler Guest Owens Architects ALL RIGHTS RESERVED