


3
4.1

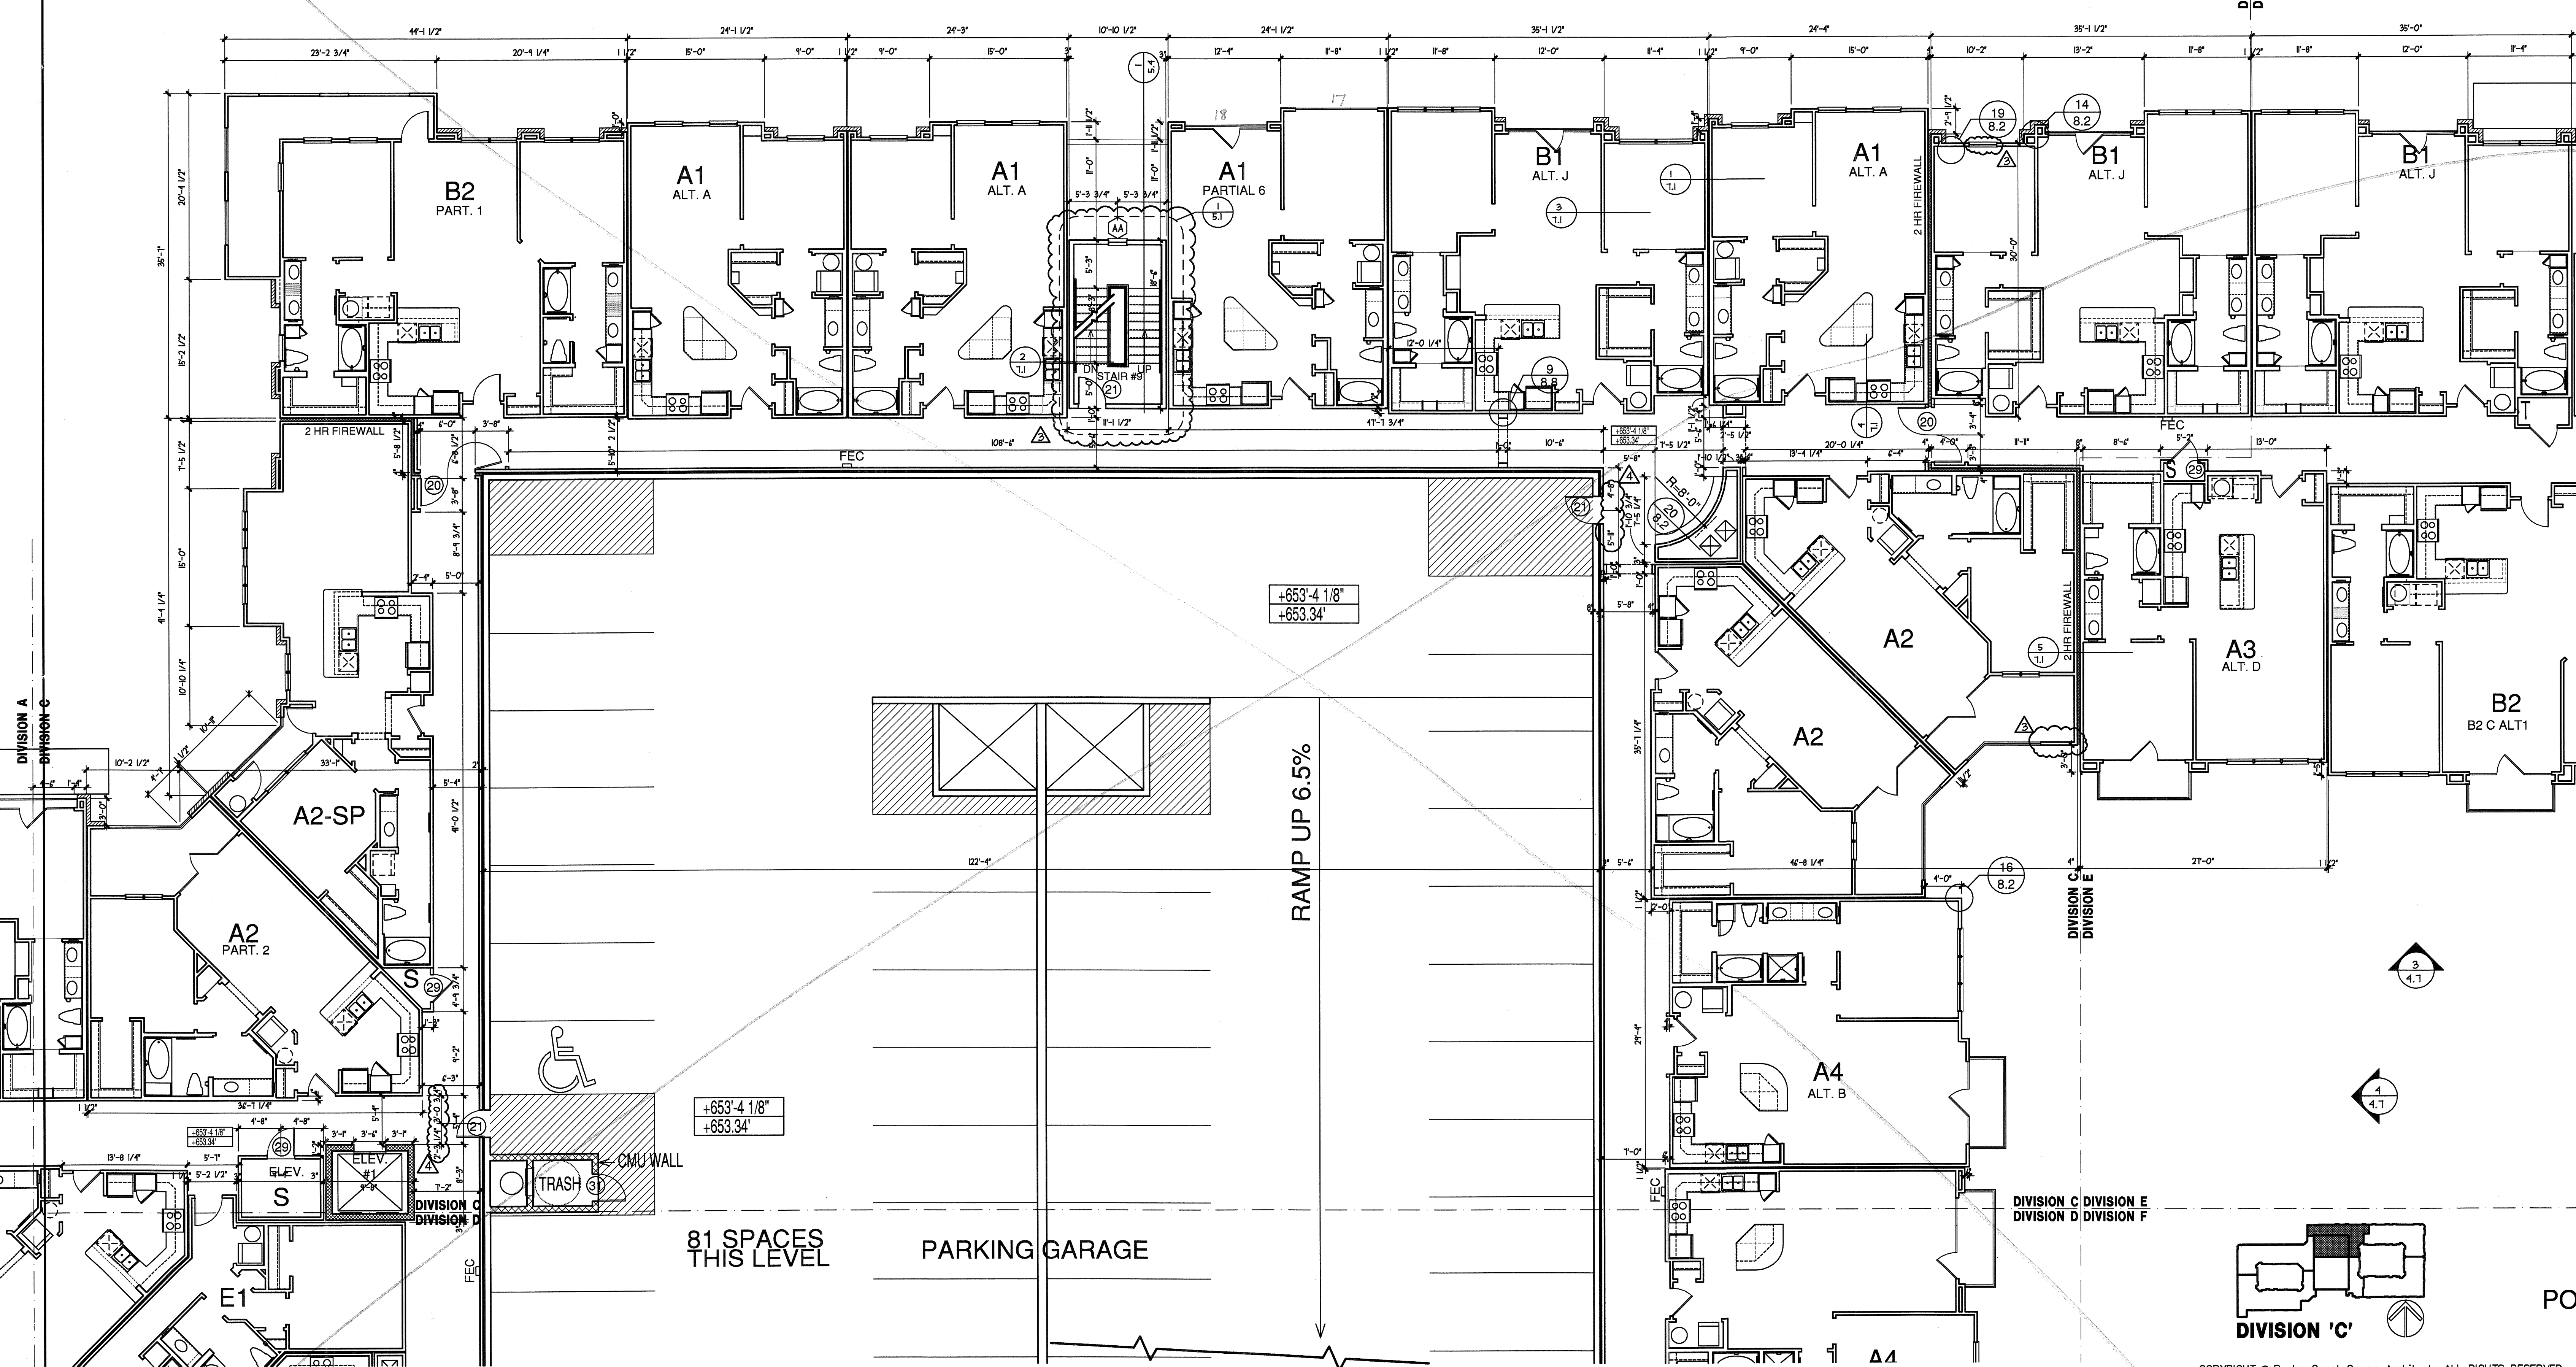


DIVISION A
DIVISION C

DIVISION C
DIVISION E

DIVISION C
DIVISION E

DIVISION C
DIVISION E
DIVISION D
DIVISION F

POC

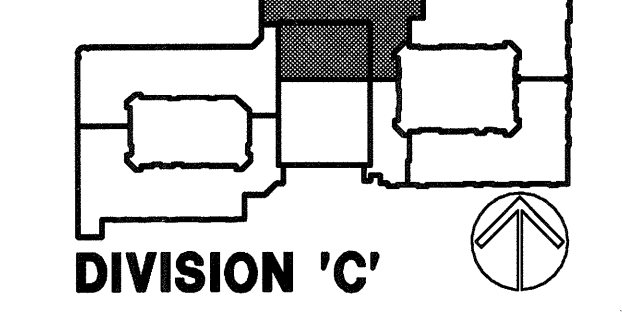

DIVISION 'C'

1 DIVISION 'C' SECOND FLOOR PLAN
1/8" = 1'-0"

<p>BGO architects</p> <p>4144 N. Central Expy. Suite 855 Dallas, TX 75204 214.520.8878 bgoarchitects.com</p>	<p>CONSTRUCTION ISSUE 10-17-2011</p>	<p>REVISIONS</p> <ul style="list-style-type: none"> COORDINATION 10-17-2011 GARAGE REVISIONS PER SHOP DWGS 01-03-2012 	<p>KELLER SPRINGS LOFTS</p> <p>LOFT APARTMENTS IN ADDISON, TEXAS</p>		<p>DATE 08-05-2011</p> <p>PROJECT 11129</p>	<p>SHEET NUMBER 3.2C</p> <p>BLDG PLAN 'C'</p>
	<p>81 SPACES THIS LEVEL PARKING GARAGE</p>		<p>RAMP UP 6.5%</p>	<p>+653'-4 1/8" +653.34'</p>	<p>+653'-4 1/8" +653.34'</p>	<p>DATE 08-05-2011</p> <p>PROJECT 11129</p>

COPYRIGHT © Beeler Guest Owens Architects ALL RIGHTS RESERVED