


3
4.1

DIVISION C
DIVISION E

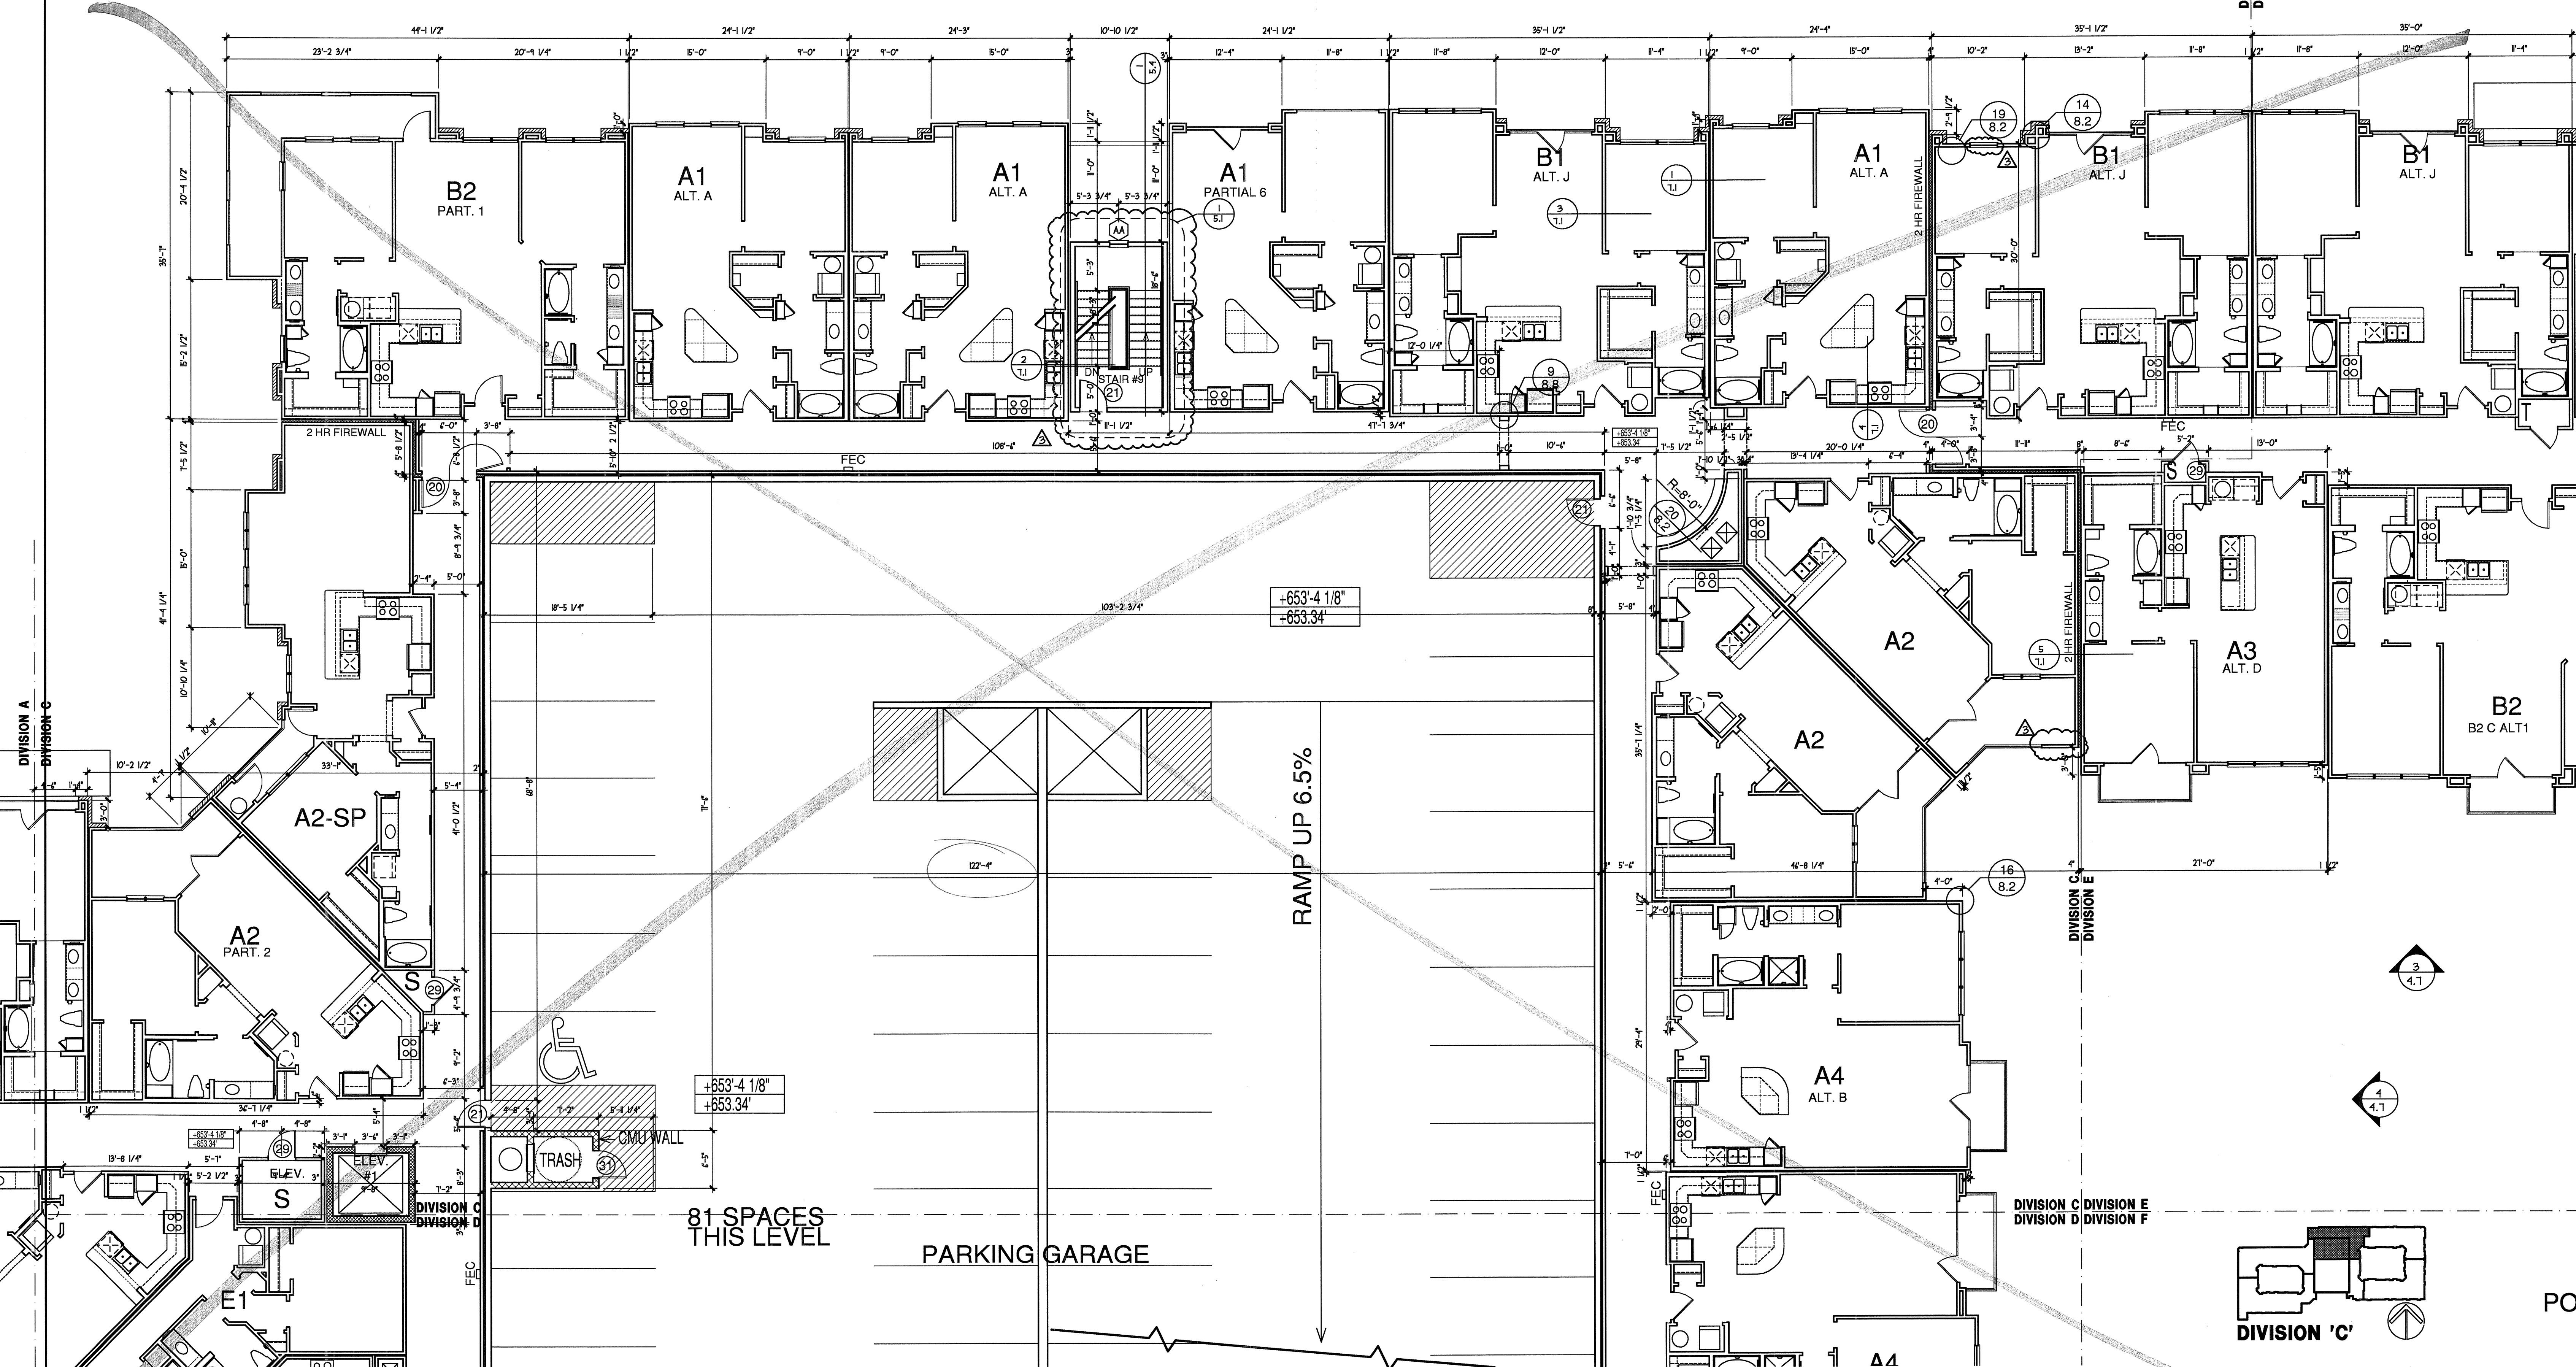

1 DIVISION 'C' SECOND FLOOR PLAN
1/8"=1'-0"

<p>BGO architects</p> <p>4144 N. Central Expy. Suite 855 Dallas, TX 75204 214.520.8878 bgoarchitects.com</p>	<p>CONSTRUCTION ISSUE</p> <p>10-17-2011</p>	<p>REVISIONS</p> <p>COORDINATION</p> <p>10-17-2011</p>	<h1>KELLER SPRINGS LOFTS</h1> <p>LOFT APARTMENTS IN ADDISON, TEXAS</p>		<p>DATE</p> <p>08-05-2011</p>	<p>SHEET NUMBER</p> <p>3.2C</p>
		<p>PROJECT</p> <p>11129</p>			<p>10-17-2011</p>	<p>BLDG PLAN 'C'</p>

COPYRIGHT © Beeler Guest Owens Architects ALL RIGHTS RESERVED

POC