


3  
4.1

DIVISION C  
DIVISION E

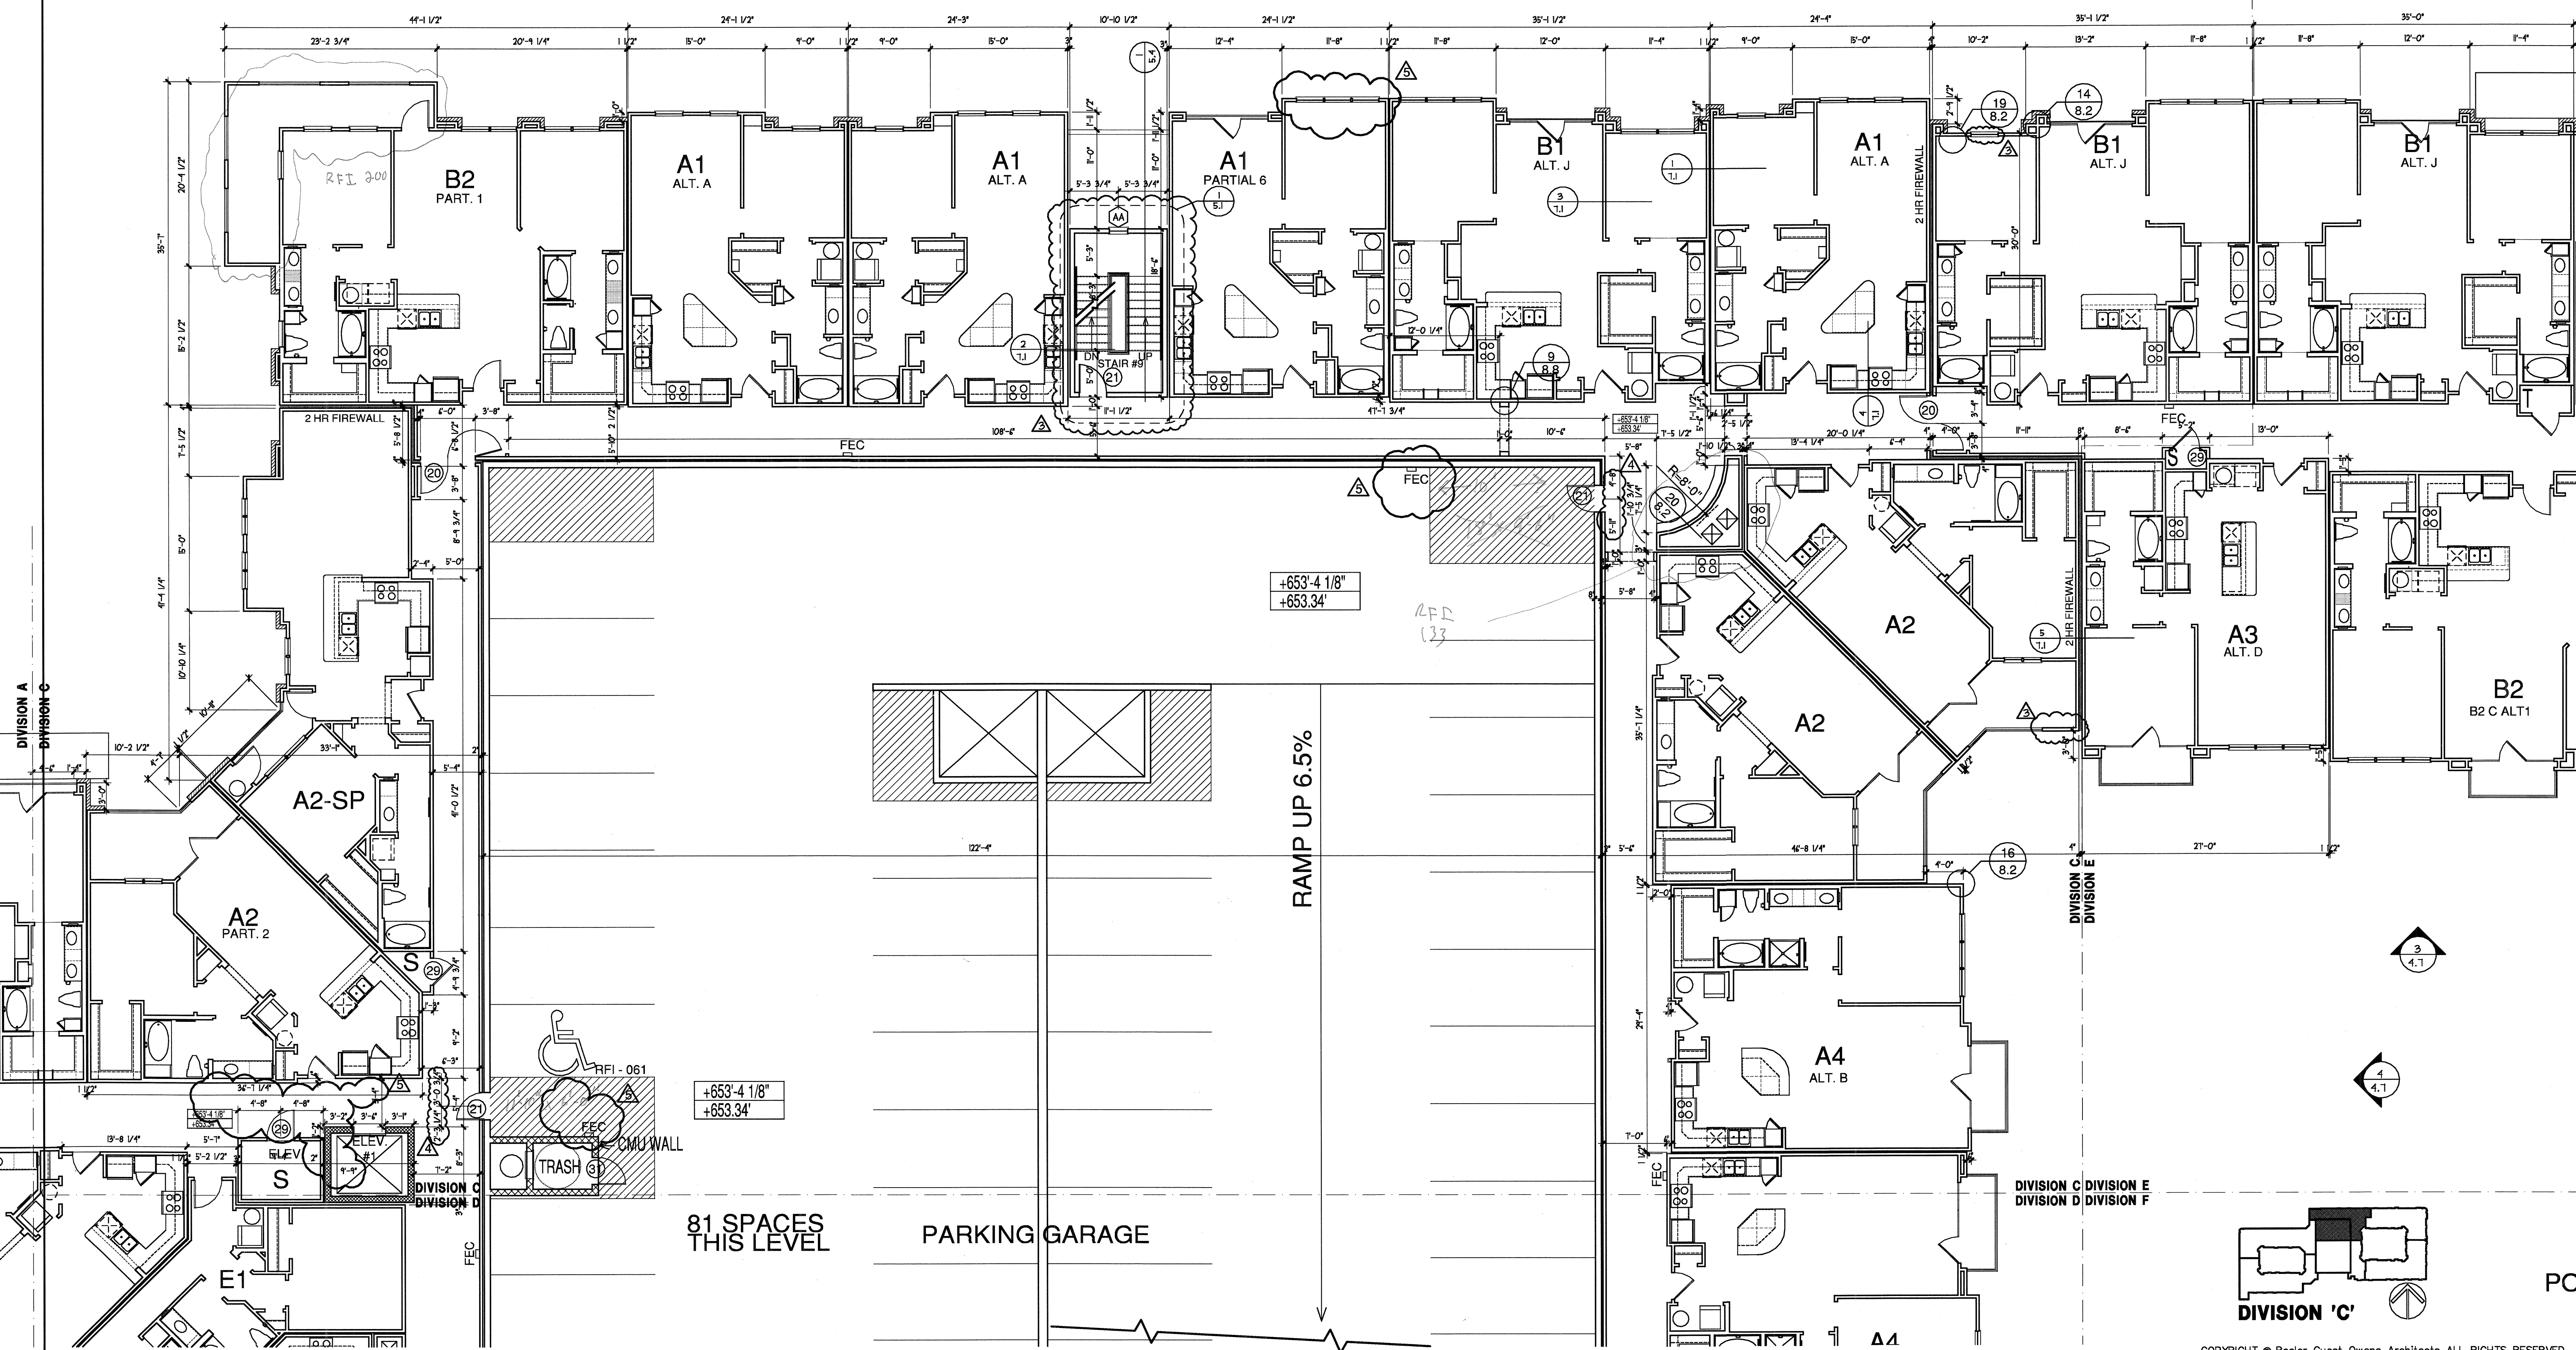


DIVISION A  
DIVISION C

DIVISION C  
DIVISION E

DIVISION C DIVISION E  
DIVISION D DIVISION F

3  
4.1

4  
4.1

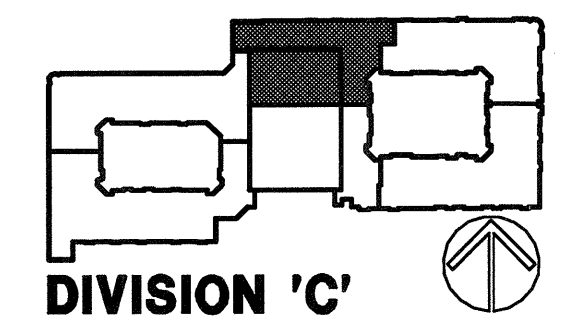

DIVISION 'C'

POC

**1** DIVISION 'C' SECOND FLOOR PLAN  
1/8"=1'-0"

**BGO**  
architects

4144 N. Central Expy.  
Suite 855  
Dallas, TX 75204  
214.520.8878  
bgoarchitects.com

CONSTRUCTION ISSUE  
10-17-2011

REVISIONS

△	COORDINATION	10-17-2011
△	GARAGE REVISIONS PER SHOP DWGS	01-03-2012
△	COORDINATION	02-29-2012

**KELLER SPRINGS LOFTS**

LOFT APARTMENTS IN ADDISON, TEXAS

DATE  
08-05-2011

PROJECT  
11129

SHEET NUMBER  
**3.2C**

BLDG PLAN 'C'

COPYRIGHT © Beeler Guest Owens Architects ALL RIGHTS RESERVED