


1 DIVISION 'D' SECOND FLOOR PLAN
1/8" = 1'-0"

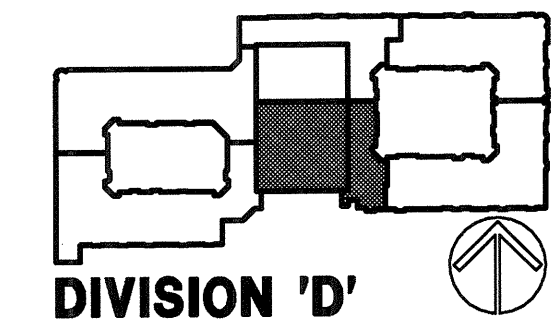

BGO architects
4144 N. Central Expy.
Suite 855
Dallas, TX 75204
214.520.8878
bgoarchitects.com

CONSTRUCTION ISSUE
10-17-2011

REVISIONS

△	COORDINATION	10-17-2011
△	GARAGE REVISIONS PER SHOP DWGS	01-03-2012

KELLER SPRINGS LOFTS

LOFT APARTMENTS IN ADDISON, TEXAS

REGISTERED ARCHITECT
STATE OF TEXAS
22433

DATE: 08-05-2011
PROJECT: 11129
SHEET NUMBER: **3.2D**
BLDG PLAN 'D'

11-12-29

01-03-2012

COPYRIGHT © Beeler Guest Owens Architects ALL RIGHTS RESERVED