

81 SPACES
THIS LEVEL


PARKING GARAGE

RAMP DN 6.5%

+653'-4 1/8"
+653.34'

COPYRIGHT © Beeler Guest Owens Architects ALL RIGHTS RESERVED

1 DIVISION 'D' SECOND FLOOR PLAN
1/8" = 1'-0"

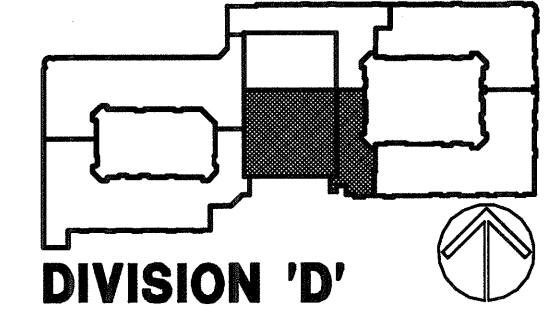

BGO
architects
4144 N. Central Expy.
Suite 855
Dallas, TX 75204
214.520.8878
bgoarchitects.com

CONSTRUCTION ISSUE
10-17-2011

REVISIONS

△	COORDINATION	10-17-2011
△	GARAGE REVISIONS PER SHOP DWGS	01-03-2012
△	COORDINATION	02-29-2012

KELLER SPRINGS LOFTS
LOFT APARTMENTS IN ADDISON, TEXAS

DATE
08-05-2011
PROJECT
11129

SHEET NUMBER
3.2D
BLDG PLAN 'D'