


DIVISION C DIVISION E
DIVISION D DIVISION F

DIVISION E
DIVISION F

DIVISION E
DIVISION F

POOL AND AMENITY

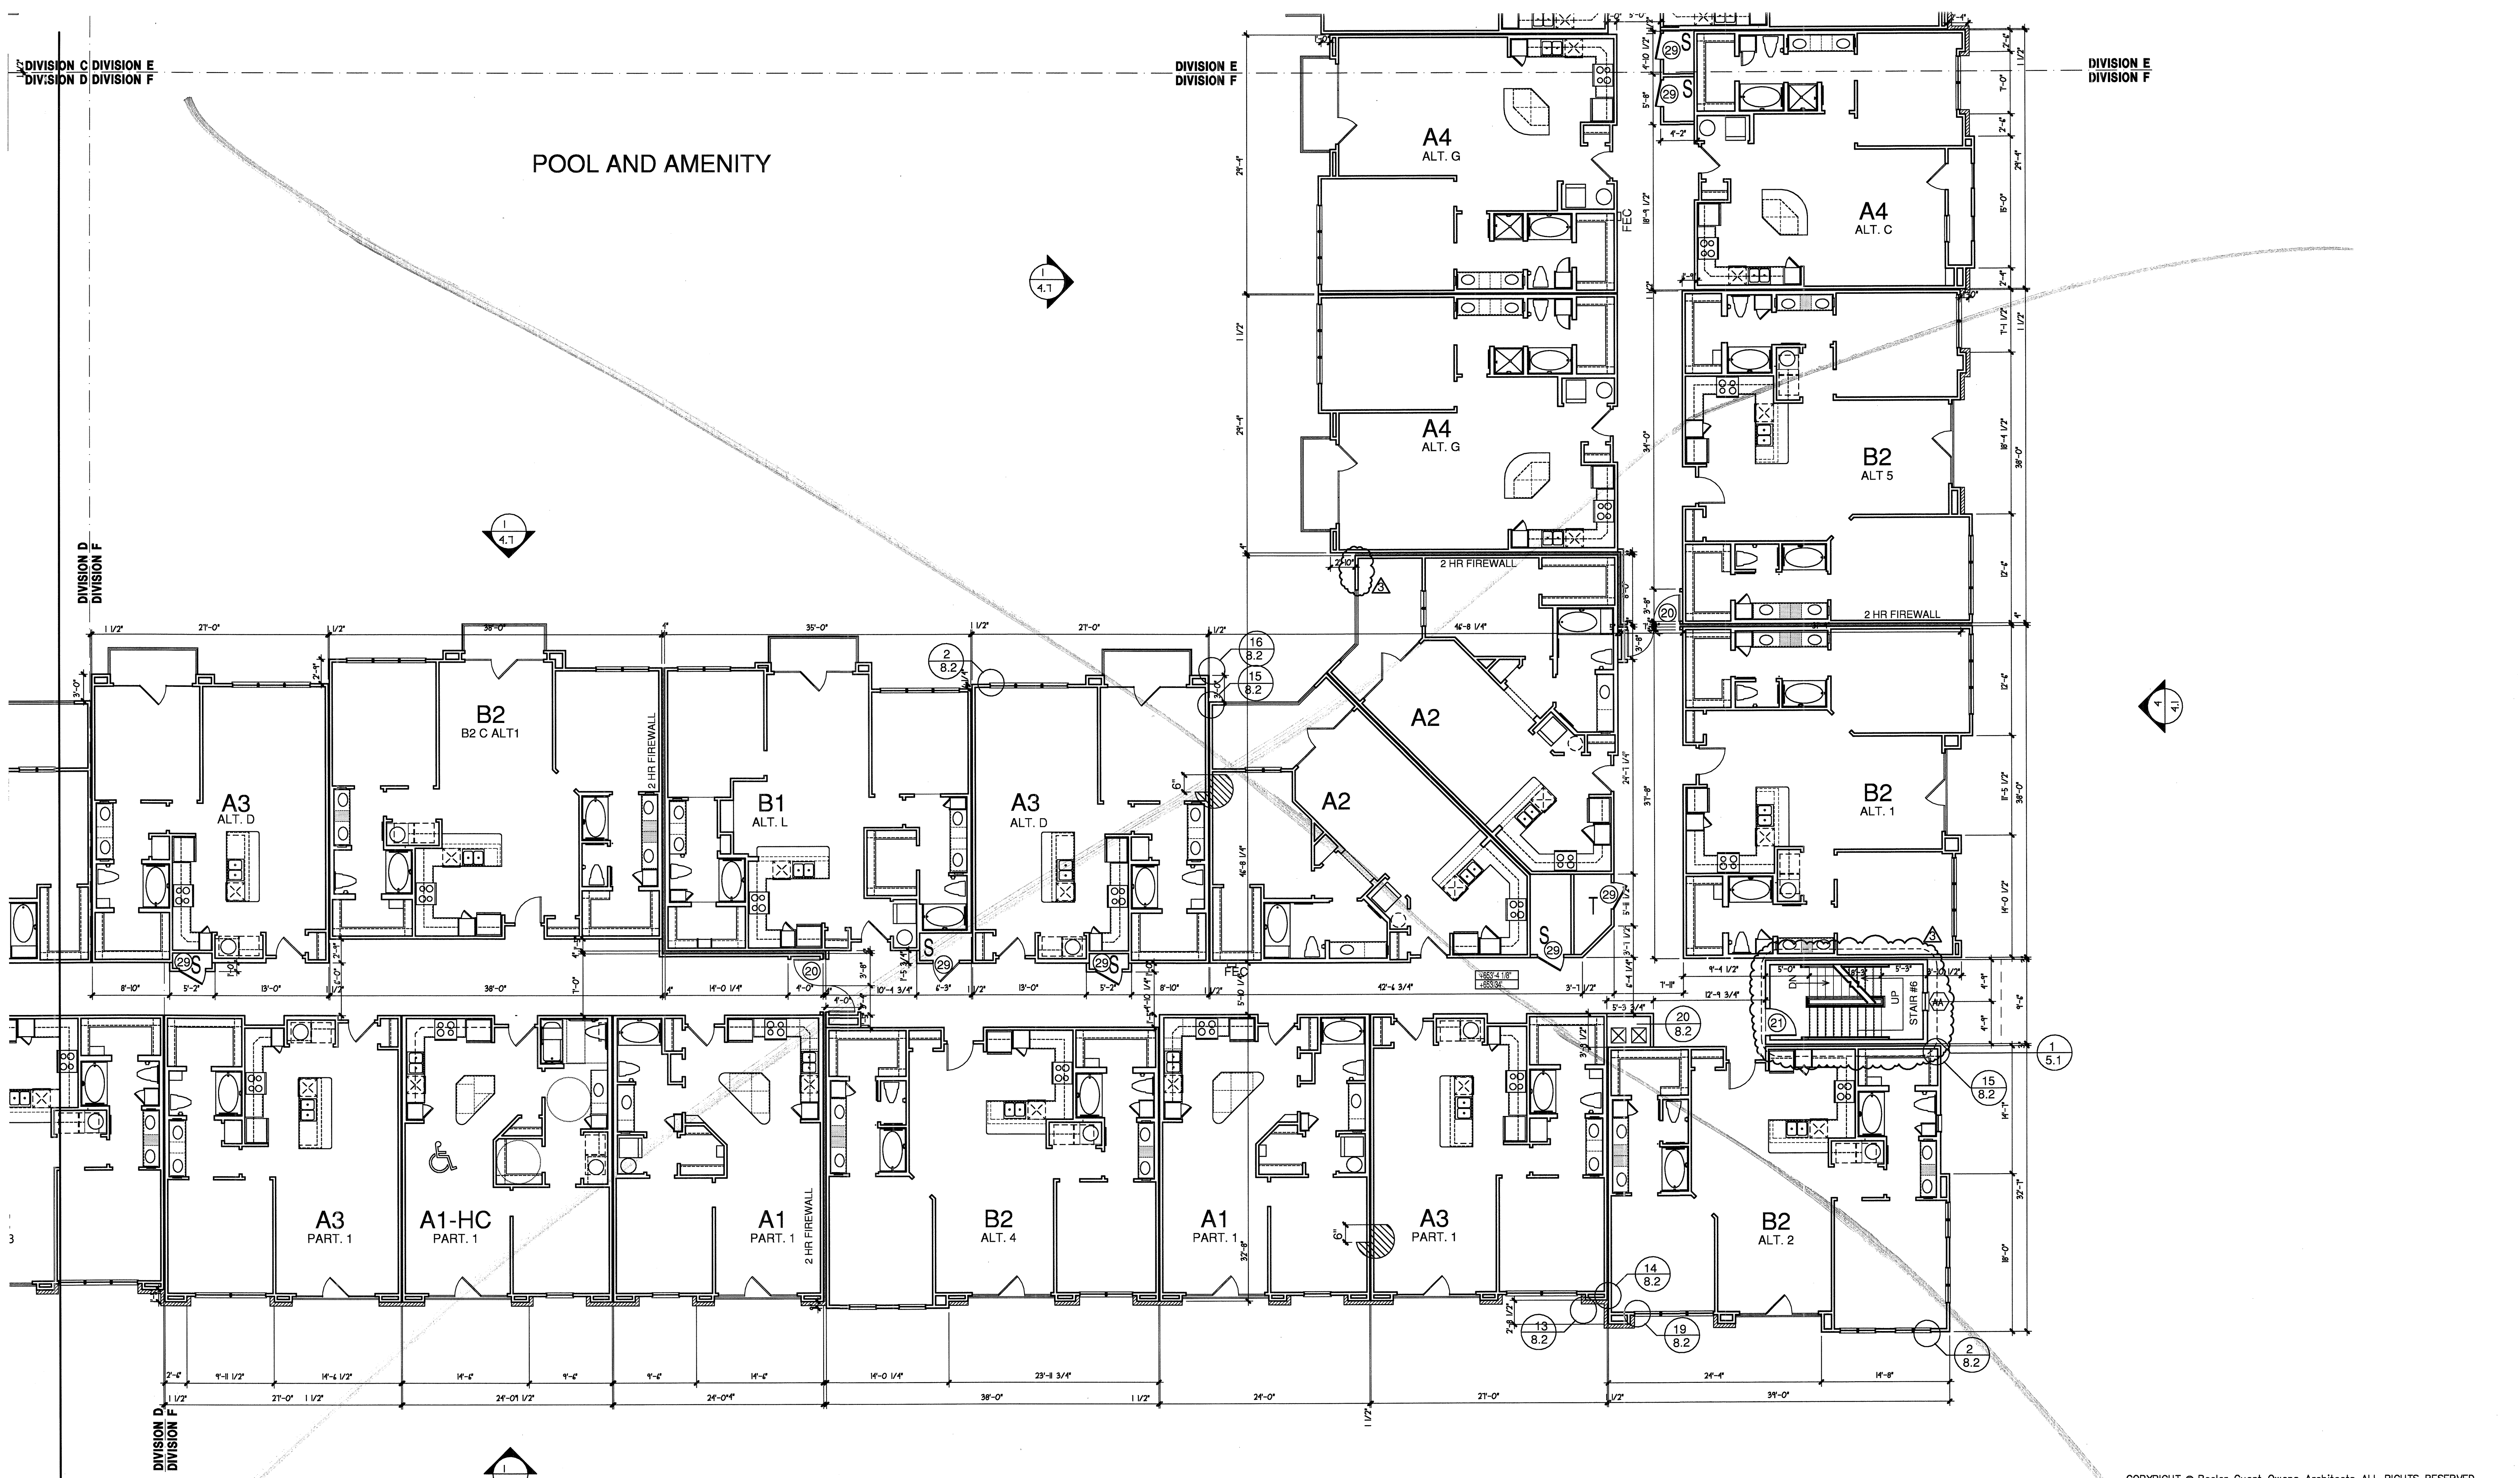

1 DIVISION 'F' SECOND FLOOR PLAN
1/8"=1'-0"

DIVISION 'F'

BGO
architects

4144 N. Central Expy.
Suite 855
Dallas, TX 75204
214.520.8878
bgoarchitects.com

CONSTRUCTION ISSUE
10-17-2011

REVISIONS

1	COORDINATION	10-17-2011
---	--------------	------------

KELLER SPRINGS LOFTS

LOFT APARTMENTS IN ADDISON, TEXAS

REGISTERED ARCHITECT
D. EARL
22433
STATE OF TEXAS

10-17-2011

COPYRIGHT © Beeler Guest Owens Architects ALL RIGHTS RESERVED

DATE
08-05-2011

PROJECT
11129

SHEET NUMBER
3.2F
BLDG PLAN 'F'