


DIVISION C DIVISION E  
DIVISION D DIVISION F

DIVISION E  
DIVISION F

DIVISION E  
DIVISION F

# POOL AND AMENITY

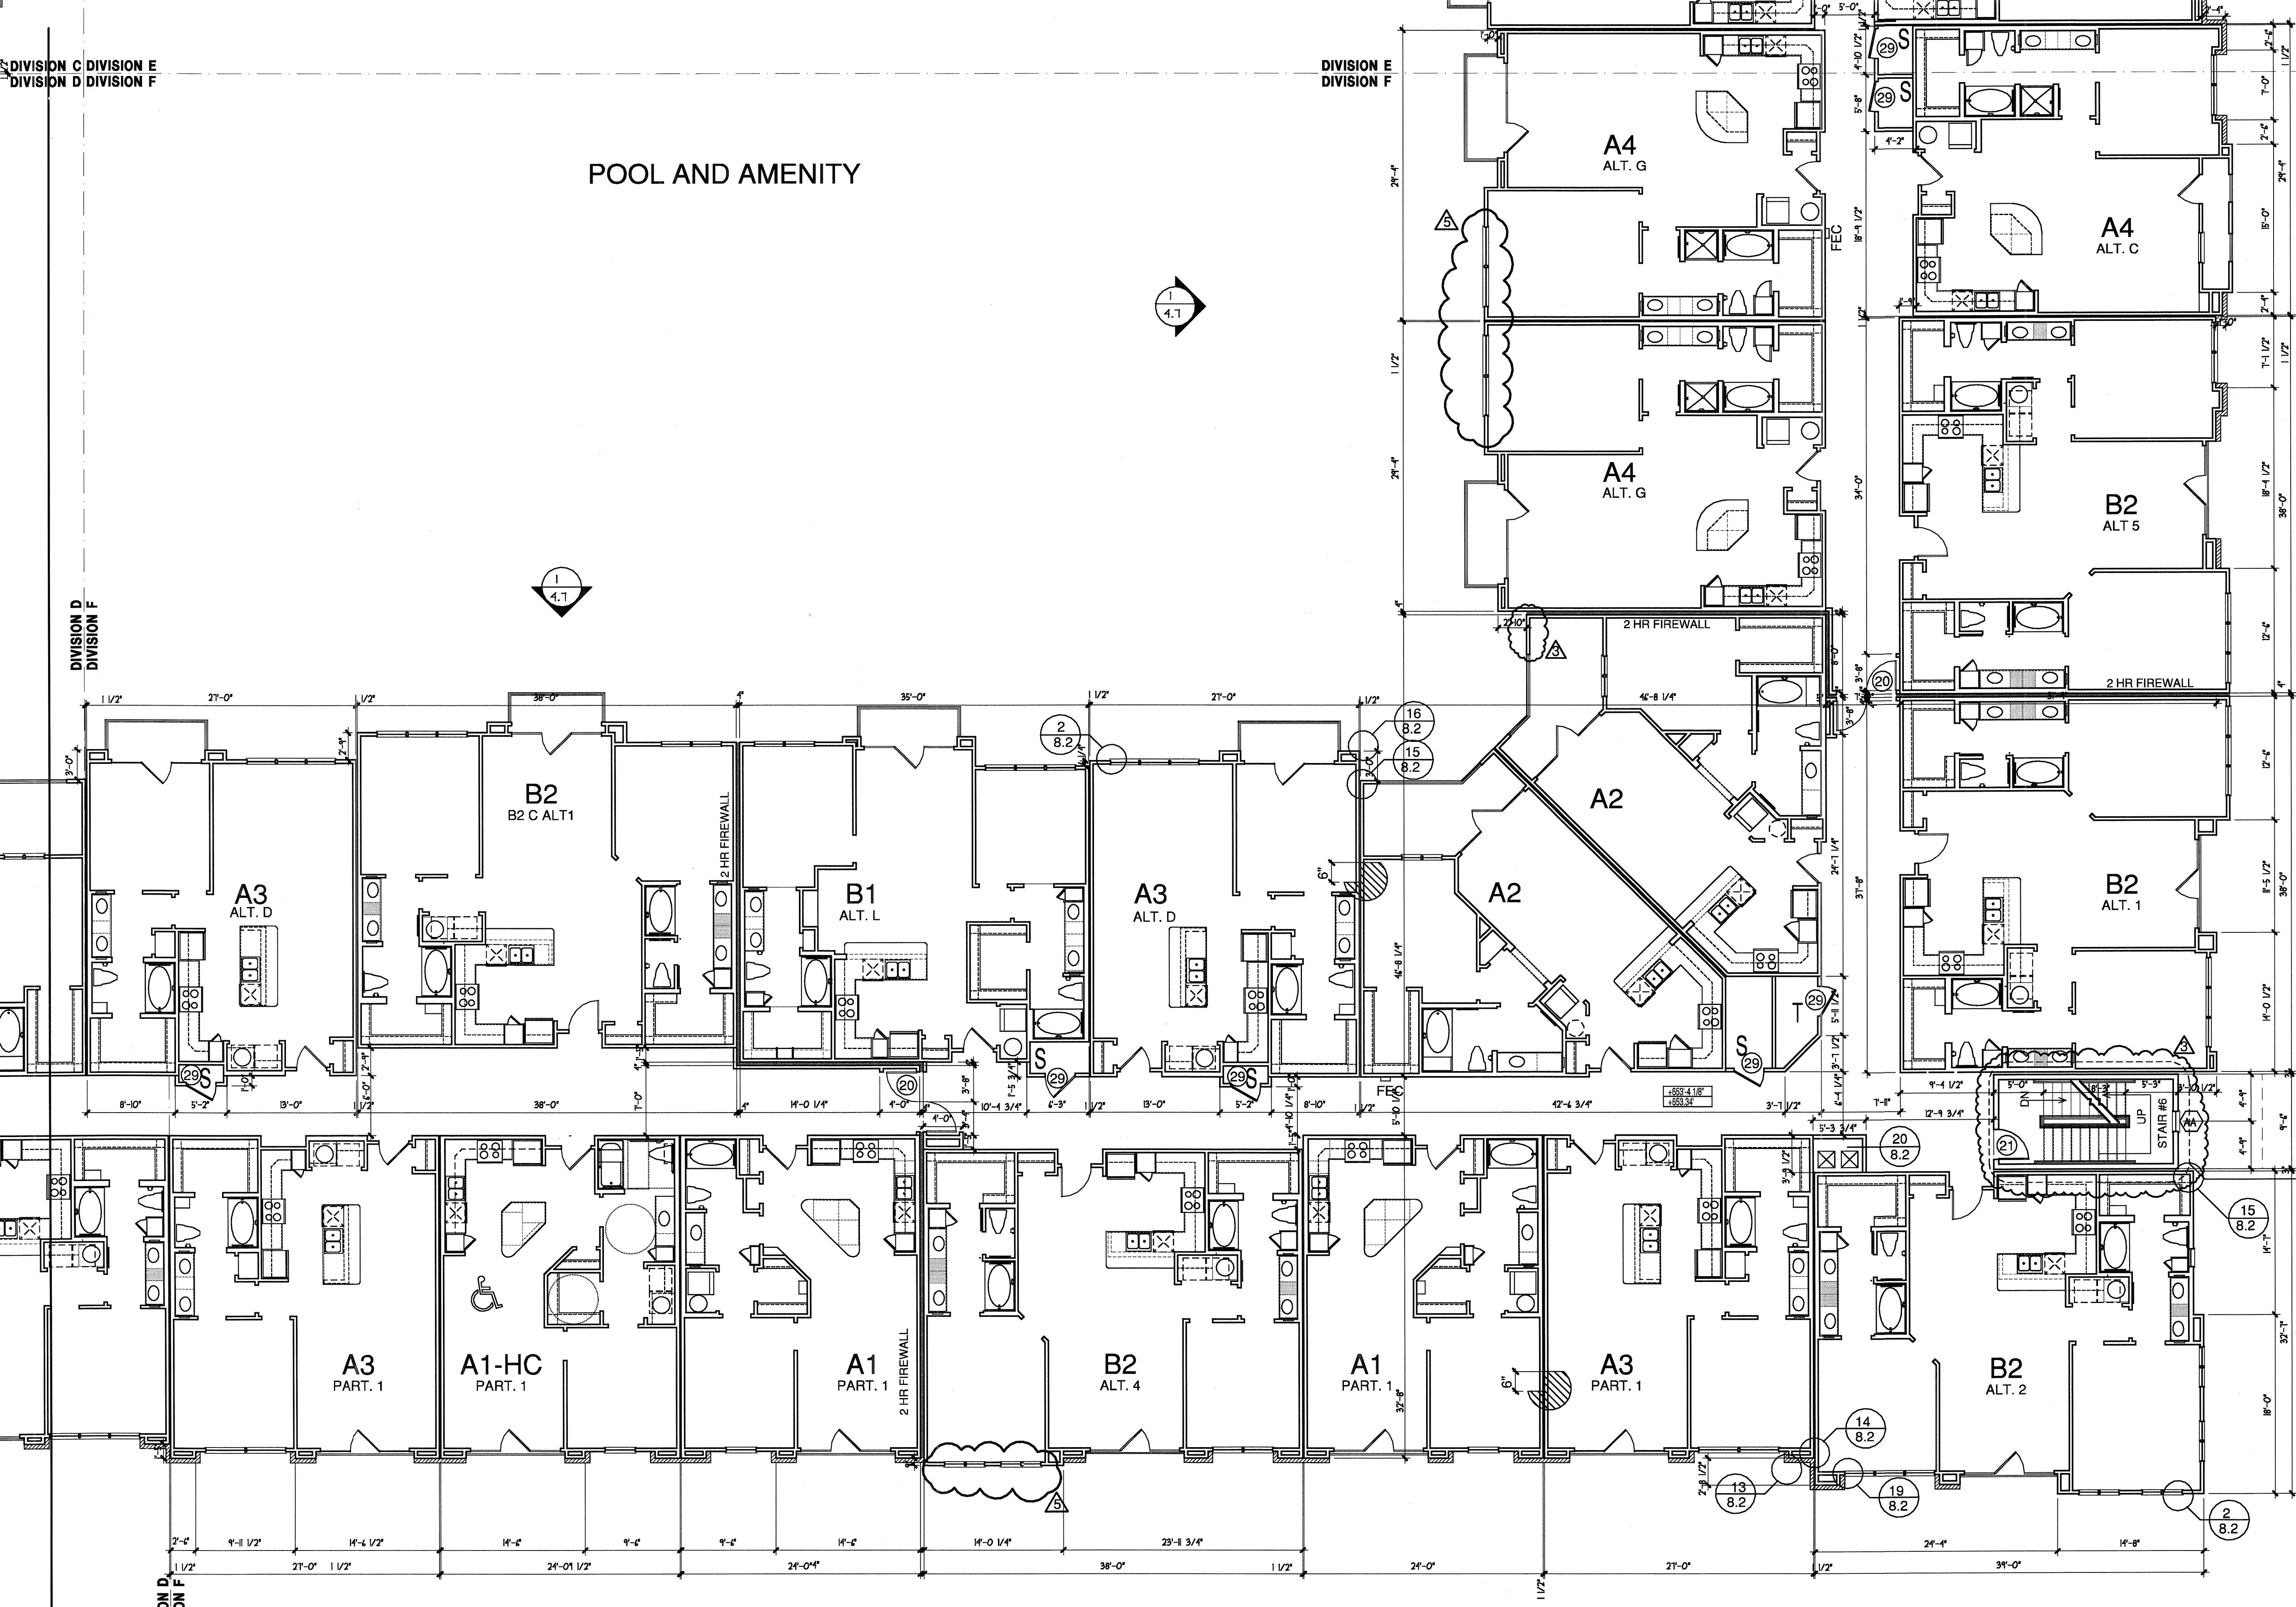

**1** DIVISION 'F' SECOND FLOOR PLAN  
1/8"=1'-0"

**DIVISION 'F'**

**BGO**  
architects

4144 N. Central Exp.  
Suite 855  
Dallas, TX 75204  
214.520.8878  
bgoarchitects.com

CONSTRUCTION ISSUE  
10-17-2011

REVISIONS

|              |            |
|--------------|------------|
| COORDINATION | 10-17-2011 |
| COORDINATION | 02-29-2012 |

**KELLER SPRINGS LOFTS**

LOFT APARTMENTS IN ADDISON, TEXAS

REGISTERED ARCHITECT  
S.O. EARL  
2243  
STATE OF TEXAS

01-03-2012

COPYRIGHT © Beeler Guest Owens Architects ALL RIGHTS RESERVED

DATE  
08-05-2011

PROJECT  
11129

SHEET NUMBER  
**3.2F**  
BLDG PLAN 'F'