


1 DIVISION 'A' THIRD FLOOR PLAN
1/8" = 1'-0"

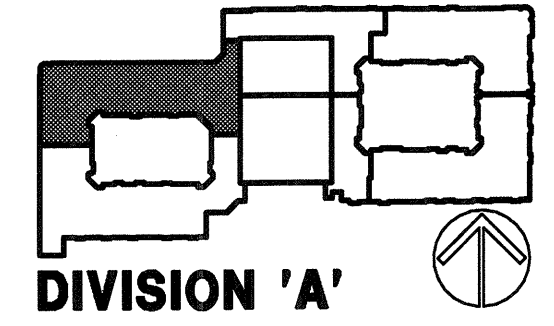

BGO
architects
4144 N. Central Expy.
Suite 855
Dallas, TX 75204
214.520.8878
bgoarchitects.com

CONSTRUCTION ISSUE
10-17-2011

REVISIONS
 1 COORDINATION
 10-17-2011
 2 GARAGE REVISIONS
 PER SHOP DWGS
 01-03-2012

KELLER SPRINGS LOFTS
LOFT APARTMENTS IN ADDISON, TEXAS



DATE
08-05-2011
PROJECT
11129

SHEET NUMBER
3.3A
BLDG PLAN 'A'

COPYRIGHT © Beeler Guest Owens Architects ALL RIGHTS RESERVED