


**DIVISION 'A' THIRD FLOOR PLAN**

1/8" = 1'-0"

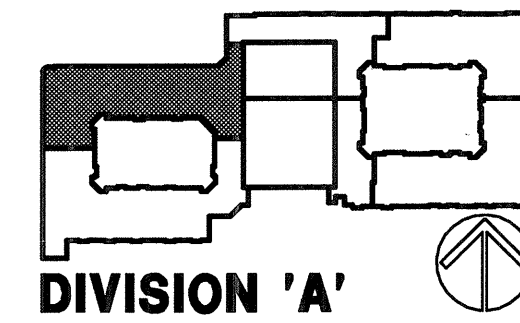

**BGO**  
architects

4144 N. Central Expy.  
Suite 855  
Dallas, TX 75204  
214.520.8878  
bgoarchitects.com

CONSTRUCTION ISSUE  
10-17-2011

REVISIONS

**KELLER SPRINGS LOFTS**

LOFT APARTMENTS IN ADDISON, TEXAS

REGISTERED ARCHITECT  
STATE OF TEXAS

10-17-2011

DATE  
08-05-2011

PROJECT  
11129

SHEET NUMBER  
**3.3A**  
BLDG PLAN 'A'

COPYRIGHT © Beeler Guest Owens Architects ALL RIGHTS RESERVED