


1 DIVISION 'A' THIRD FLOOR PLAN
1/8" = 1'-0"

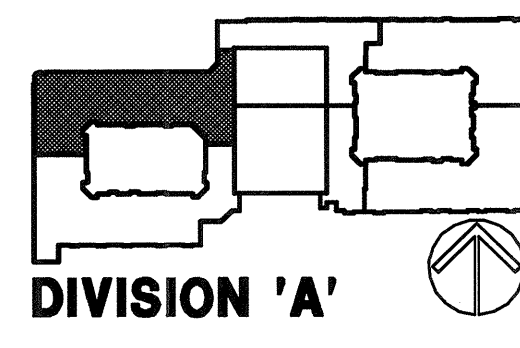

BGO
architects
4144 N. Central Expy.
Suite 855
Dallas, TX 75204
214.520.8878
bgoarchitects.com

CONSTRUCTION ISSUE
10-17-2011

REVISIONS	
△	COORDINATION 10-17-2011
△	GARAGE REVISIONS PER SHOP DWGS 01-03-2012
△	COORDINATION 02-29-2012

KELLER SPRINGS LOFTS
LOFT APARTMENTS IN ADDISON, TEXAS

DATE
08-05-2011
PROJECT
11129
01-03-2012

DATE
08-05-2011
PROJECT
11129

SHEET NUMBER
3.3A
BLDG PLAN 'A'

COPYRIGHT © Beeler Guest Owens Architects ALL RIGHTS RESERVED