


+664'-1"
+664.08'

+664'-1"
+664.08'

81 SPACES
THIS LEVEL

PARKING GARAGE

RAMP UP 6.5%

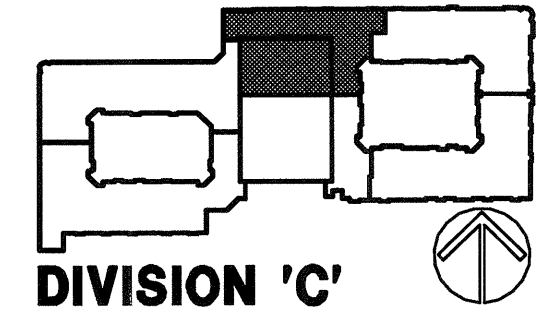

DIVISION 'C'

COPYRIGHT © Beeler Guest Owens Architects ALL RIGHTS RESERVED

BGO
architects

4144 N. Central Expy.
Suite 855
Dallas, TX 75204
214.520.8878
bgoarchitects.com

CONSTRUCTION ISSUE
10-17-2011

- REVISIONS
- COORDINATION 10-17-2011
 - GARAGE REVISIONS PER SHOP DWGS 01-03-2012
 - COORDINATION 02-29-2012

KELLER SPRINGS LOFTS

LOFT APARTMENTS IN ADDISON, TEXAS

REGISTERED ARCHITECT
O. E. EARL
22433
STATE OF TEXAS

01-03-2012

DATE
08-05-2011

PROJECT
11129

SHEET NUMBER
3.3C
BLDG PLAN 'C'