

81 SPACES
THIS LEVEL

PARKING GARAGE


RAMP DN 6.5%

POC

+664'-1"
+664.08'

COPYRIGHT © Beeler Guest Owens Architects ALL RIGHTS RESERVED

1 DIVISION 'D' THIRD FLOOR PLAN
1/8" = 1'-0"

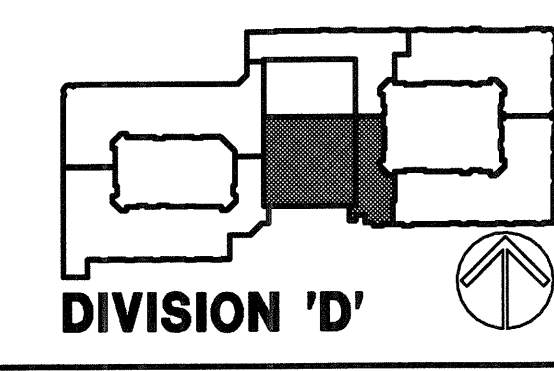

BGO
architects

4144 N. Central Exp.
Suite 855
Dallas, TX 75204
214.520.8878
bgoarchitects.com

CONSTRUCTION ISSUE
10-17-2011

REVISIONS

- COORDINATION 10-17-2011
- GARAGE REVISIONS PER SHOP DWGS 01-03-2012

KELLER SPRINGS LOFTS

LOFT APARTMENTS IN ADDISON, TEXAS

01-03-2012

DATE
08-05-2011

PROJECT
11129

SHEET NUMBER
3.3D

BLDG PLAN 'D'