

81 SPACES  
THIS LEVEL

PARKING GARAGE

RAMP DN 6.5%

DIVISION C DIVISION E  
DIVISION D DIVISION F


POC

+664'-1"  
+664.08'

COPYRIGHT © Beeler Guest Owens Architects ALL RIGHTS RESERVED

**1** DIVISION 'D' THIRD FLOOR PLAN

1/8"=1'-0"

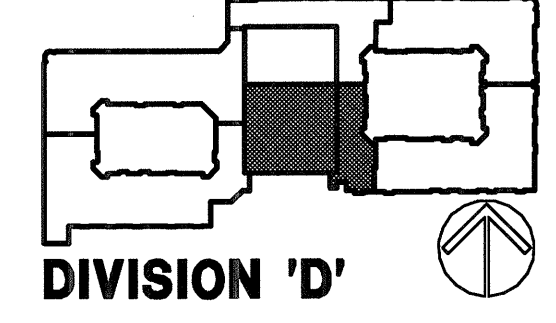

**BGO**  
architects  
4144 N. Central Expy.  
Suite 855  
Dallas, TX 75204  
214.520.8878  
bgoarchitects.com

CONSTRUCTION ISSUE  
10-17-2011

REVISIONS
COORDINATION 10-17-2011

**KELLER SPRINGS LOFTS**  
LOFT APARTMENTS IN ADDISON, TEXAS

DATE  
08-05-2011  
PROJECT  
11129

SHEET NUMBER  
**3.3D**  
BLDG PLAN 'D'