


81 SPACES  
THIS LEVEL


PARKING GARAGE

RAMP DN 6.5%

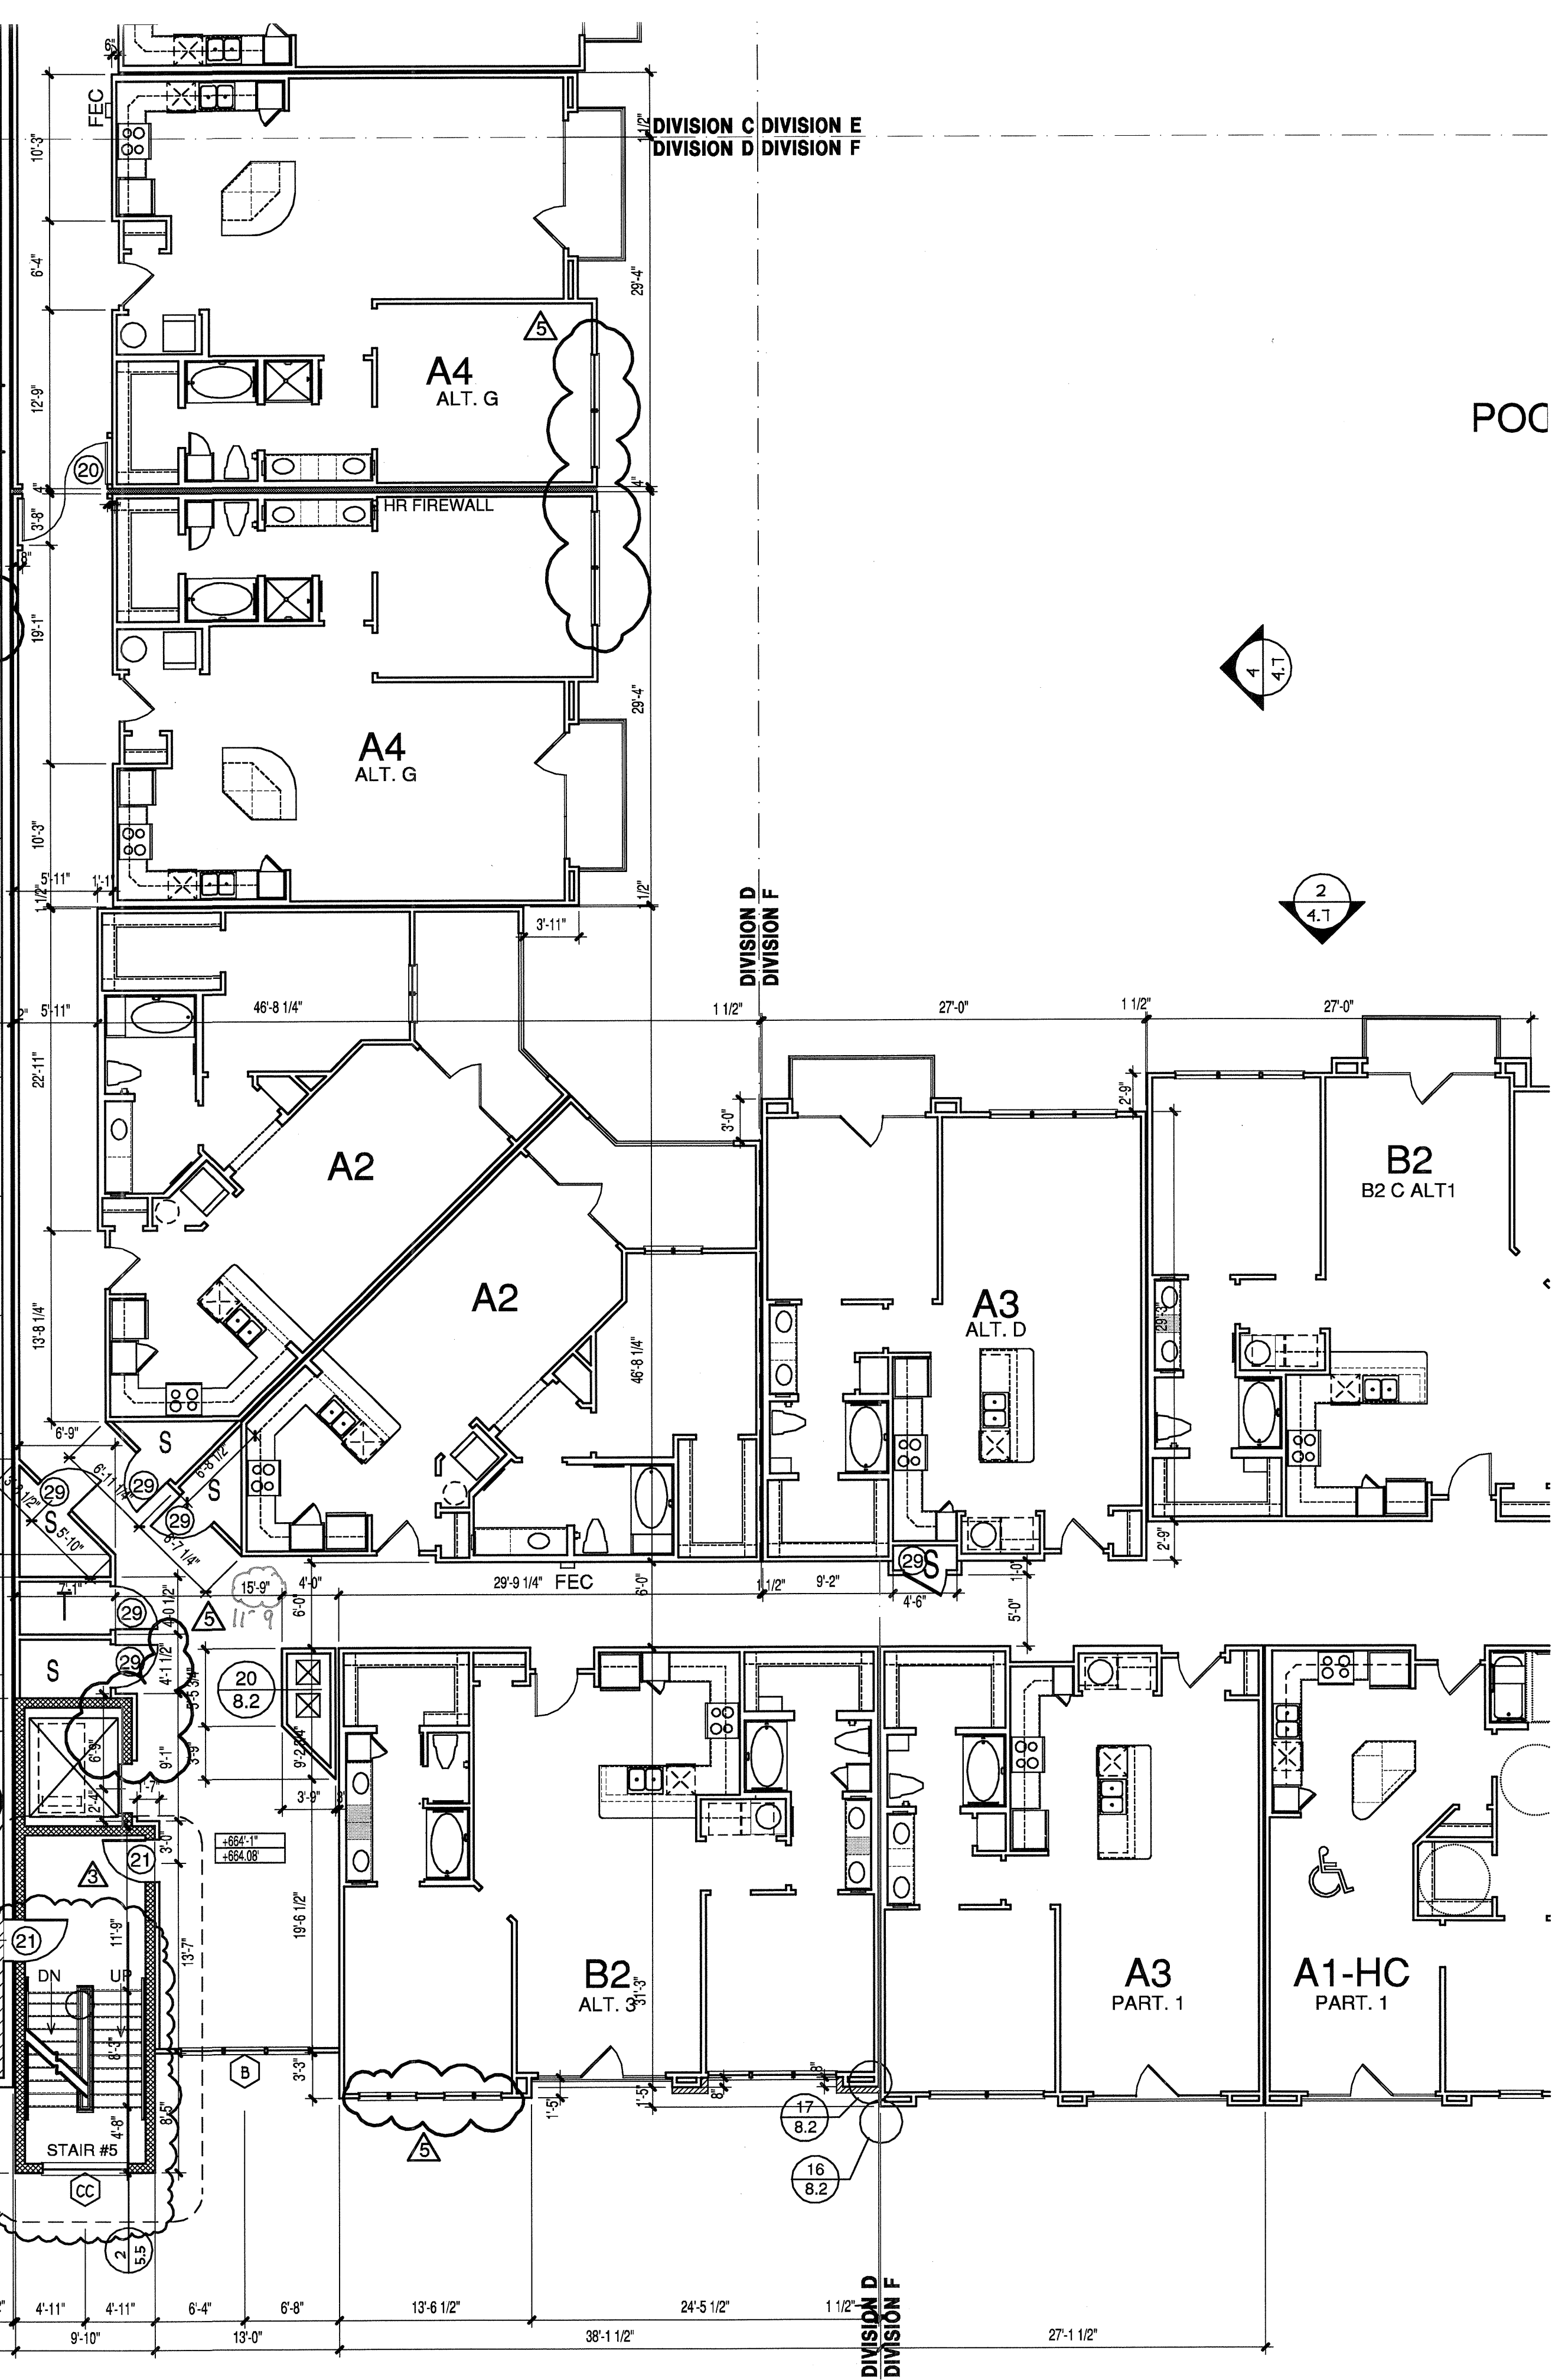

**1** DIVISION 'D' THIRD FLOOR PLAN

1/8"=1'-0"

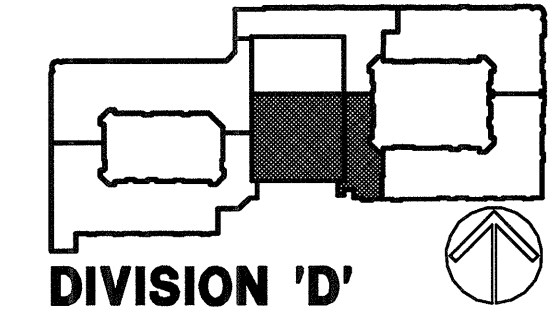

**BGO**  
architects

4144 N. Central Expy.  
Suite 855  
Dallas, TX 75204  
214.520.8878  
bgoarchitects.com

CONSTRUCTION ISSUE  
10-17-2011

REVISIONS

- COORDINATION 10-17-2011
- GARAGE REVISIONS PER SHOP DWGS 01-03-2012
- COORDINATION 02-29-2012

**KELLER SPRINGS LOFTS**

LOFT APARTMENTS IN ADDISON, TEXAS

01-03-2012

DATE  
08-05-2011

PROJECT  
11129

SHEET NUMBER  
**3.3D**

BLDG PLAN 'D'

COPYRIGHT © Beeler Guest Owens Architects ALL RIGHTS RESERVED