


DIVISION C DIVISION E
DIVISION D DIVISION F

DIVISION E
DIVISION F

DIVISION E
DIVISION F

POOL AND AMENITY

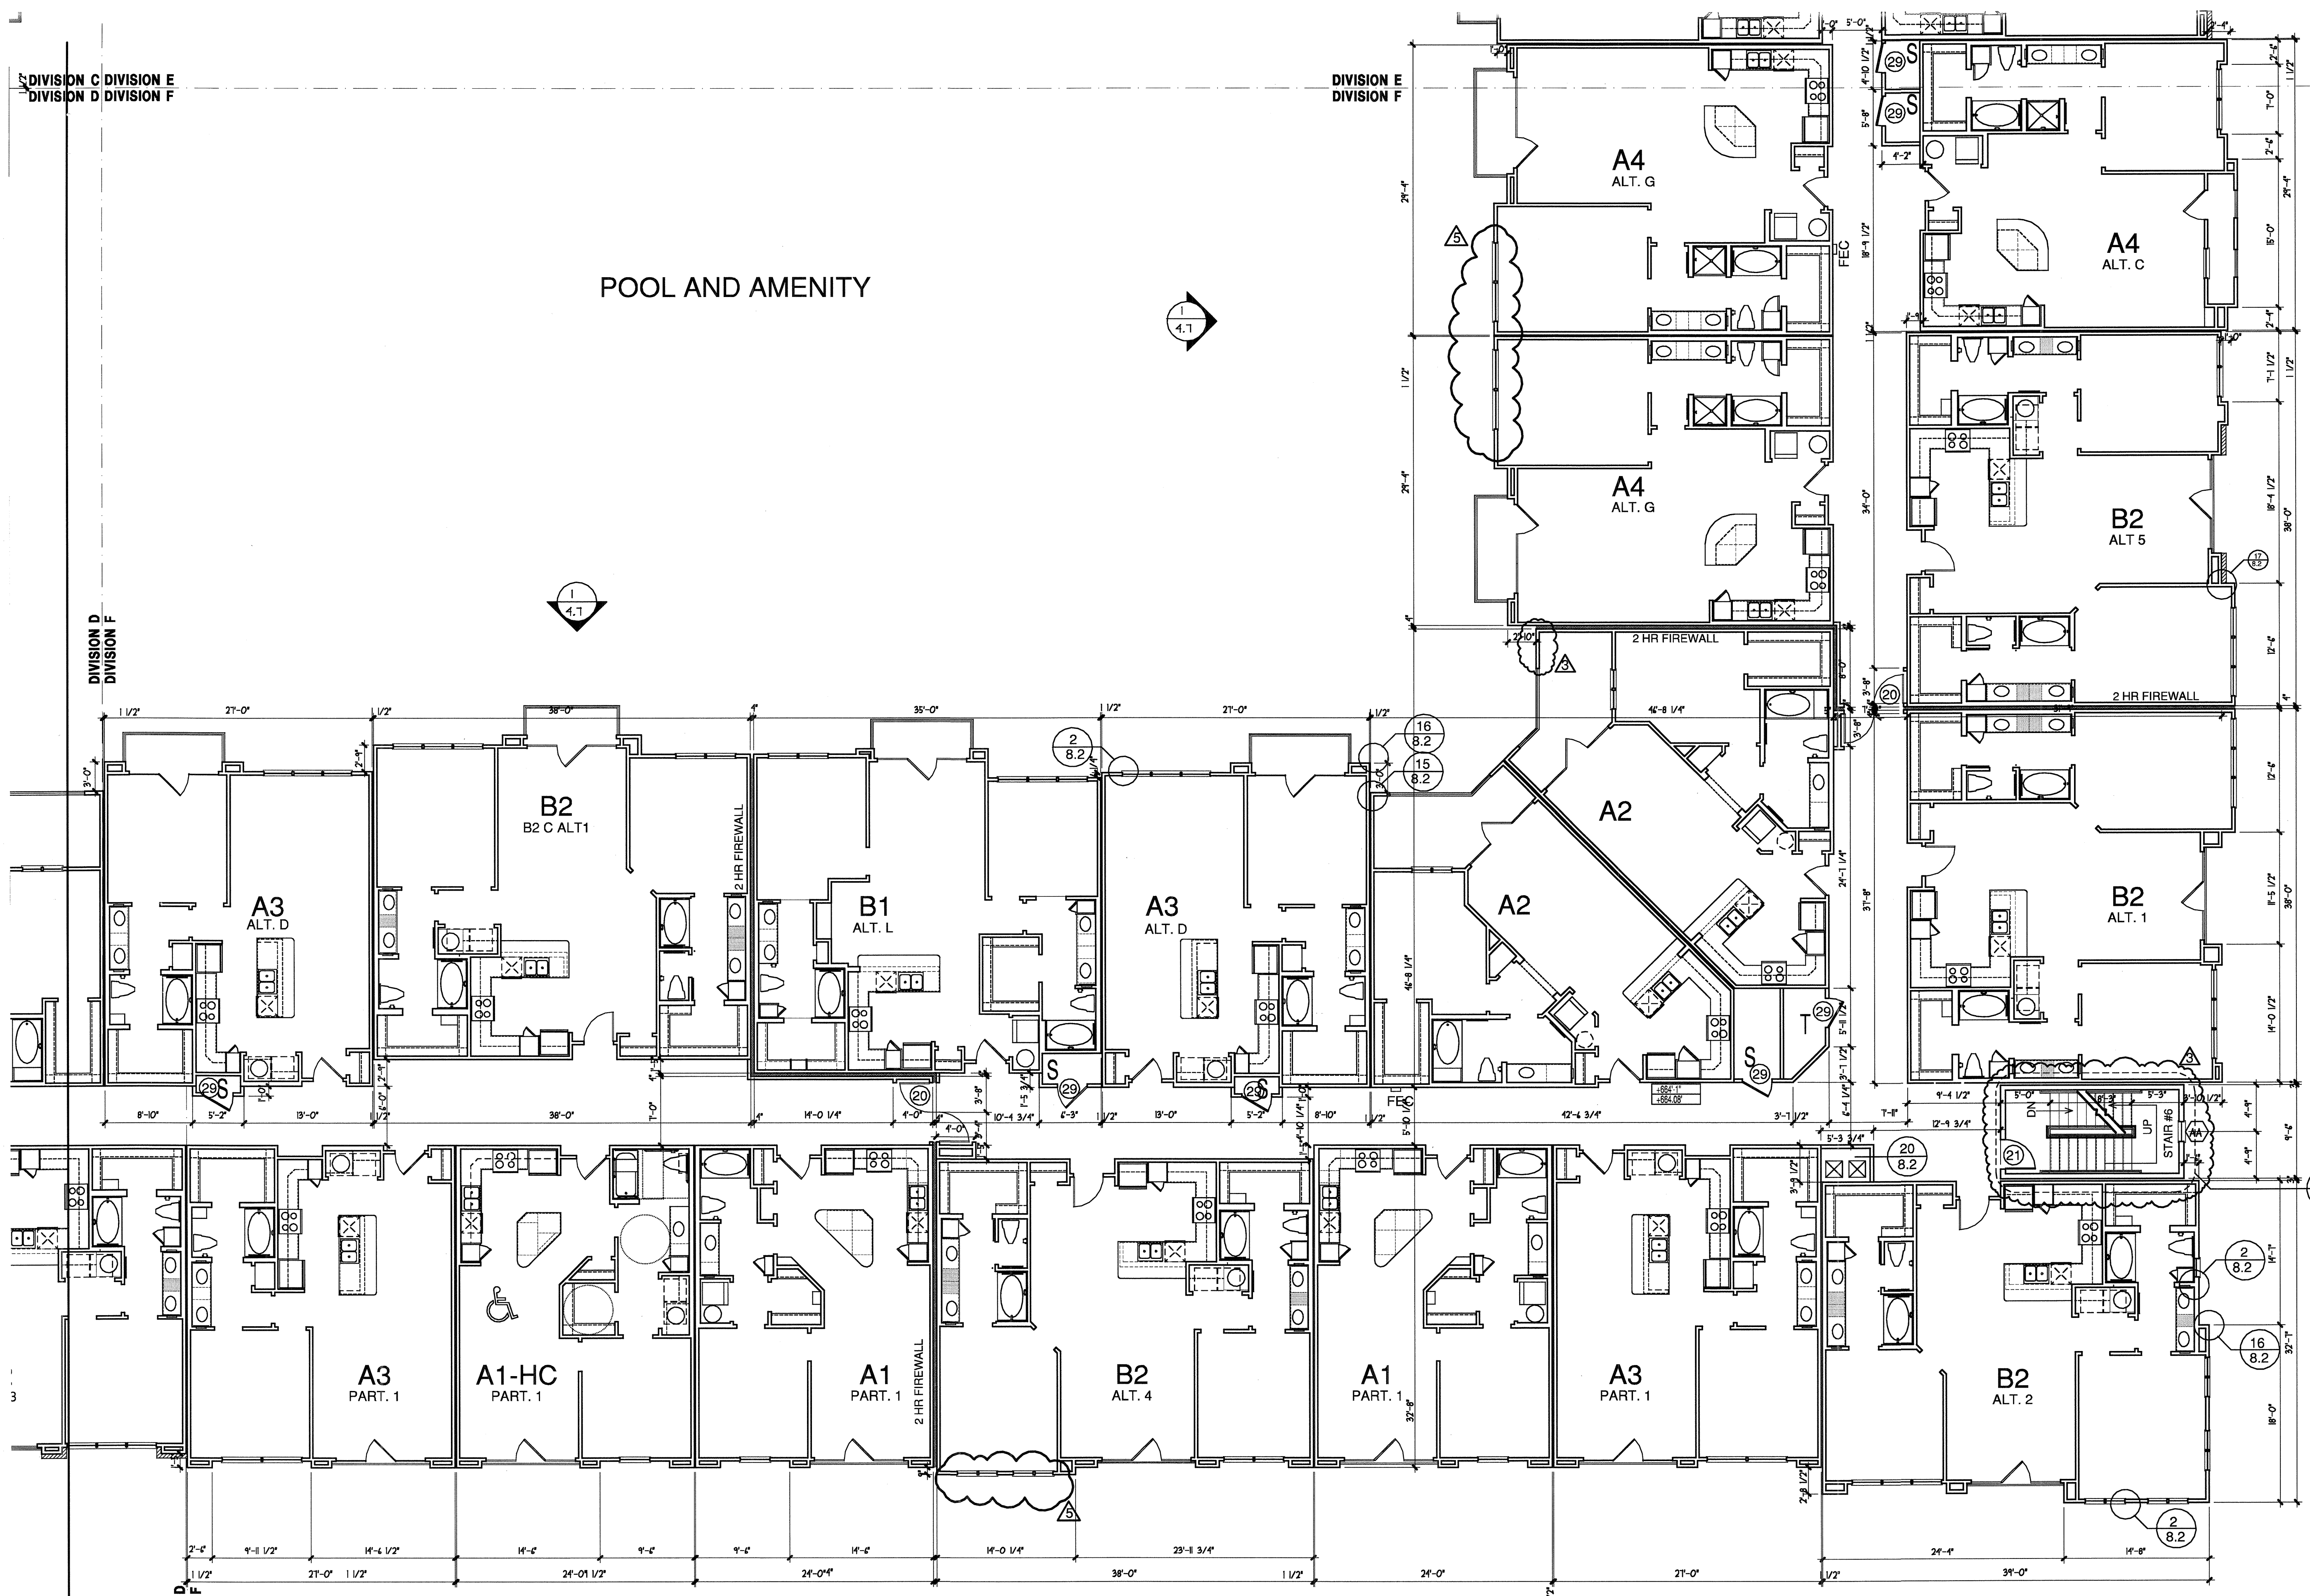


DIVISION D
DIVISION F

DIVISION D
DIVISION F

1 DIVISION 'F' THIRD FLOOR PLAN
1/8"=1'-0"

DIVISION 'F'

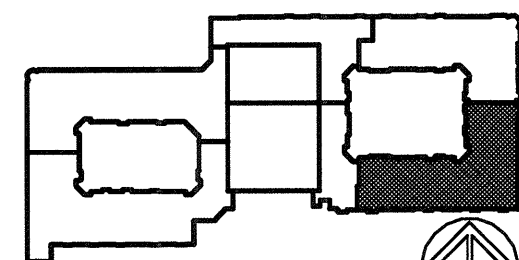

BGO
architects

4144 N. Central Expy.
Suite 855
Dallas, TX 75204
214.520.8878
bgoarchitects.com

CONSTRUCTION ISSUE
10-17-2011

REVISIONS
COORDINATION 10-17-2011
COORDINATION 02-29-2012

KELLER SPRINGS LOFTS

LOFT APARTMENTS IN ADDISON, TEXAS



01-03-2012

COPYRIGHT © Beeler Guest Owens Architects ALL RIGHTS RESERVED

DATE
08-05-2011

PROJECT
11129

SHEET NUMBER
3.3F
BLDG PLAN 'F'