


COPYRIGHT © Baier-Guest Owens Architects ALL RIGHTS RESERVED

DIVISION 'A' FOURTH FLOOR PLAN
1/8"=1'-0"

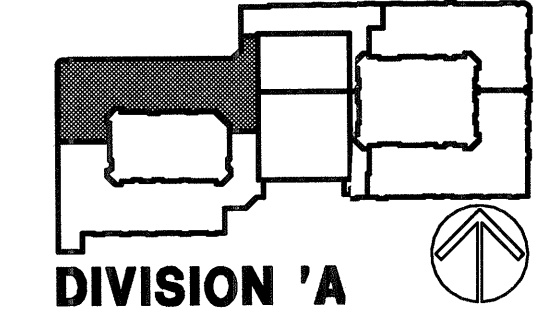

BGO
architects
4144 N. Central Expy.
Suite 855
Dallas, TX 75204
214.520.8878
bgoarchitects.com

CONSTRUCTION ISSUE
10-17-2011

REVISIONS

NO.	DESCRIPTION
1	4.6

KELLER SPRINGS LOFTS
LOFT APARTMENTS IN ADDISON, TEXAS



DATE
08-05-2011
PROJECT
11129

SHEET NUMBER
3.4A
BLDG PLAN 'A'

10-17-2011