


1 DIVISION 'B' FOURTH FLOOR PLAN

DIVISION 'B'

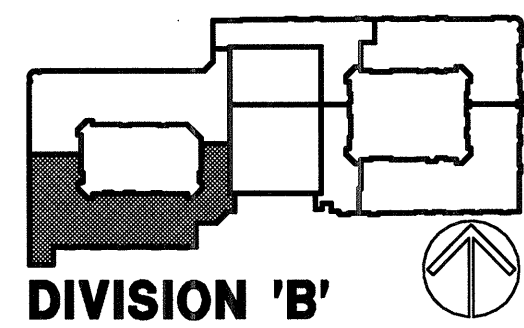

BGO
architects

4144 N. Central Expy.
Suite 855
Dallas, TX 75204
214.520.8878
bgoarchitects.com

CONSTRUCTION ISSUE
10-17-2011

REVISIONS
COORDINATION
10-17-2011

KELLER SPRINGS LOFTS

LOFT APARTMENTS IN ADDISON, TEXAS

REGISTERED ARCHITECT
D. EARL
22433
STATE OF TEXAS

10-17-2011

DATE
08-05-2011

PROJECT
11129

SHEET NUMBER
3.4B
BLDG PLAN 'B'