

81 SPACES  
THIS LEVEL

PARKING GARAGE


RAMP DN 6.5%

POC

+674'-9 7/8"  
+674.82'

COPYRIGHT © Beeler Guest Owens Architects ALL RIGHTS RESERVED

**1** DIVISION 'D' FOURTH FLOOR PLAN  
1/8"=1'-0"

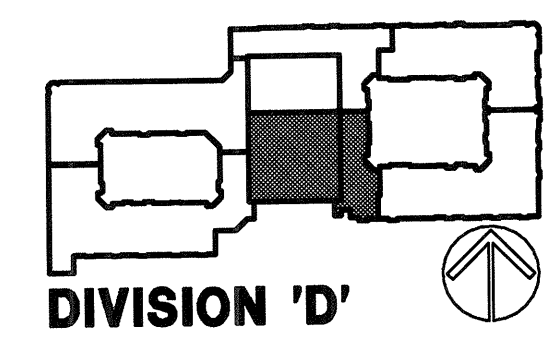

**BGO**  
architects  
4144 N. Central Expy.  
Suite B55  
Dallas, TX 75204  
214.520.8878  
bgoarchitects.com

CONSTRUCTION I/E  
10-17-2011

REVISIONS

COORDINATION	10-17-2011
GARAGE REVISIONS PER SHOP DWGS	01-03-2012

**KELLER SPRINGS LOFTS**  
LOFT APARTMENTS IN ADDISON, TEXAS

01-03-2012

DATE  
08-05-2011  
PROJECT  
11129

SHEET NUMBER  
**3.4D**  
BLDG PLAN 'D'