


81 SPACES
THIS LEVEL

PARKING GARAGE

RAMP DN 6.5%

+674'-9 7/8"
+674.82'

1 DIVISION 'D' FOURTH FLOOR PLAN
1/8"=1'-0"

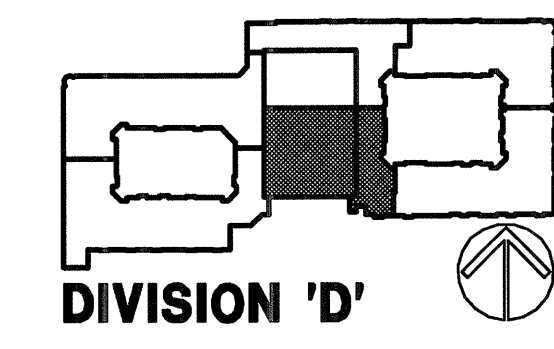

BGO
architects
4144 N. Central Expy.
Suite 855
Dallas, TX 75204
214.520.8878
bgoarchitects.com

CONSTRUCTION ISSUE
10-17-2011

REVISIONS

1	COORDINATION	10-17-2011
---	--------------	------------

KELLER SPRINGS LOFTS
LOFT APARTMENTS IN ADDISON, TEXAS



COPYRIGHT © Beeler Guest Owens Architects ALL RIGHTS RESERVED
DATE
08-05-2011
PROJECT
11129

SHEET NUMBER
3.4D
BLDG PLAN 'D'