


**1** DIVISION 'D' FOURTH FLOOR PLAN  
1/8" = 1'-0"

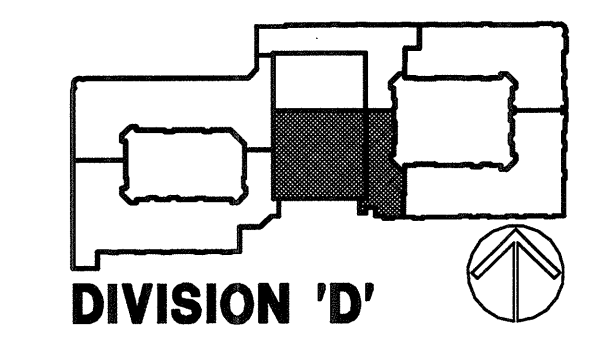

**BGO**  
architects  
4144 N. Central Expy.  
Suite 855  
Dallas, TX 75204  
214.520.8878  
bgoarchitects.com

CONSTRUCTION ISSUE  
10-17-2011

REVISIONS

- COORDINATION 10-17-2011
- GARAGE REVISIONS PER SHOP DWGS 01-03-2012
- COORDINATION 02-29-2012

**KELLER SPRINGS LOFTS**  
LOFT APARTMENTS IN ADDISON, TEXAS

REGISTERED ARCHITECT  
O. EARNHART  
22433  
STATE OF TEXAS  
01-03-2012

COPYRIGHT © Beeler Guest Owens Architects ALL RIGHTS RESERVED  
DATE 08-05-2011  
PROJECT 11129

SHEET NUMBER **3.4D**  
BLDG PLAN 'D'