


**1** DIVISION 'F' FOURTH FLOOR PLAN  
1/8"=1'-0"

DIVISION 'F'

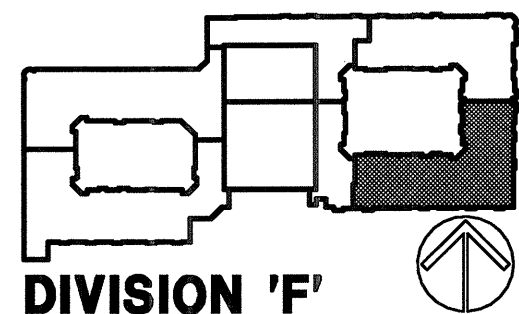

**BGO**  
architects  
4144 N. Central Expy.  
Suite 955  
Dallas, TX 75204  
214.520.8878  
bgoarchitects.com

CONSTRUCTION ISSUE  
10-17-2011

REVISIONS  
COORDINATION  
10-17-2011

**KELLER SPRINGS LOFTS**

LOFT APARTMENTS IN ADDISON, TEXAS



10-17-2011

DATE  
08-05-2011

PROJECT  
11129

SHEET NUMBER

**3.4F**

BLDG PLAN 'F'

COPYRIGHT © Beeler Guest Owens Architects ALL RIGHTS RESERVED