
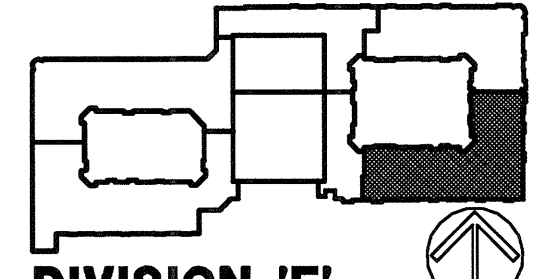
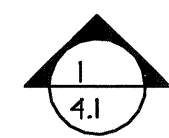
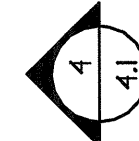
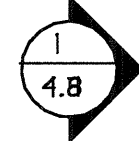


DIVISION C DIVISION E
DIVISION D DIVISION F

DIVISION E
DIVISION F

DIVISION E
DIVISION F

POOL AND AMENITY

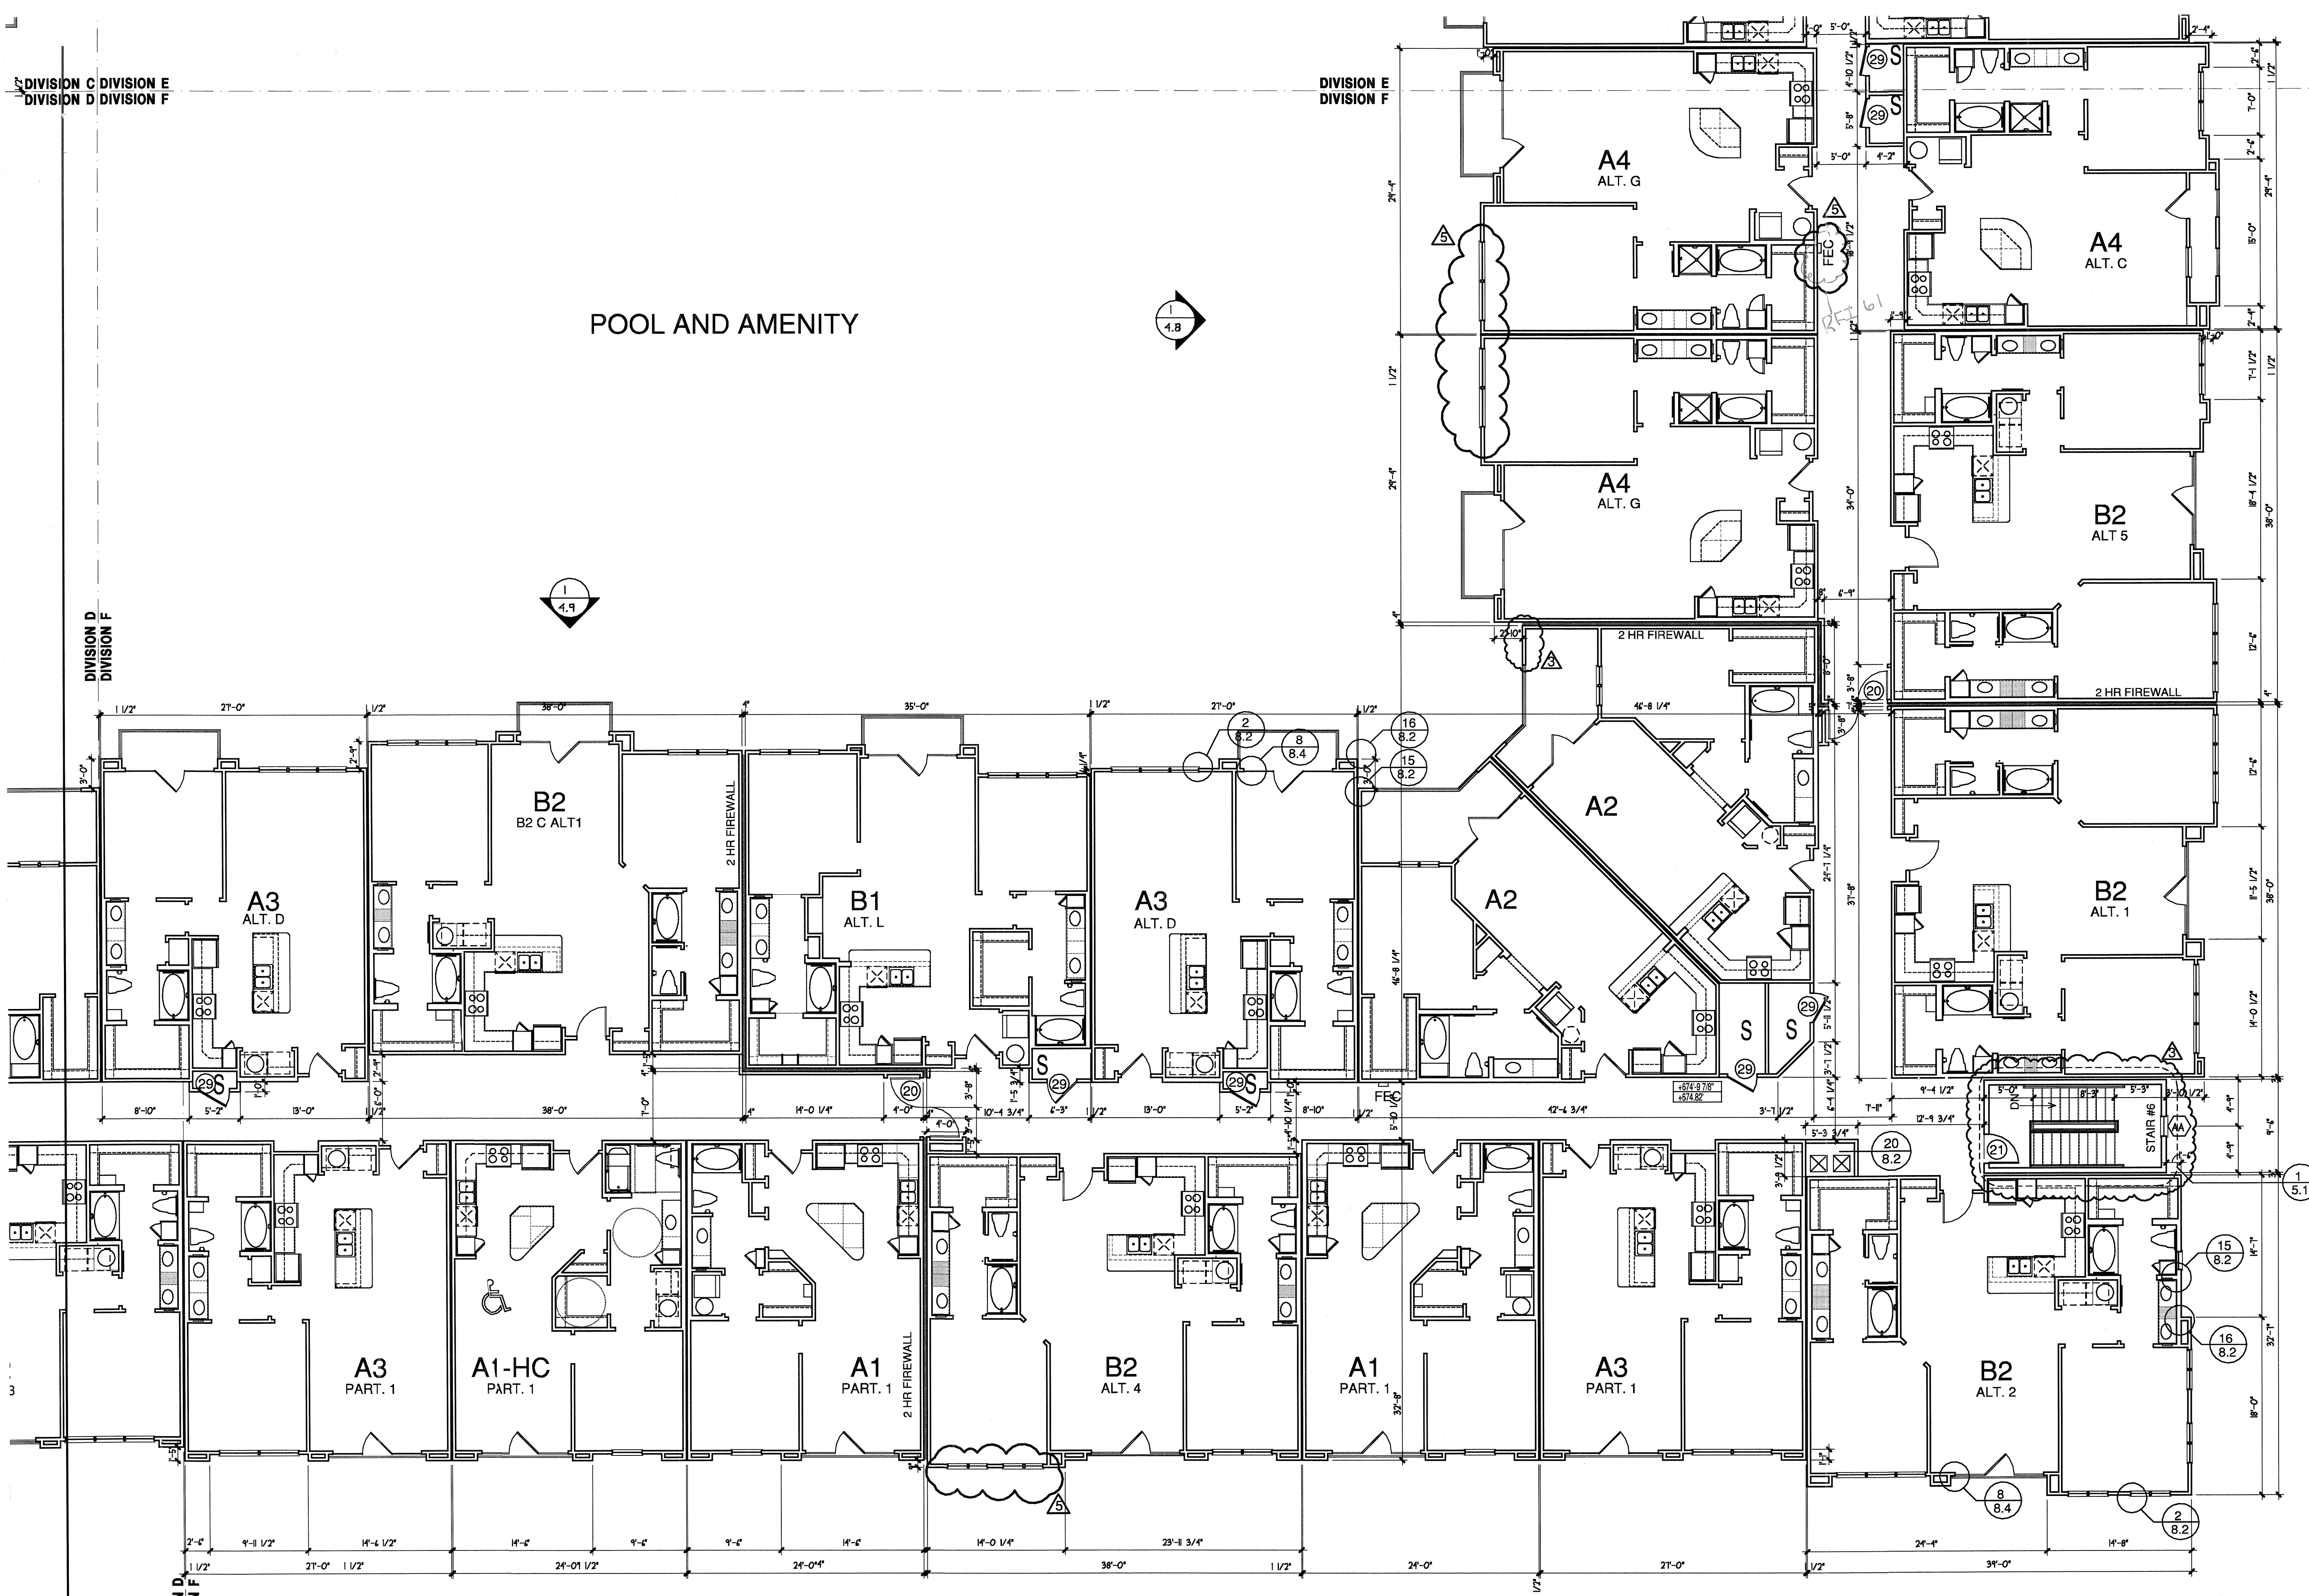

1 DIVISION 'F' FOURTH FLOOR PLAN
1/8"=1'-0"

DIVISION 'F'

BGO
architects
4144 N. Central Expy.
Suite 855
Dallas, TX 75204
214.520.8878
bgoarchitects.com

CONSTRUCTION ISSUE
10-17-2011

| REVISIONS | COORDINATION |
|------------|--------------|
| 10-17-2011 | |
| 02-29-2012 | |

KELLER SPRINGS LOFTS
LOFT APARTMENTS IN ADDISON, TEXAS

REGISTERED ARCHITECT
K. O. EARNEST
22433
OF TEXAS
01-03-2012

| | |
|---------|------------|
| DATE | 08-05-2011 |
| PROJECT | 11129 |

| | |
|---------------|-------------|
| SHEET NUMBER | 3.4F |
| BLDG PLAN 'F' | |

COPYRIGHT © Beeler Guest Owens Architects ALL RIGHTS RESERVED