
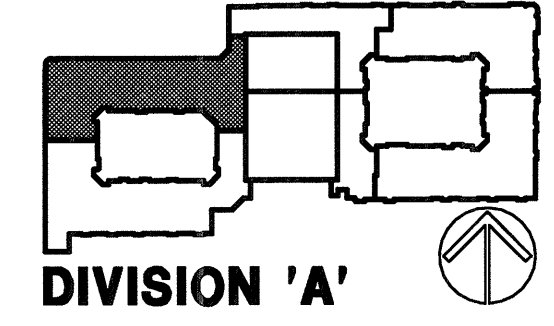


**ROOF LEGEND:**

- INDICATES AREA NOT TO HAVE ROOF PENETRATIONS
- LOW INTAKE ATTIC VENT
- EXHAUST ATTIC VENT
- DRAFT STOP

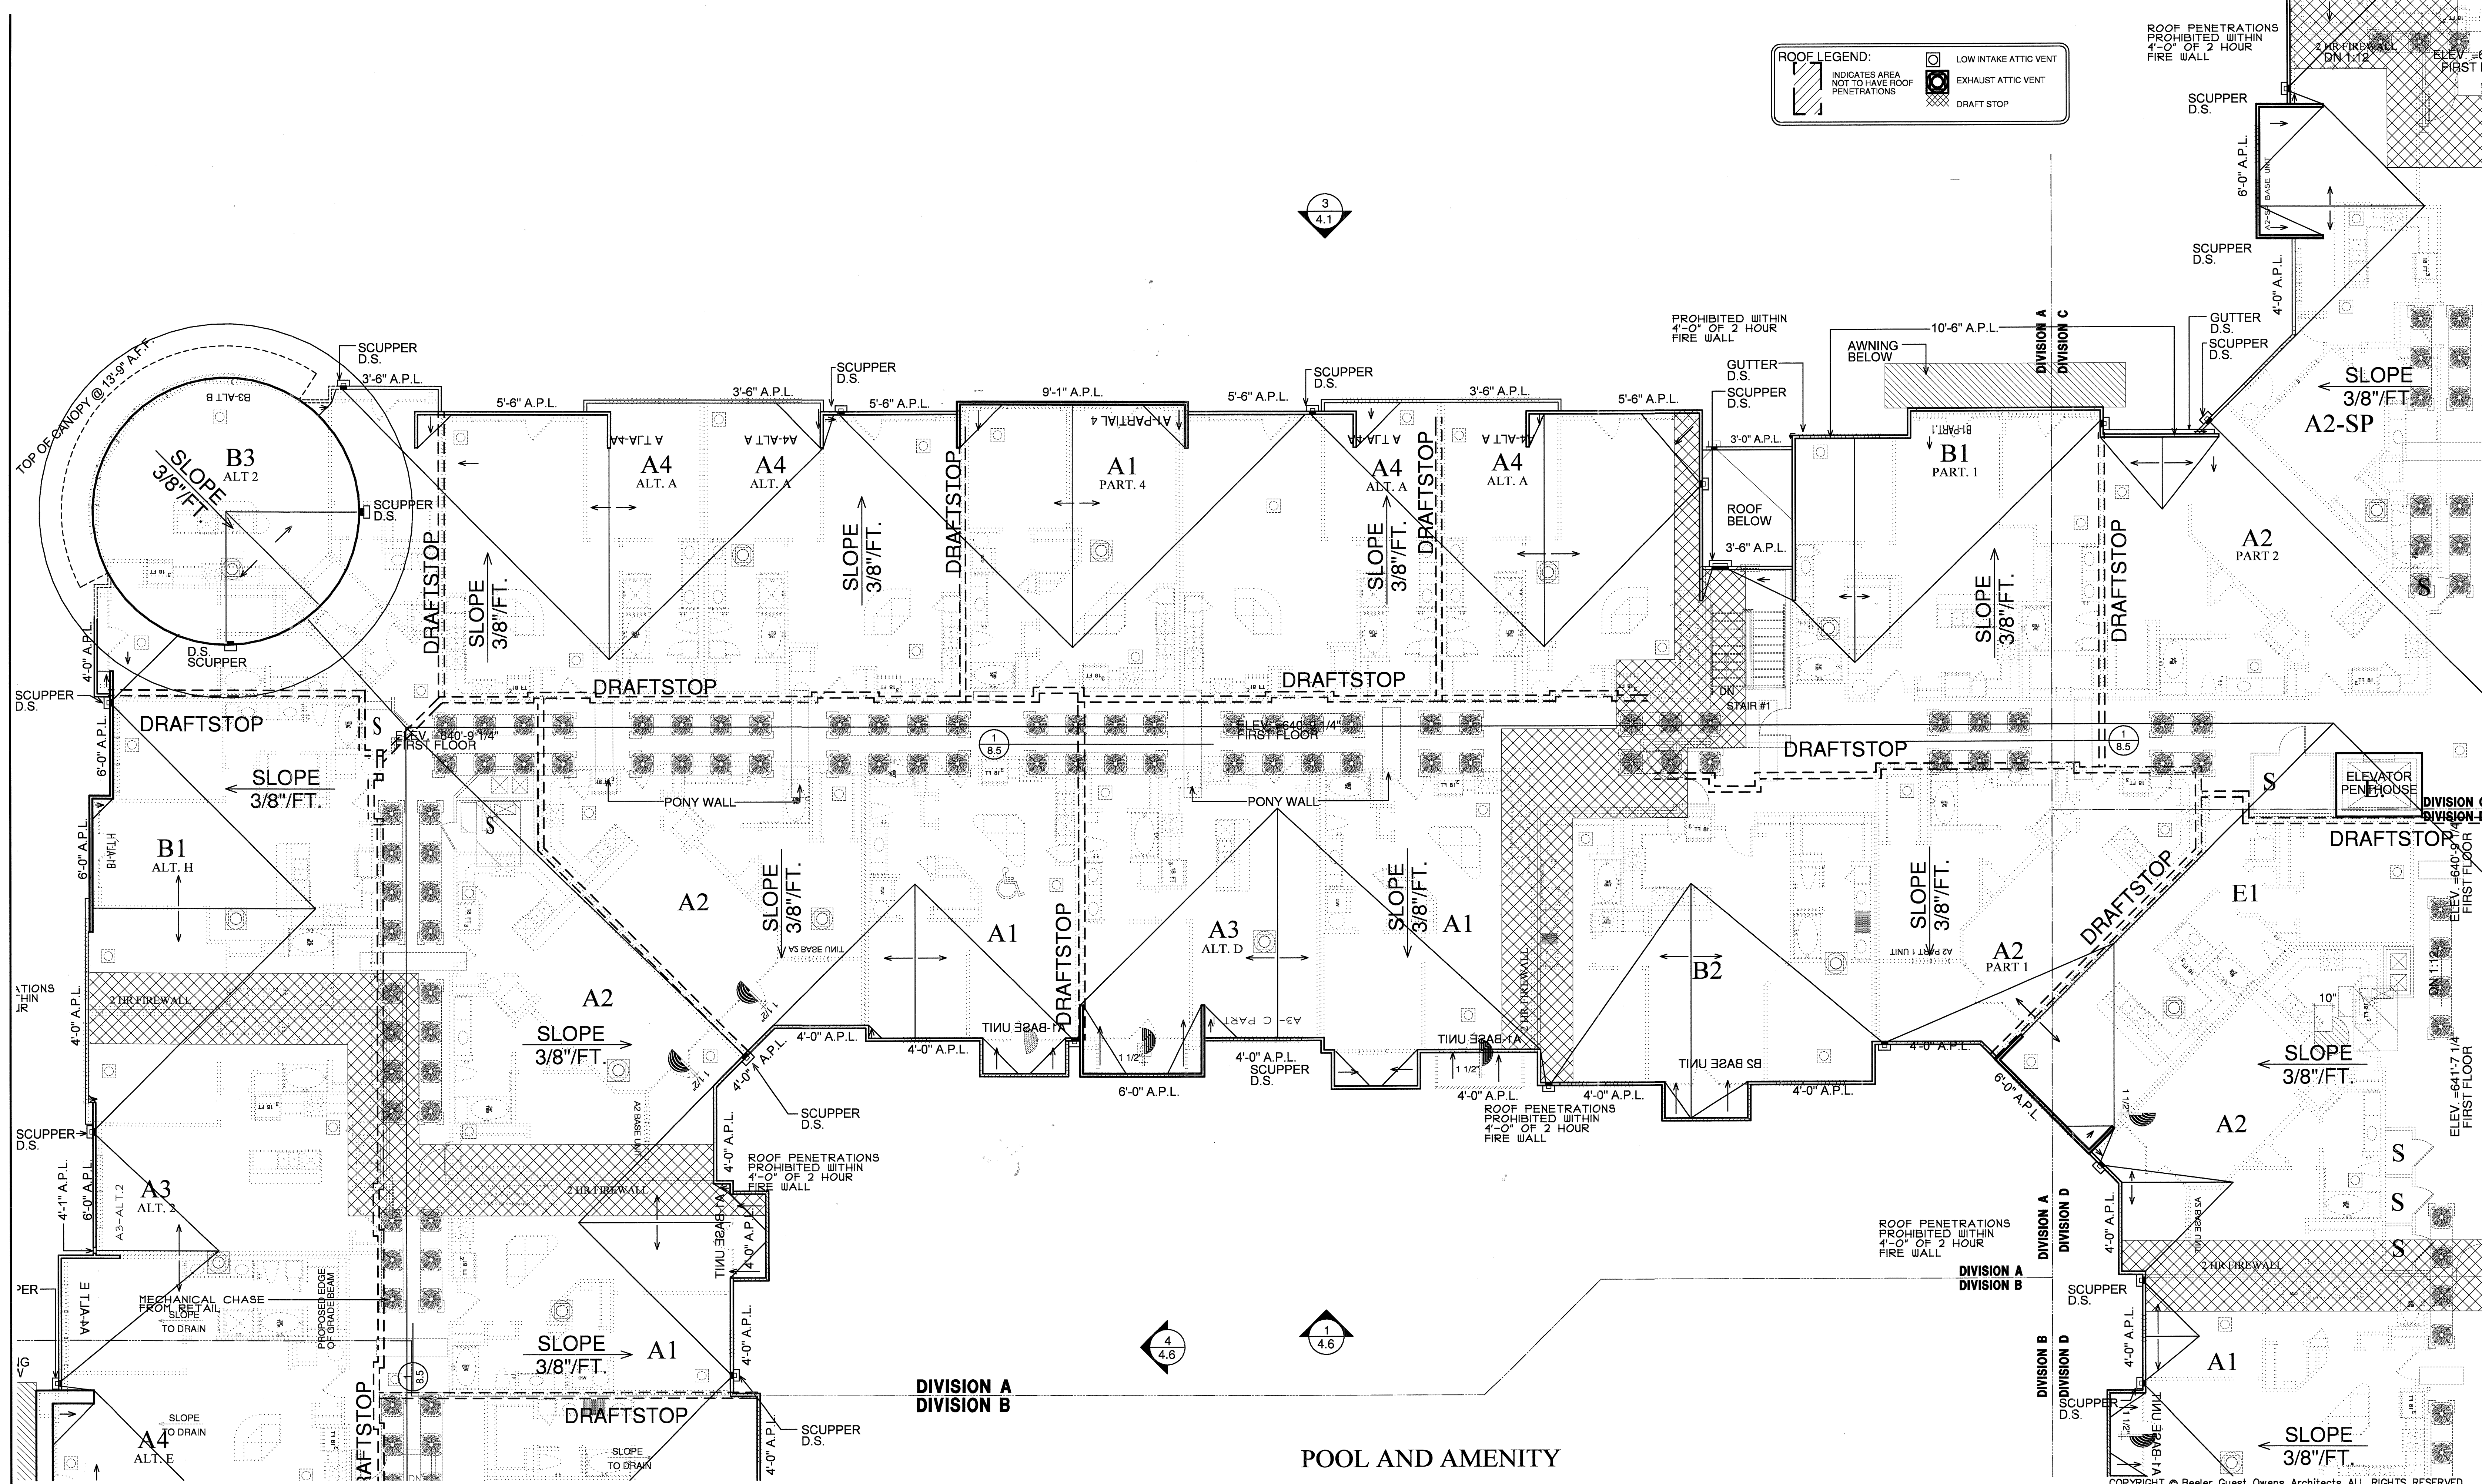

**BGO architects**  
 4144 N. Central Expy. Suite 855  
 Dallas, TX 75204  
 214.520.8878  
 bgoarchitects.com

CONSTRUCTION ISSUE  
 10-17-2011

REVISIONS

NO.	DESCRIPTION

**KELLER SPRINGS LOFTS**  
 LOFT APARTMENTS IN ADDISON, TEXAS

REGISTERED ARCHITECT  
 STATE OF TEXAS  
 22433  
 10-17-2011

DATE  
 08-05-2011  
 PROJECT  
 11129

SHEET NUMBER  
**3.5A**  
 BLDG PLAN 'A'

**1 DIVISION 'A' ROOF PLAN**  
 1/8"=1'-0"

COPYRIGHT © Beeler Guest Owens Architects ALL RIGHTS RESERVED