


83 SPACES
THIS LEVEL

NOTE: ROOF TRUSS LAYOUT, PROFILES AND DESIGN ARE TO BE PROVIDED BY THE TRUSS MANUFACTURER BY WAY OF SHOP DRAWINGS, AND ARE TO BE SIGNED AND SEALED BY A REGISTERED ENGINEER. SEE LEGEND SHEET FOR BALANCE OF TRUSS NOTES.

DOWNSPOUT LOCATIONS ARE CONCEPTUAL IN NATURE AND MUST BE COORDINATED BY THE CONTRACTOR ON SITE WITH THE LANDSCAPING, RETAINING WALLS, SIDEWALKS AND INDIVIDUAL BUILDING ORIENTATION AND DRAINAGE TO INSURE THAT OUTFLOW FROM DOWNSPOUTS IS THE INTENT OF THE ARCHITECT. DOWNSPOUTS ARE TO BE CARRIED AWAY FROM PALE BUILDING AND OTHER FINISHED SURFACES WHERE POSSIBLE.

DOWN SPOUTS IN COURTYARD ARE TO BE HARD PIPED INTO THE STORY DRAIN - REFER TO LANDSCAPE PLANS FOR LOCATIONS

1 DIVISION 'D' ROOF PLAN
1/8"=1'-0"

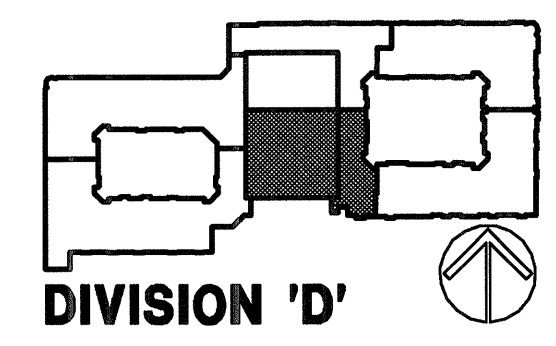

BGO
architects

4144 N. Central Expy.
Suite 855
Dallas, TX 75204
214.520.8878
bgoarchitects.com

CONSTRUCTION ISSUE
10-17-2011

REVISIONS

NO.	DESCRIPTION

KELLER SPRINGS LOFTS

LOFT APARTMENTS IN ADDISON, TEXAS

REGISTERED ARCHITECT
STATE OF TEXAS
22433

DATE
08-05-2011

PROJECT
11129

SHEET NUMBER
3.5D

BLDG PLAN 'D'

COPYRIGHT © Beeler Guest Owens Architects ALL RIGHTS RESERVED