


1 DIVISION 'F' ROOF PLAN
1/8"=1'-0"

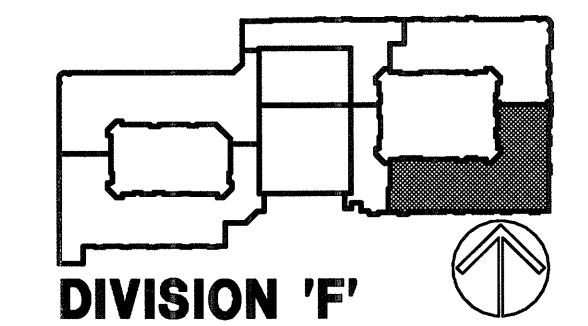

BGO architects
4144 N. Central Exp.
Suite 855
Dallas, TX 75204
214.520.8878
bgoarchitects.com

CONSTRUCTION ISSUE
10-17-2011

REVISIONS

NO.	DESCRIPTION

KELLER SPRINGS LOFTS
LOFT APARTMENTS IN ADDISON, TEXAS

REGISTERED ARCHITECT
STATE OF TEXAS
22433
10-17-2011

DATE
08-05-2011
PROJECT
11129

SHEET NUMBER
3.5F
BLDG PLAN 'F'

COPYRIGHT © Beeler Guest Owens Architects ALL RIGHTS RESERVED