


**1 DIVISION 'D' ROOF PLAN**  
1/8"=1'-0"

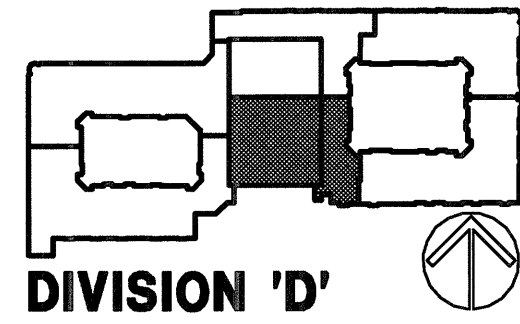

**BGO architects**  
4144 N. Central Exp., Suite 855  
Dallas, TX 75204  
214.520.8878  
bgoarchitects.com

CONSTRUCTION ISSUE  
10-17-2011

REVISIONS

NO.	DESCRIPTION

**KELLER SPRINGS LOFTS**  
LOFT APARTMENTS IN ADDISON, TEXAS



DATE  
08-05-2011  
PROJECT  
11129

SHEET NUMBER  
**3.6D**  
BLDG PLAN 'D'

COPYRIGHT © Beeler Guest Owens Architects ALL RIGHTS RESERVED